


Letter 8. 12. 79

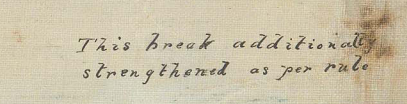

H. MURRAY & CO.
Shipbuilders,
PORT-GLASGOW.