


S. S. "Albano" (late S. S. "Albion") Report No. 4916.

Sketch of Alterations & Additions


- Scale $\frac{1}{4}$ " = one foot -

 

S.S. "Albano"

late S.S. "Albion"

Steel Report No 4916.

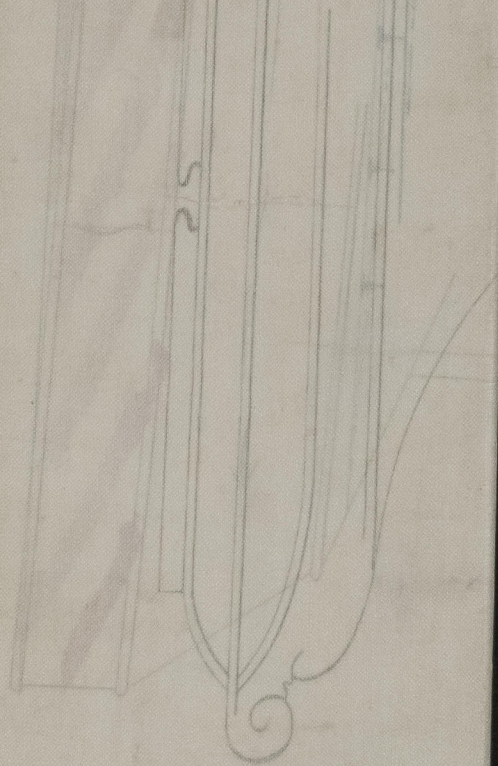

1R0N543-0098



© 2021

Lloyd's Register
Foundation