

19/12/99

Longitudinal Section of 194 S.S.

100 H.I. Class.


Scale 1/4 inch = one ft.

S.S. "Jasper" Glasgow Report No. 5755

1/2 B 11.5
1/2 C 20.7
D 11.7

$43.9 \times 143.9 = 6317$ Seaming ft.

incl 7 breadth
13 depth

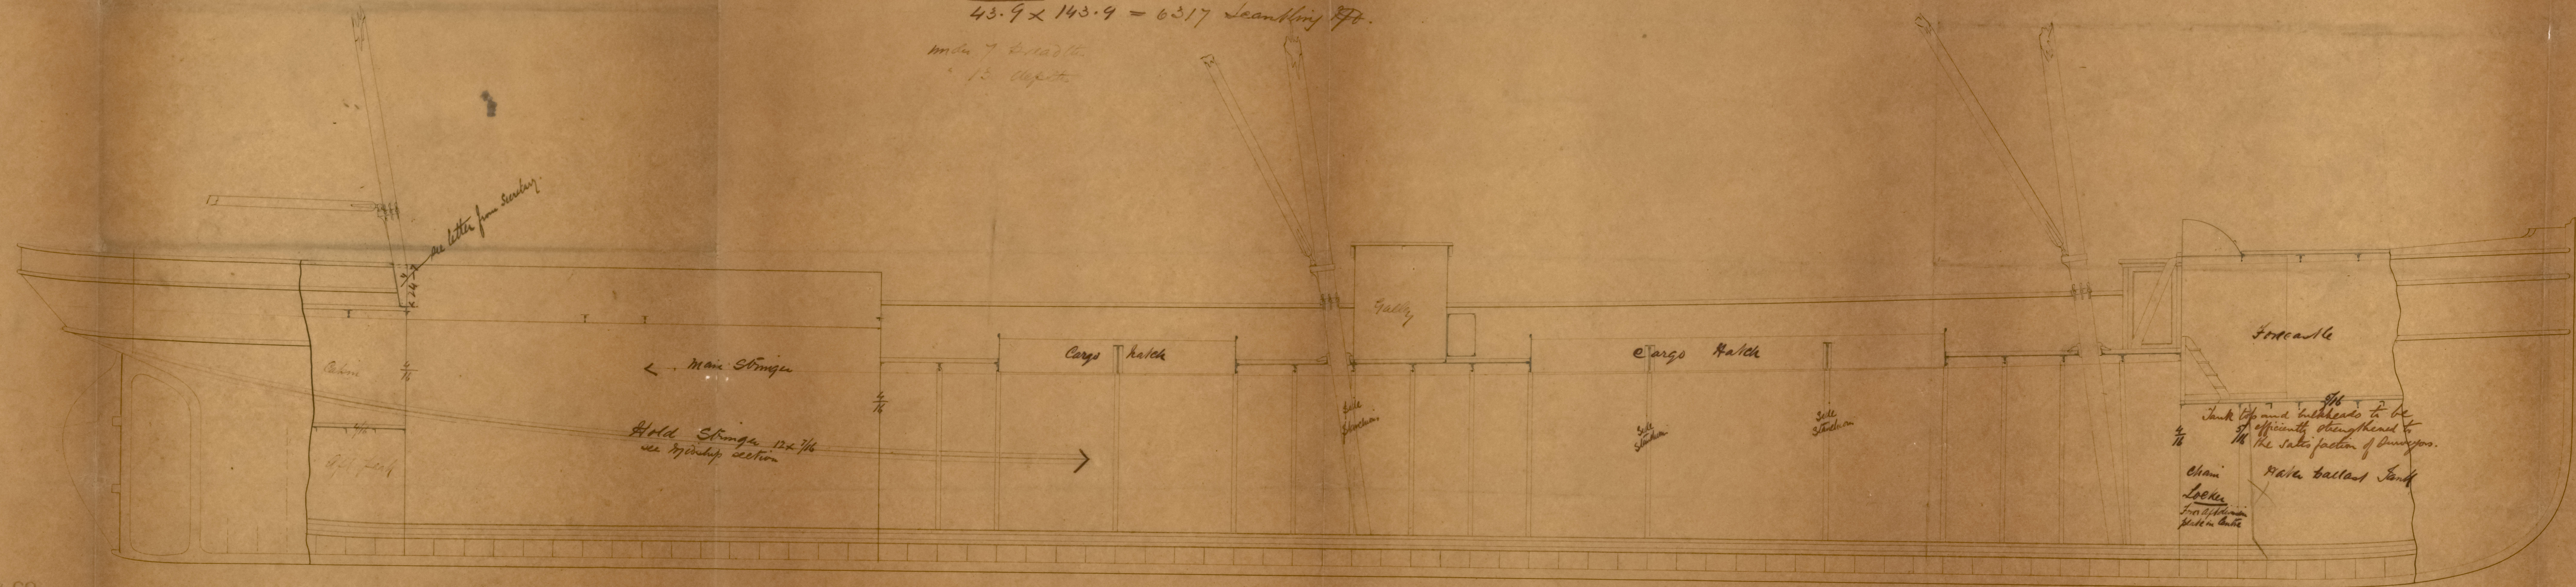

see letter from Secretary

Main Stringer

Cargo Hatch

Cargo Hatch

Forecabin

Tank top and bulkheads to be of efficient strength to the satisfaction of Surveyors.

Chain Locker for 15 ft. in length

T. B. SEATH & CO.,
Shipbuilders,
RUTHERGLEN.

180m
19/12/99

120544-0029