

Letter to W Shields  
3 Nov. 1879



BOILER *Shipp* 396 397 398  
CONTRACT NOS 86. 87. 88

WORKING PRESSURE 90 lbs per sq. INCH  
TEST - do - 180 do do do



Two off this Oct-24<sup>th</sup> 1849

**WALLSEND  
SLIPWAY AND ENGINEERING  
LIMITED  
NEWCASTLE ON TYNE**

## Shell Rotting

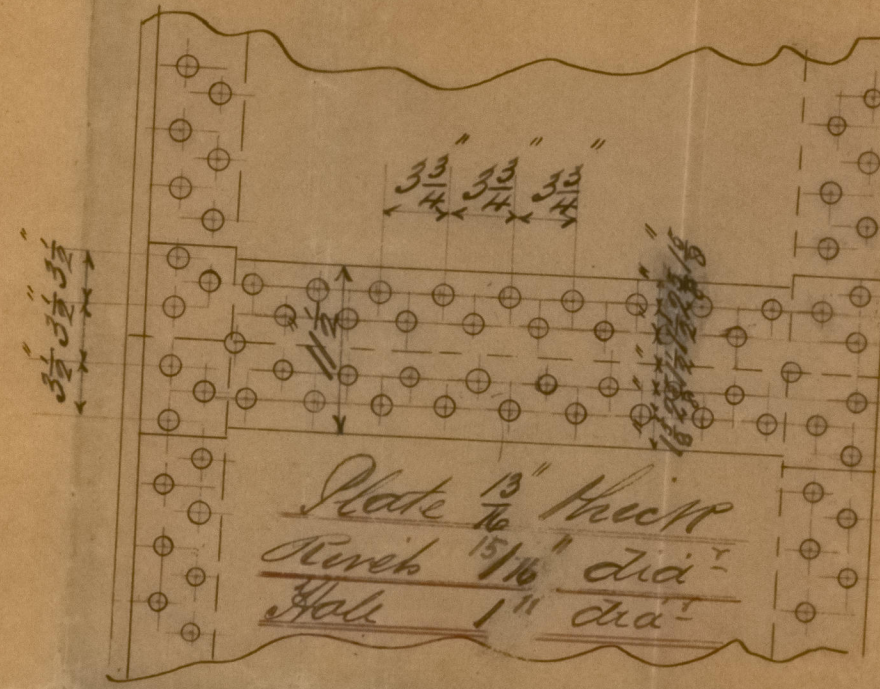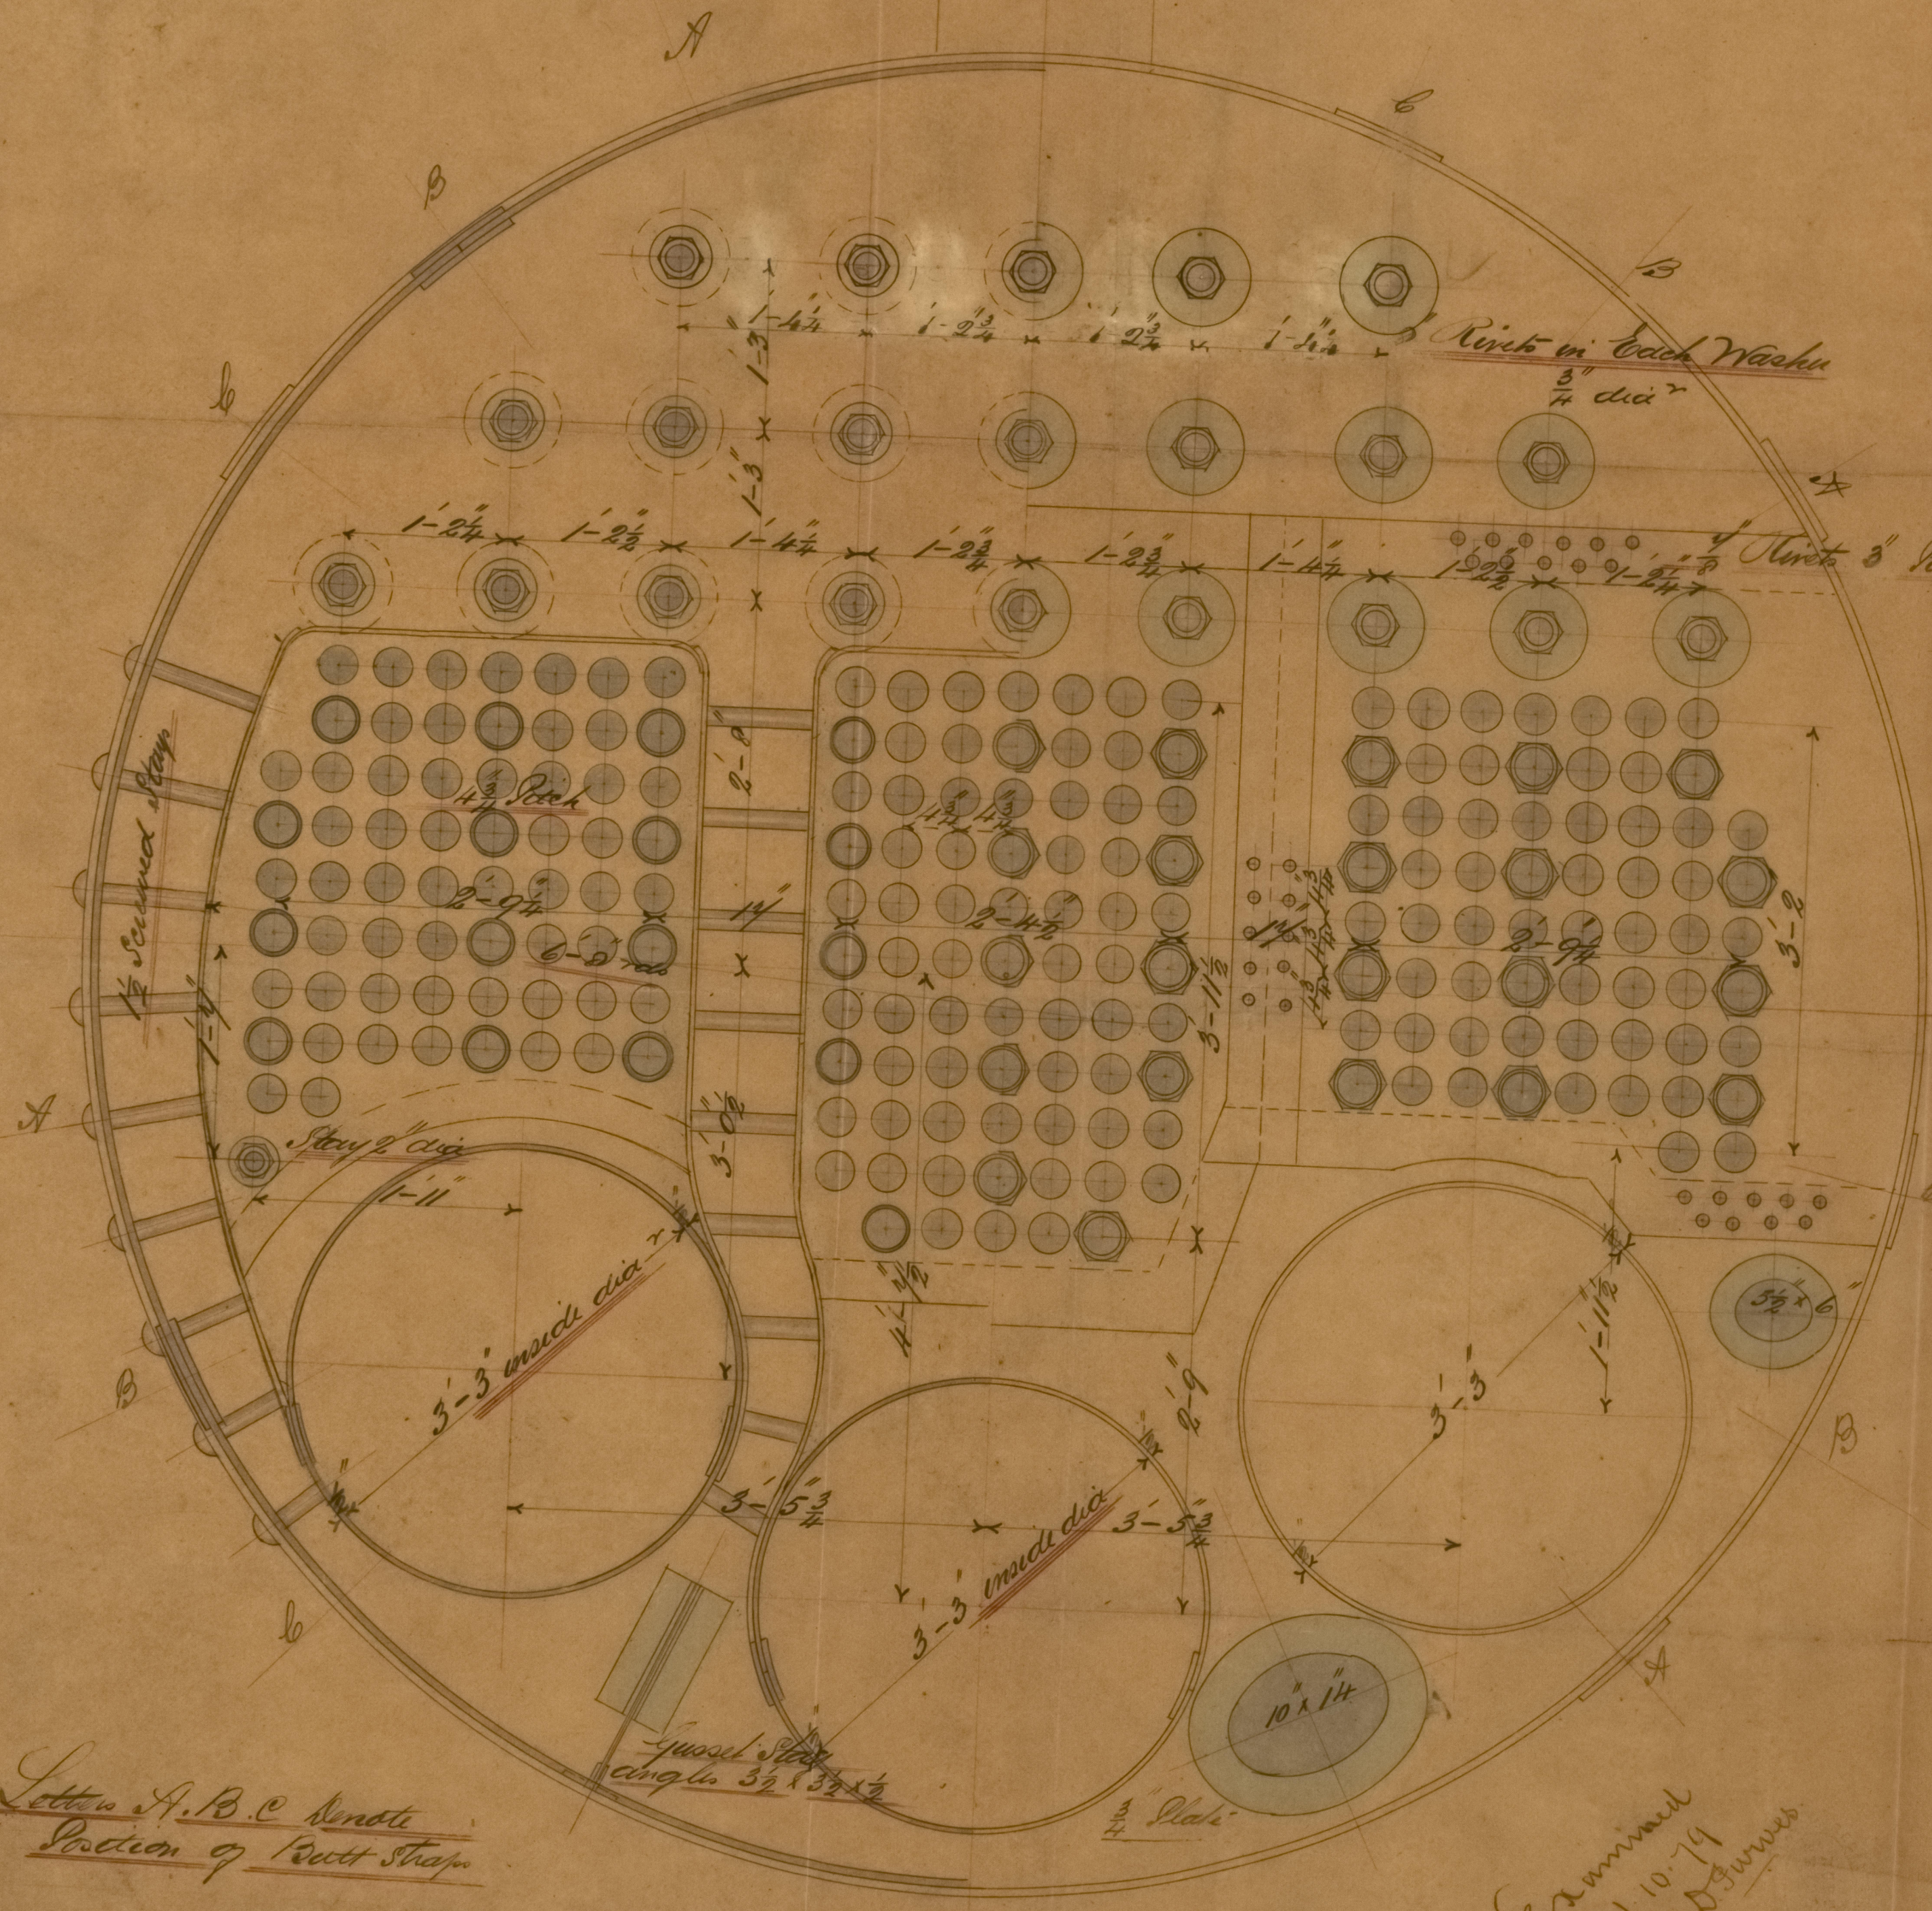[illegible]

Examined  
31.10.79  
D. Surver

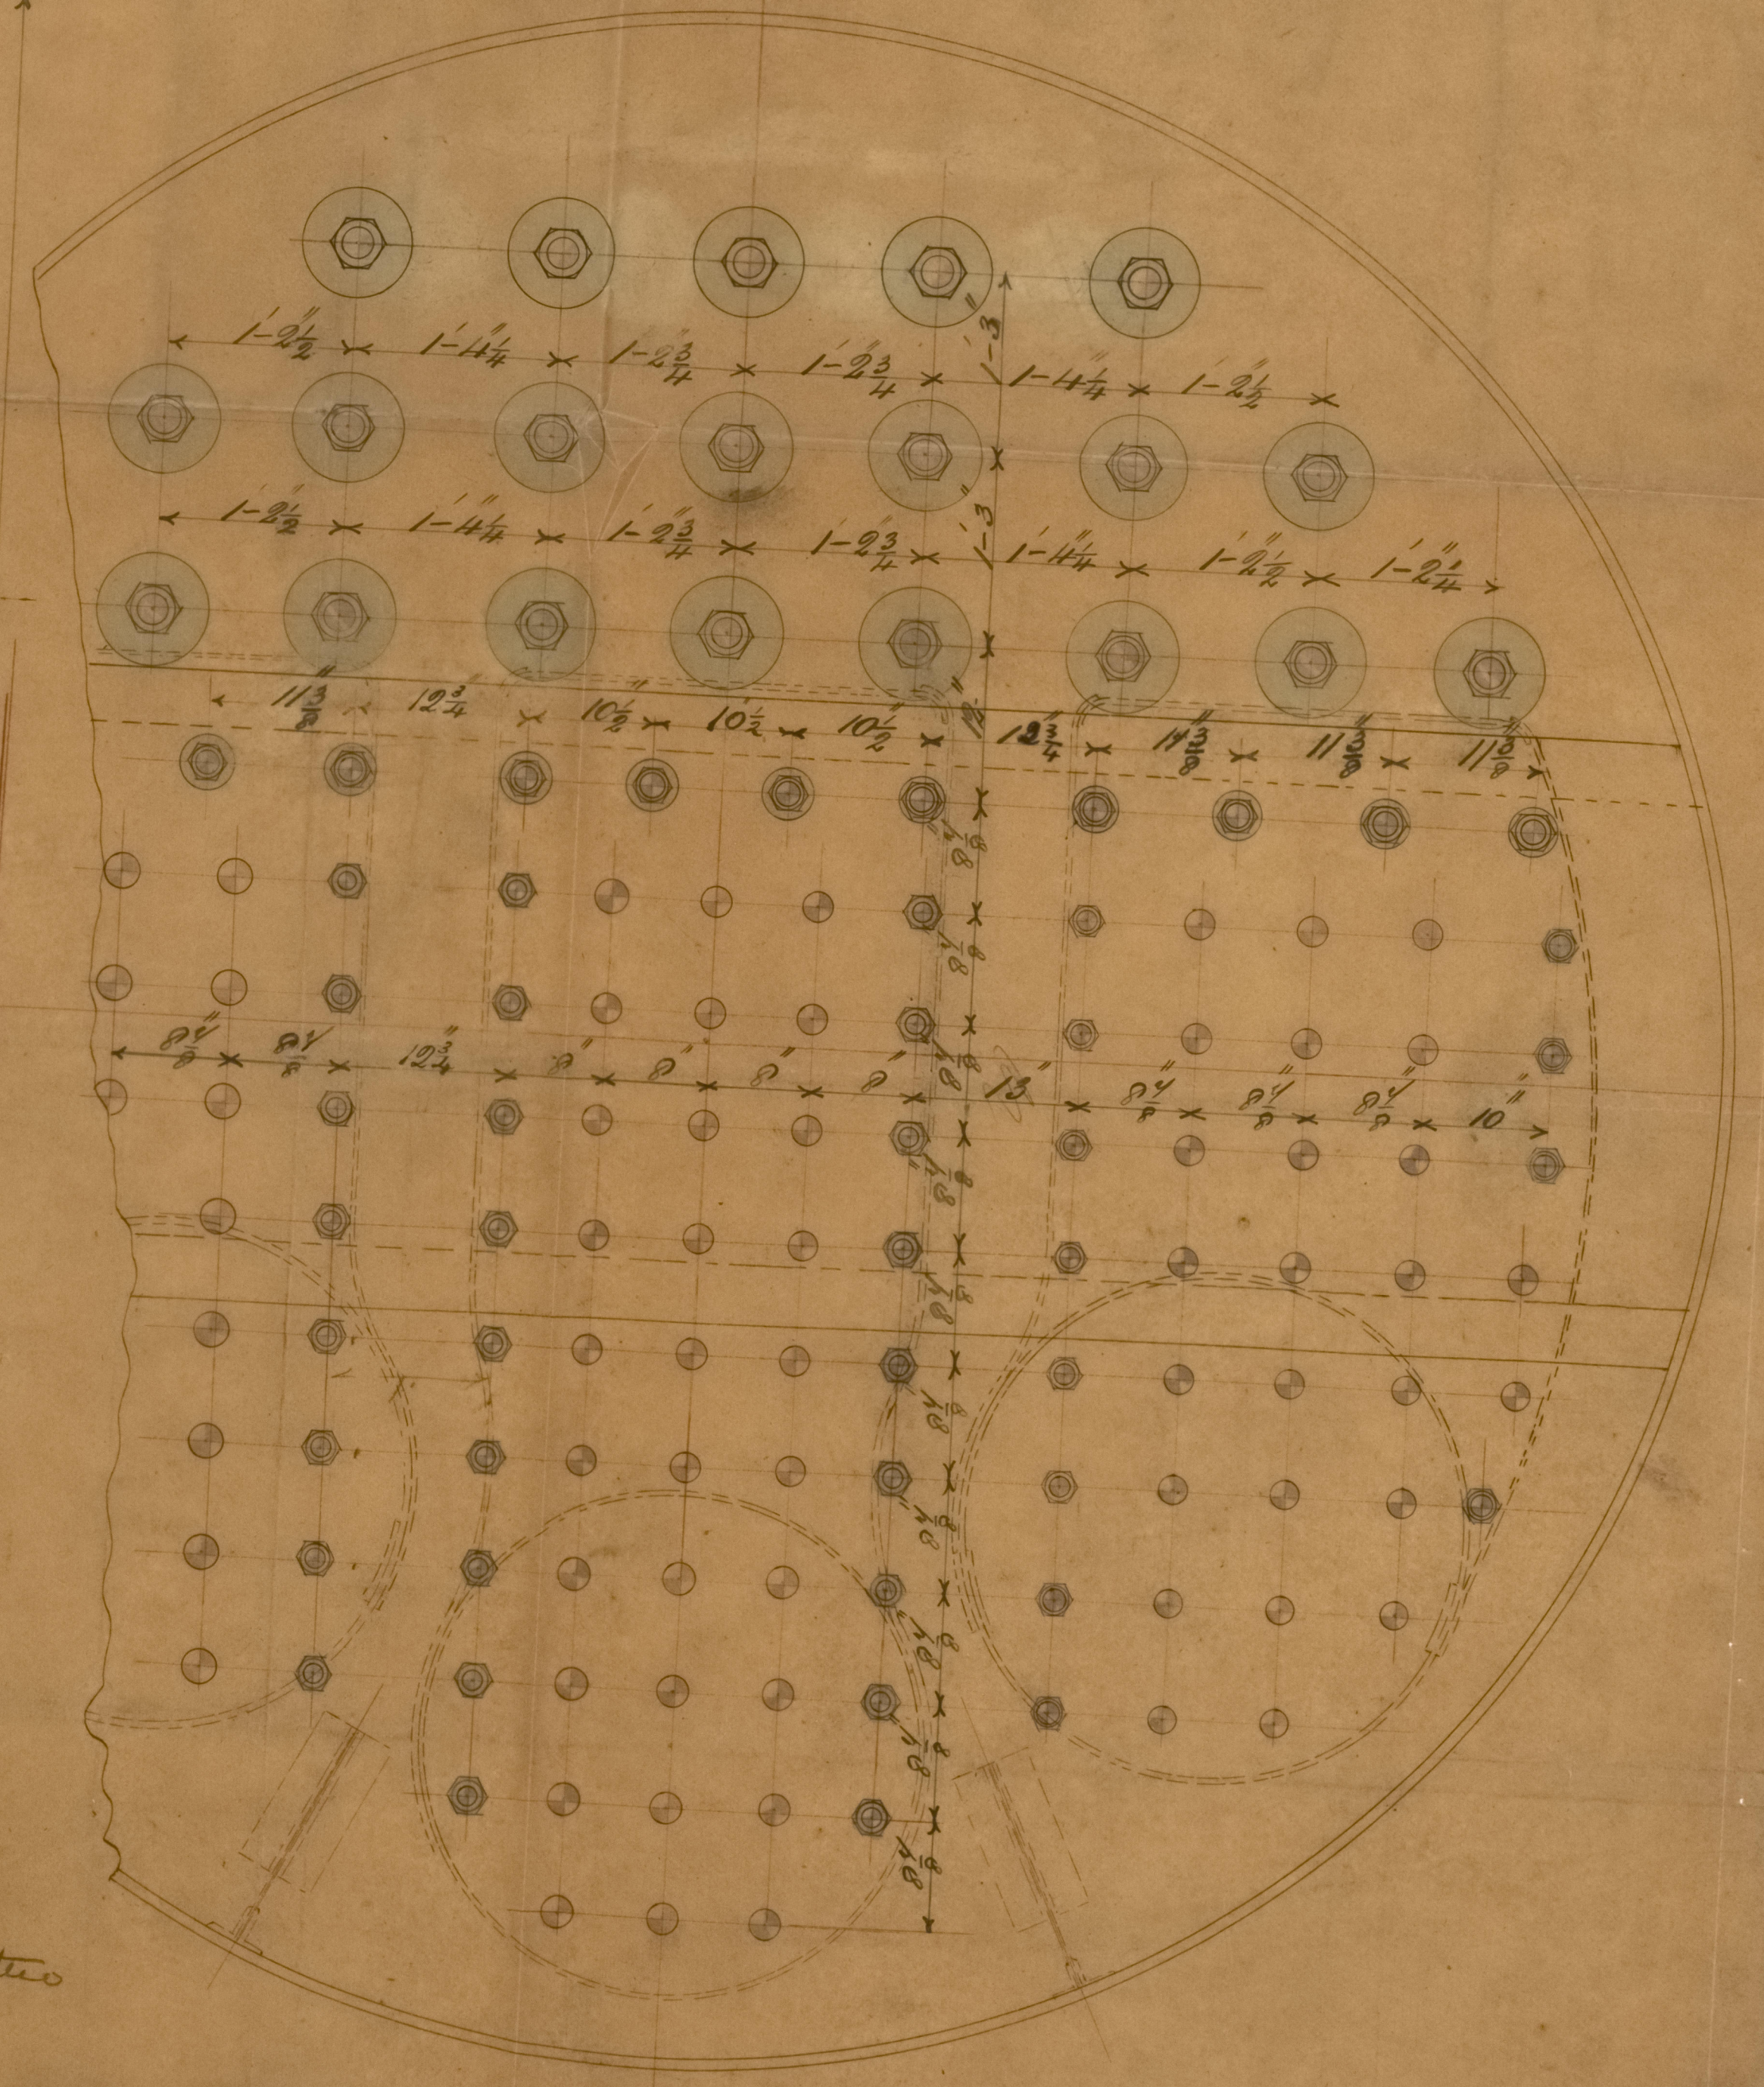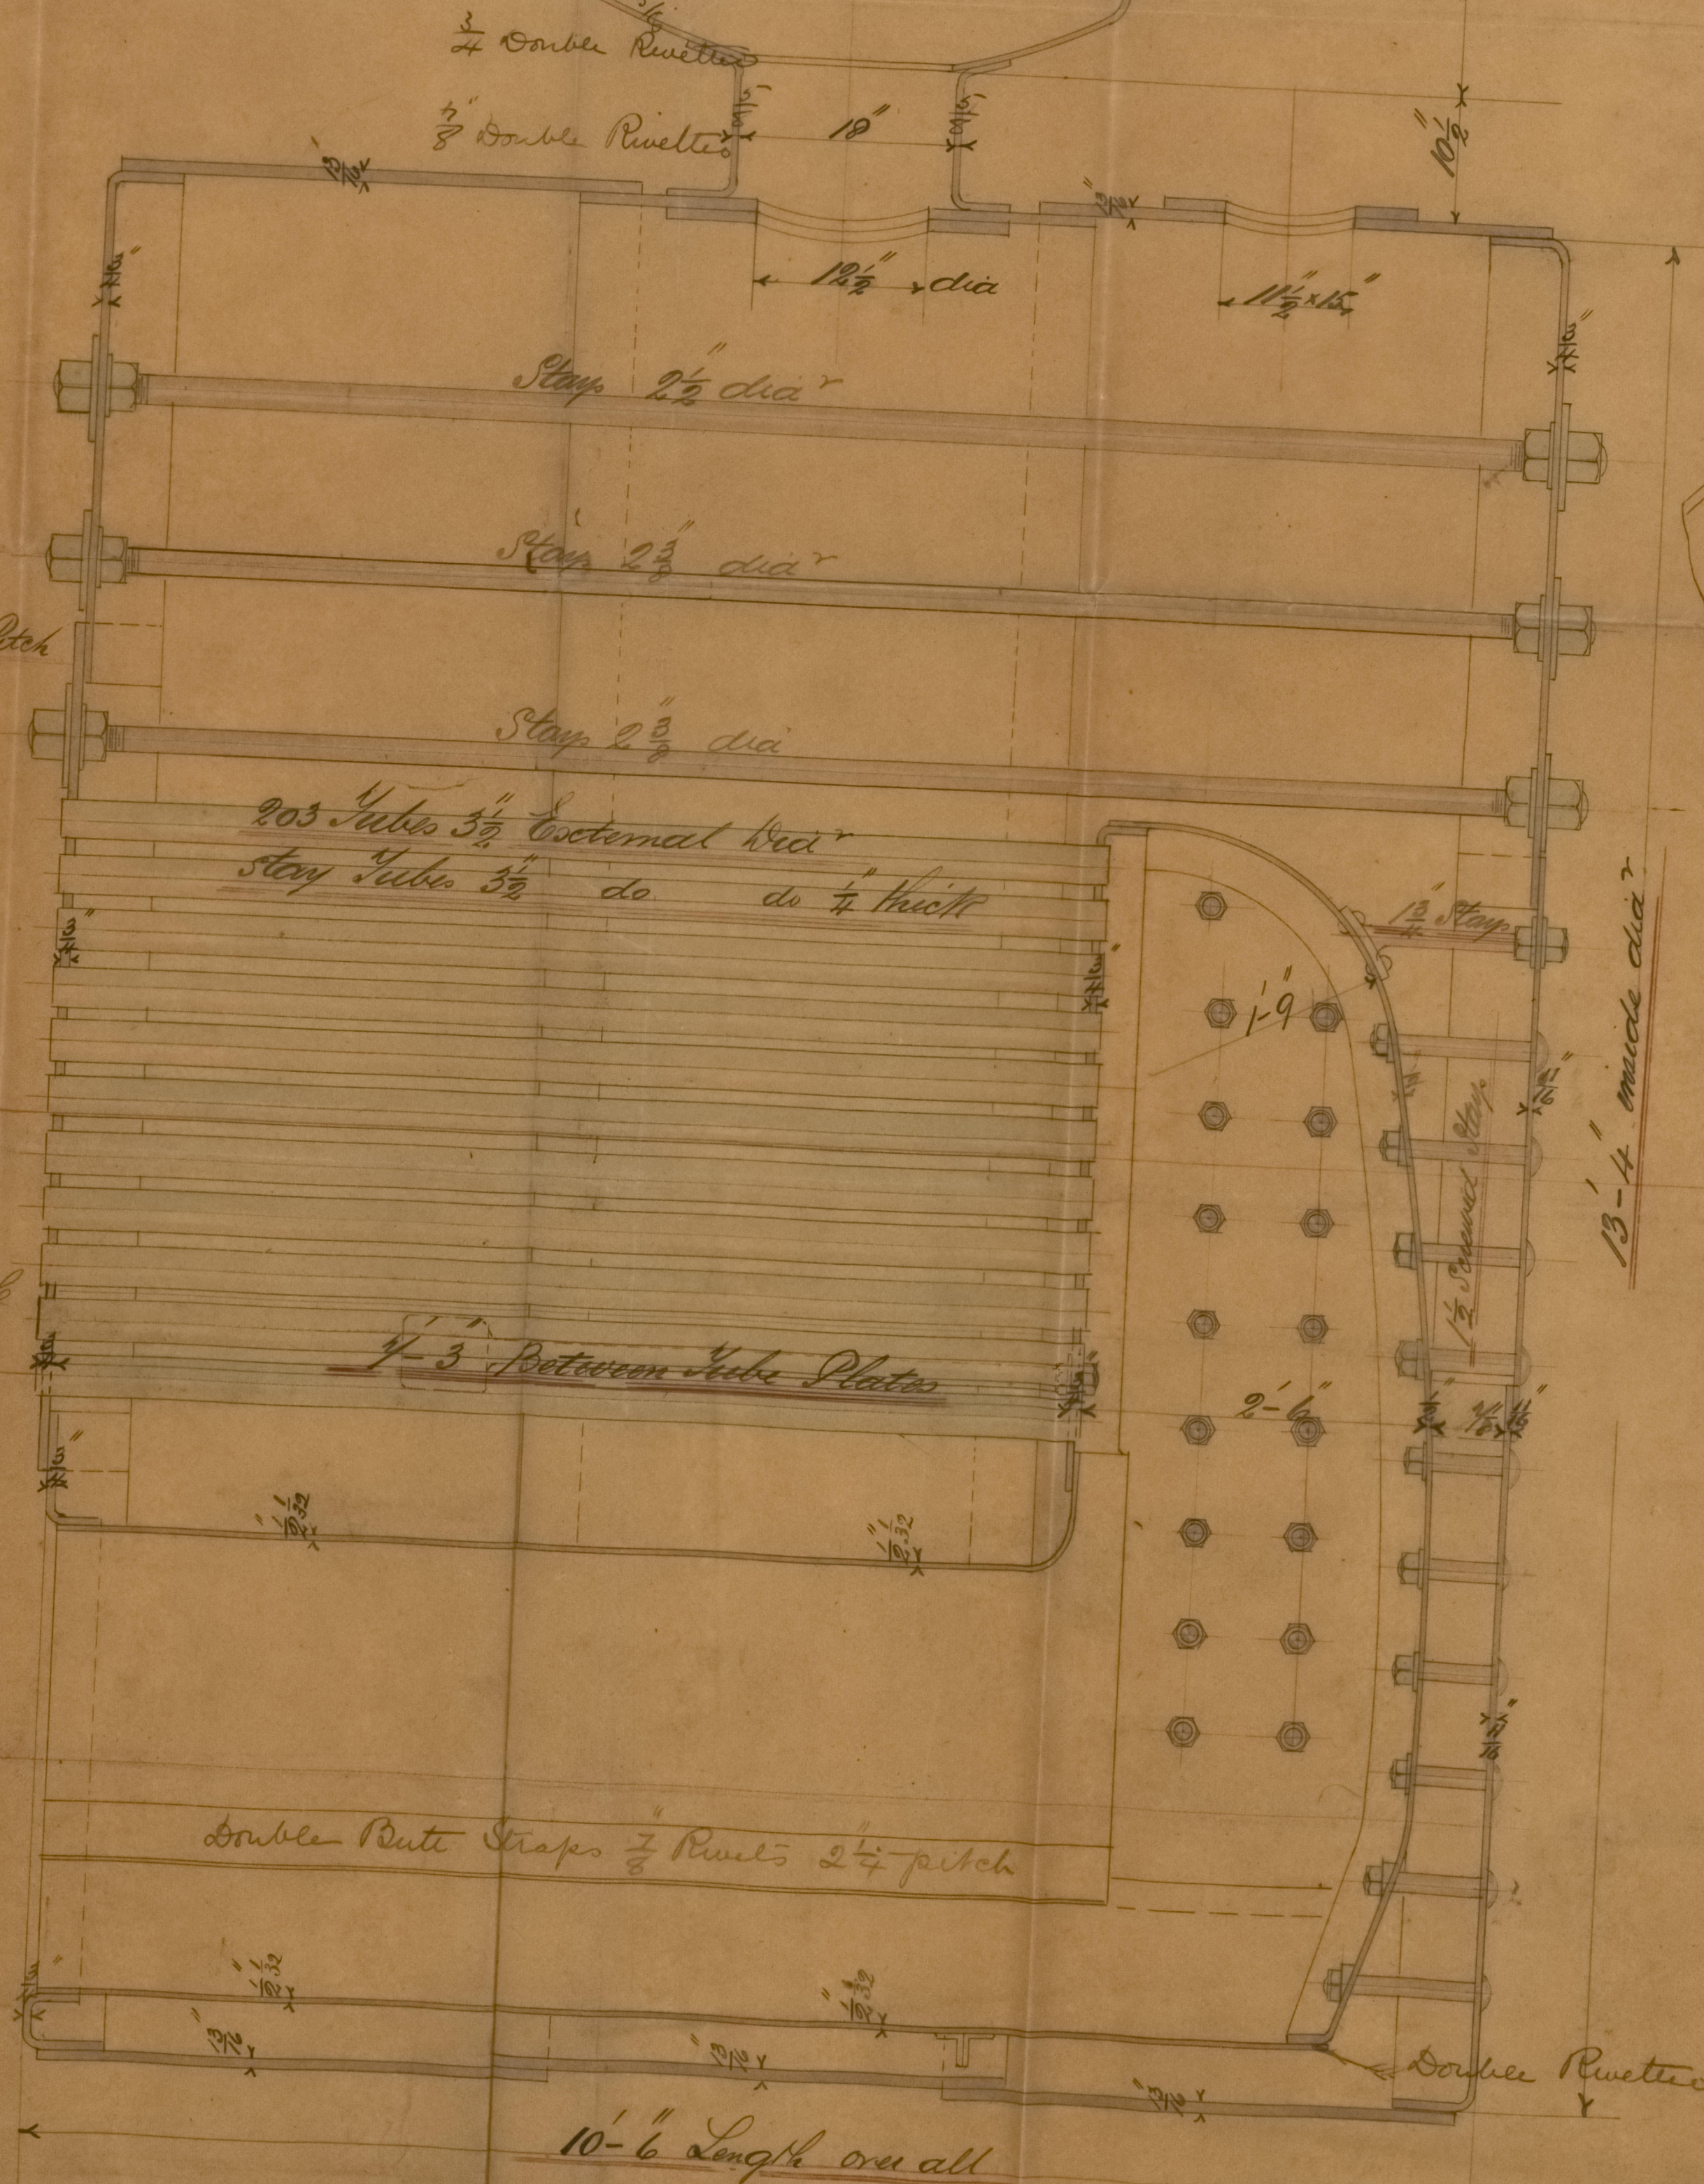

Letter A. B. C. denote  
Position of each Shape



Mitchells 396.748  
Walsend Slipway Co.  
4<sup>th</sup> Nov ~79

"Simoom"

180544-0109



© 2021

Lloyd's Register  
Foundation