

Sh to N Shlds:
20/8/80



M
20/8/80

S.S. "Simoom" Nave Report 15005
Hold, Well, & Tank Suctions, Bulkhead Cocks, & Bilge Pumps

N^o 398

Scale of $\frac{1}{8}$ inch to 1 foot
9th August 1880

G. MITCHELL & CO.,
SHIPBUILDERS,
NEWCASTLE-ON-TYNE

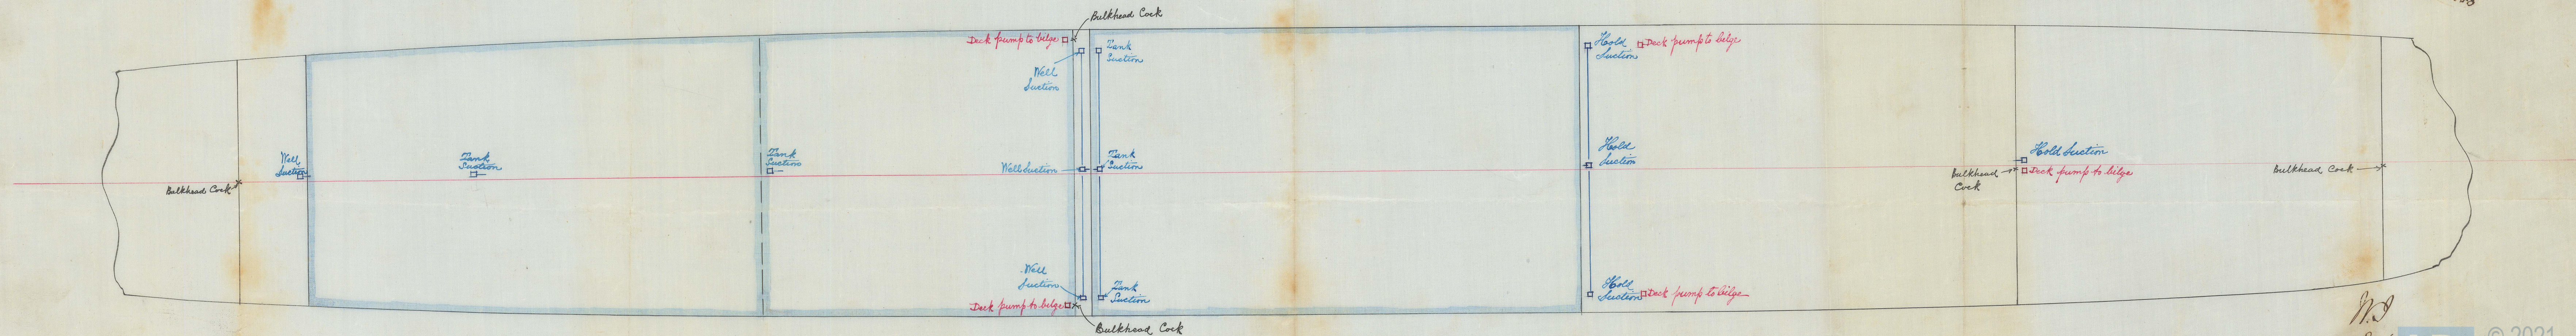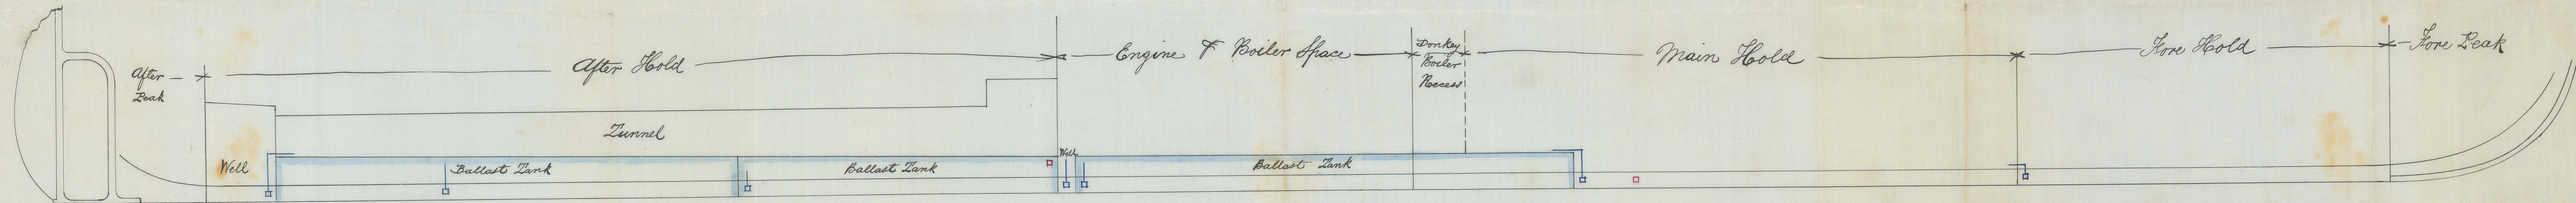

M.D.
20/8/80



© 2021
Lloyd's Register
Foundation

180544-0110