


## MIDSHIP SECTION

No. 398

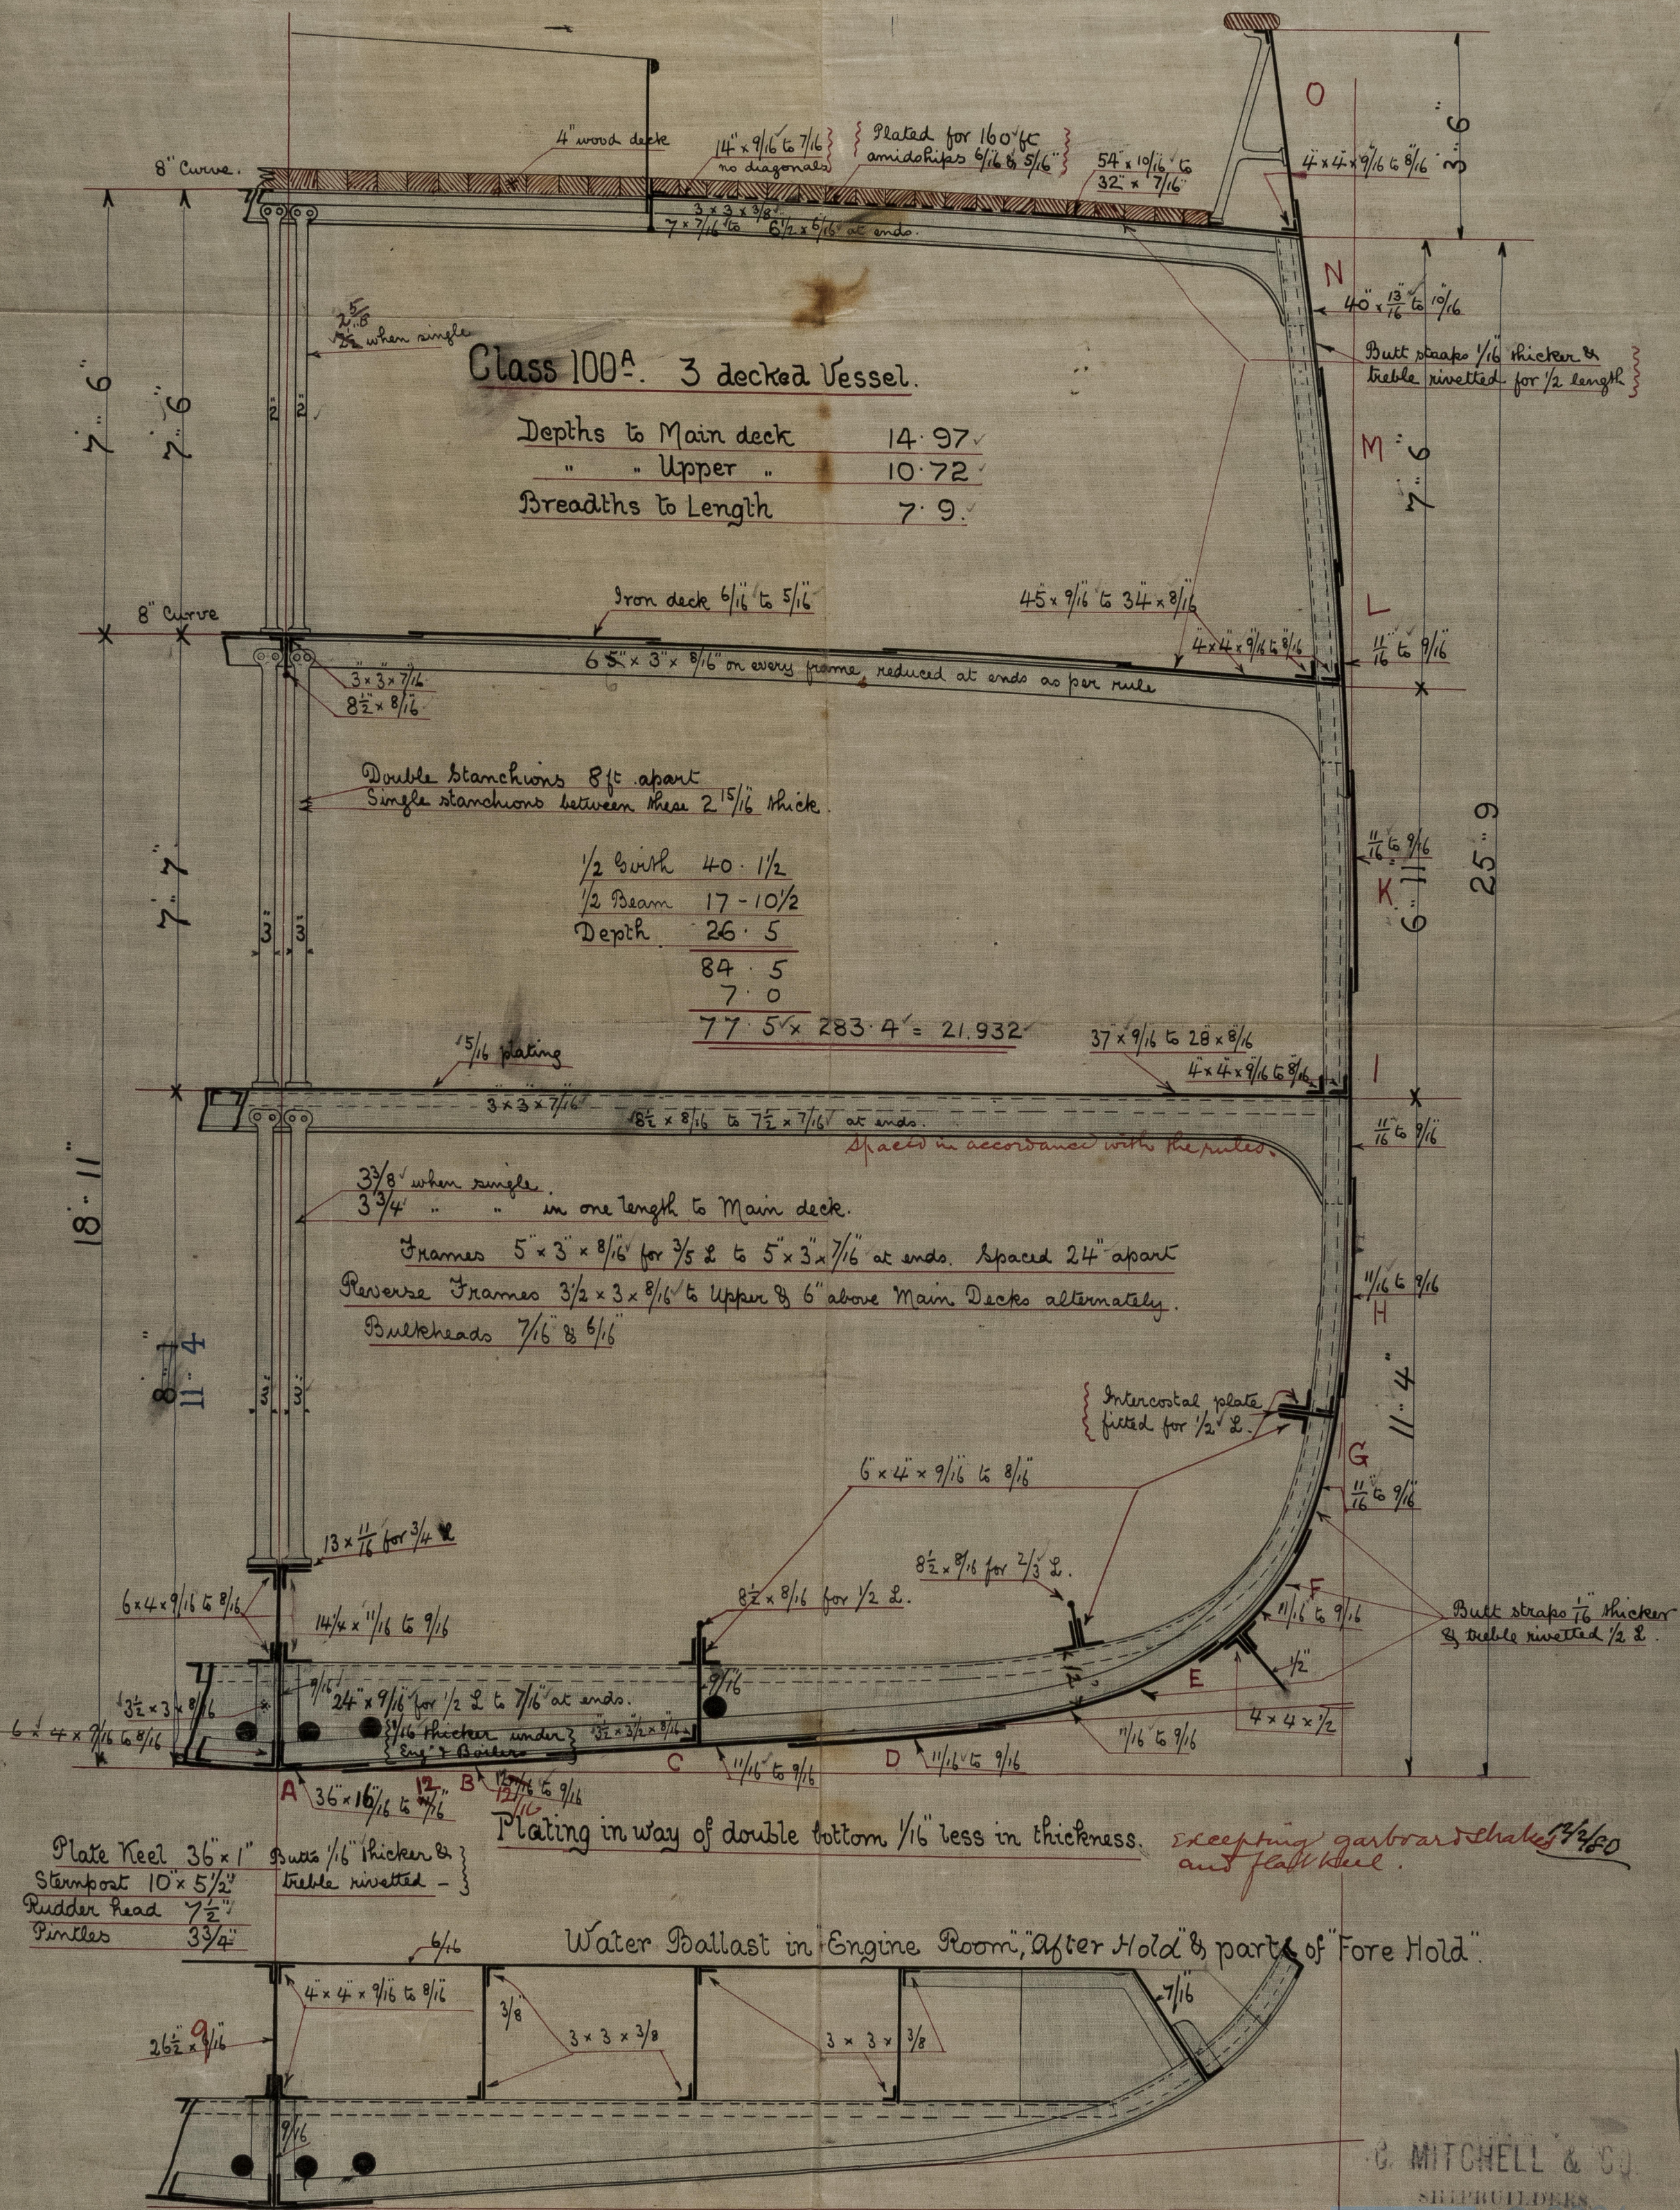

C. MITCHELL & CO  
SHIPBUILDERS

CASTLE-ON-TYNE

Feb 2<sup>nd</sup> 1880

Lloyd's Register  
Foundation

2025-11-11