

Tracing No. 7

Steel S.S. "Asyrian Monarch" Report No. 4928


Iron 28153



No 224

PLAN OF PANTING STRINGER

SCALE 3/4 INCH = ONE FOOT

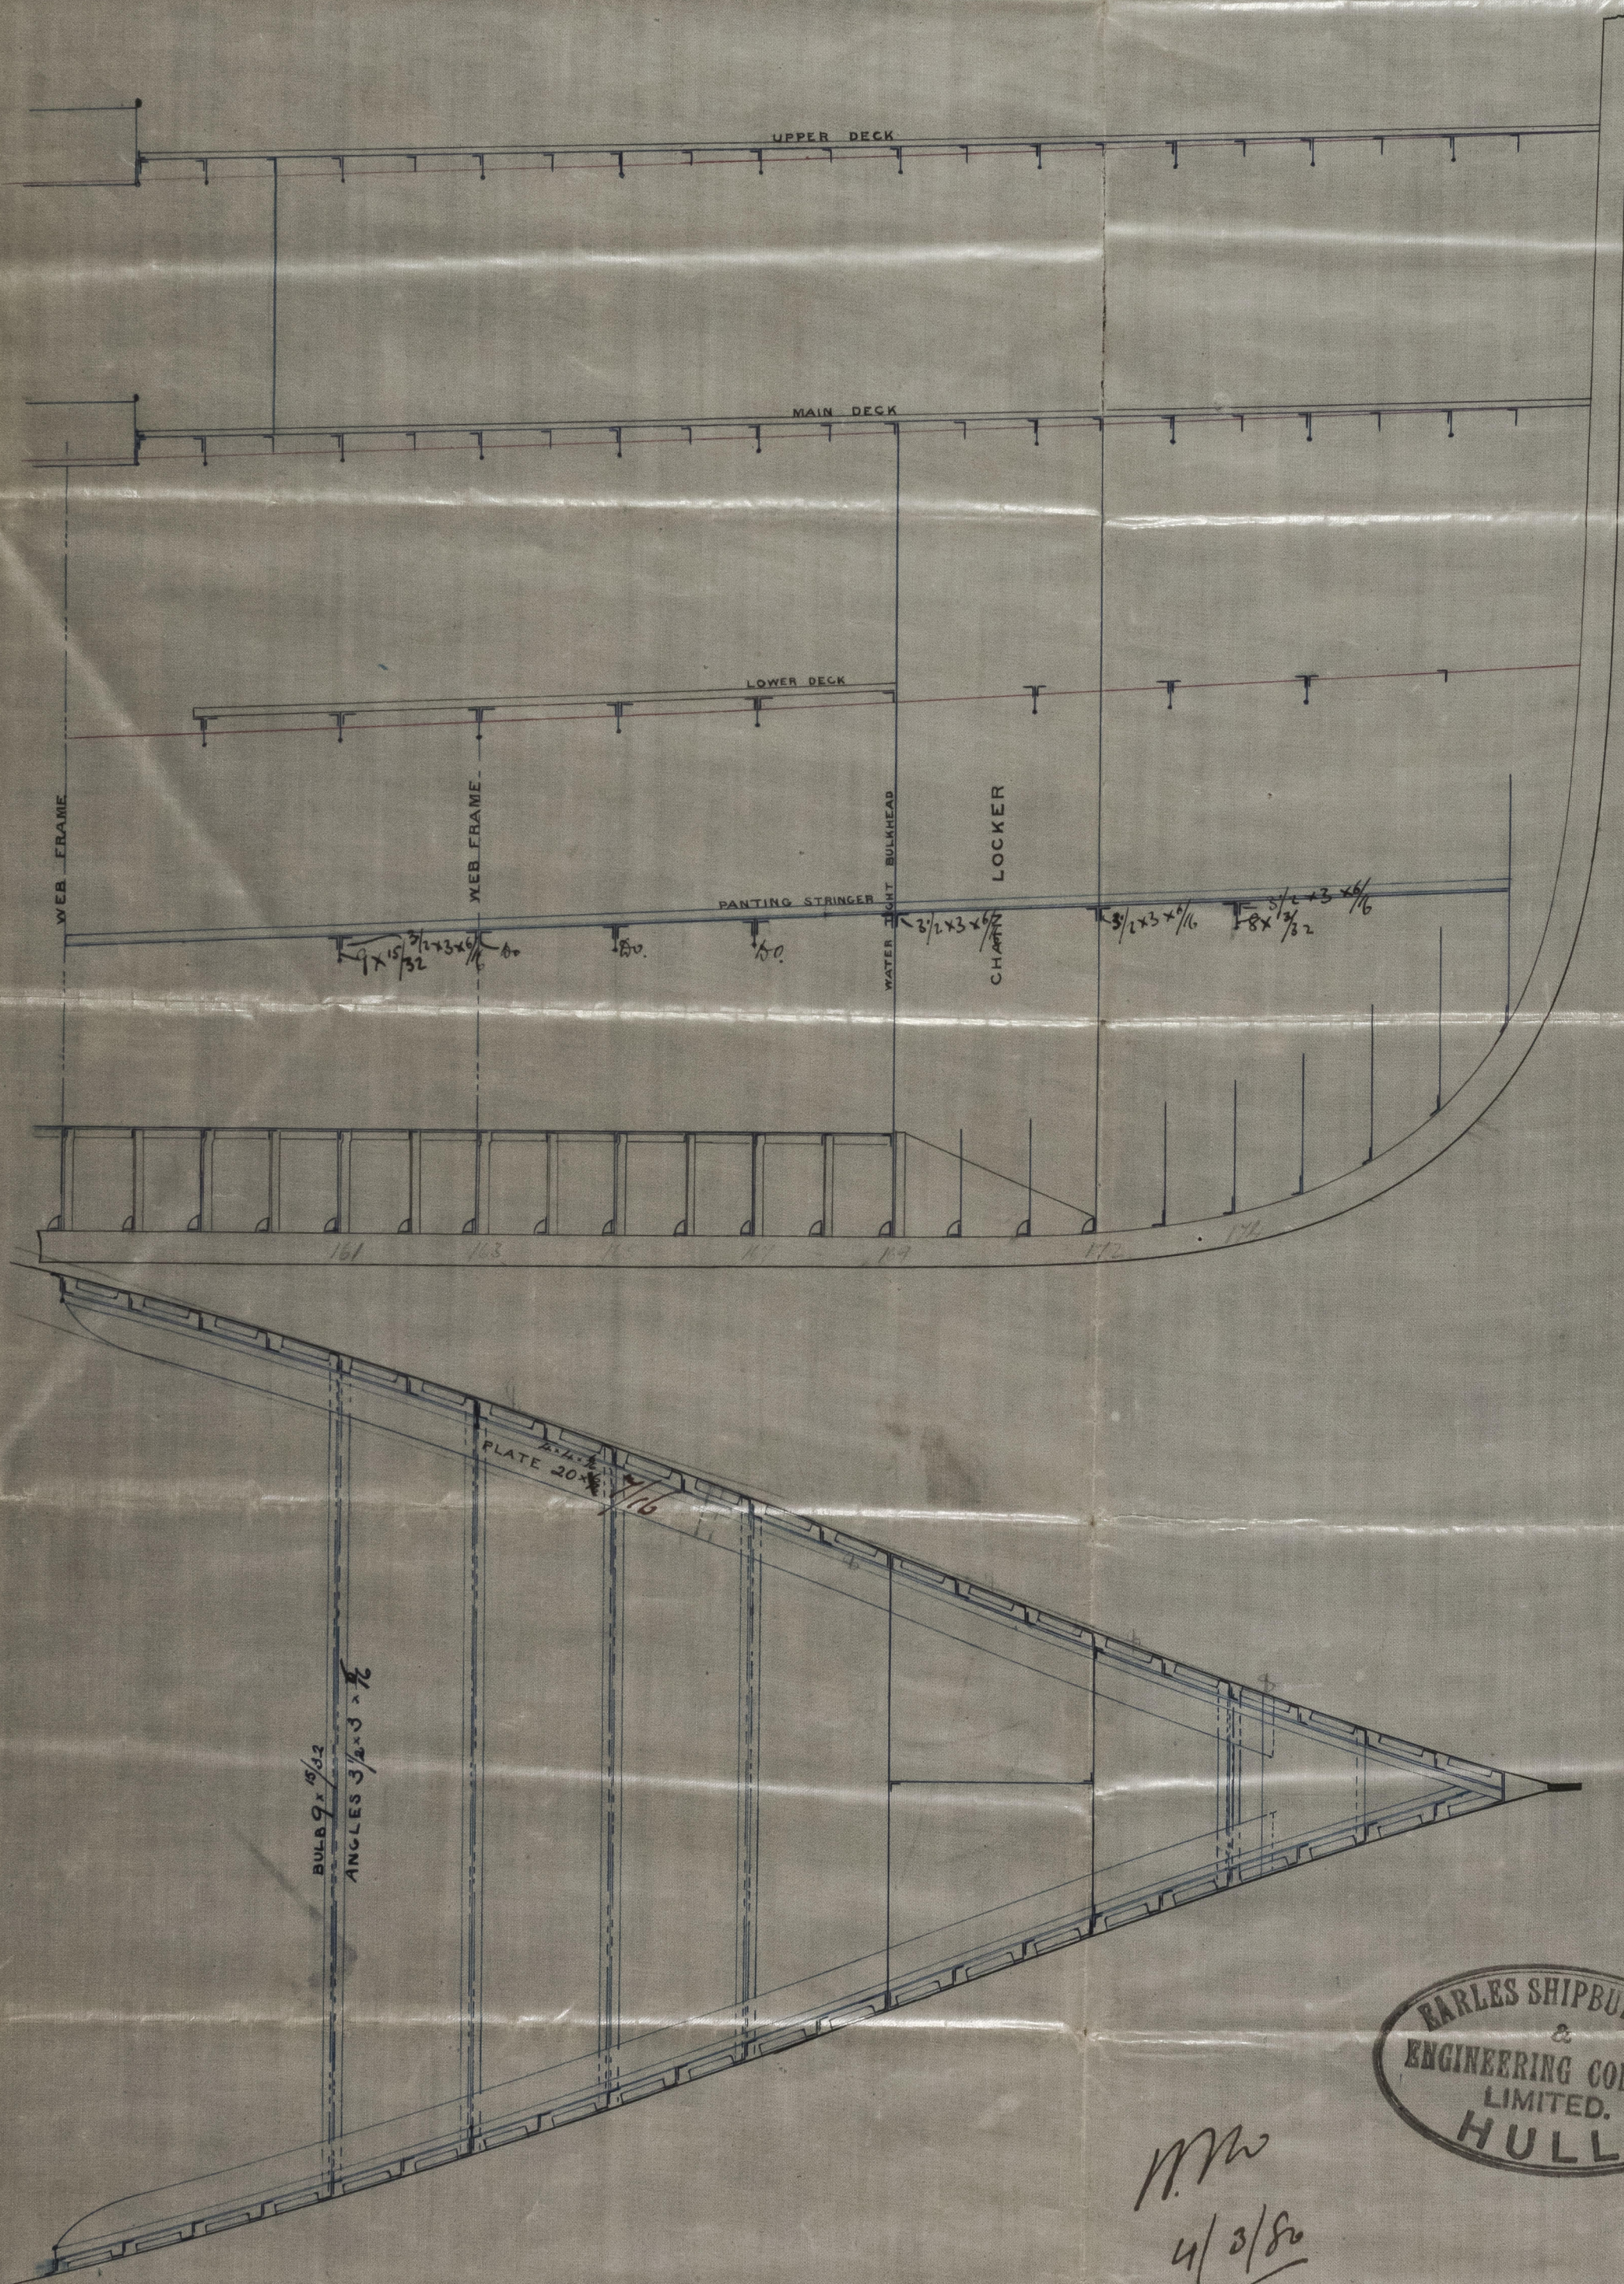

MW
4/3/80



© 2021

Lloyd's Register
Foundation

120NS45-6056










© 2021

Lloyd's Register
Foundation