


Tracing No 6.

# Sheel S.S. Assyrian Monarch, Report No. 4928.


No. 2244 -  
Proposed Cattle Shelter -  
Scale 1/8" = 1 foot -

15-4-80


Section thro Poop

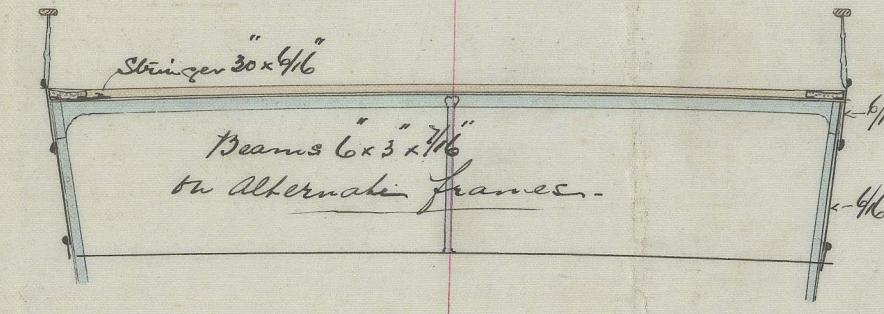


Section thro: after Cattle Shelter

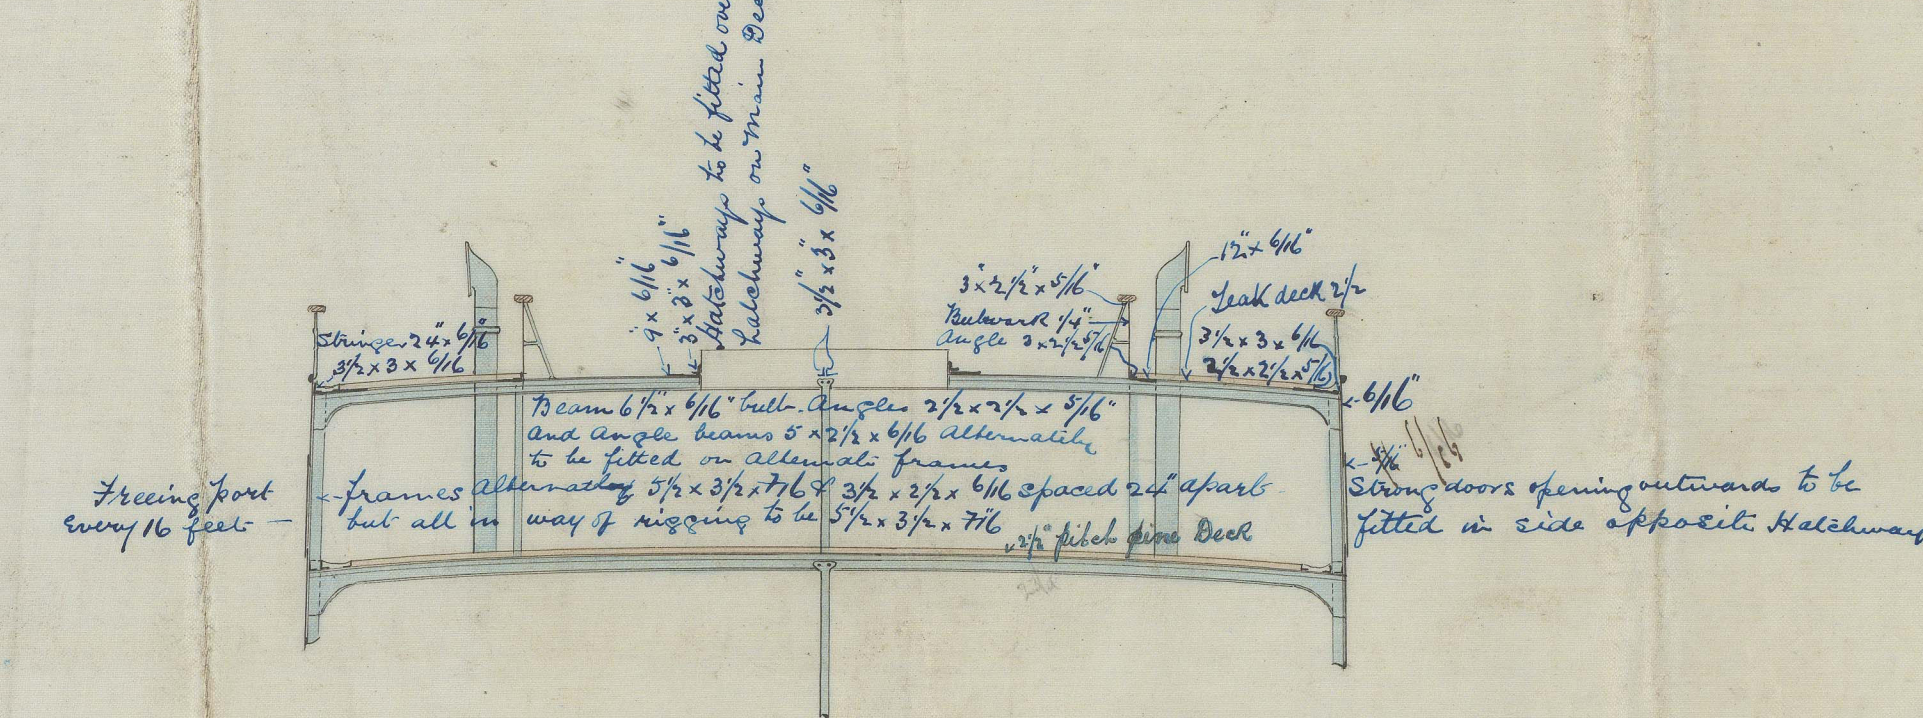


Section thro: Engine & Boiler Casing

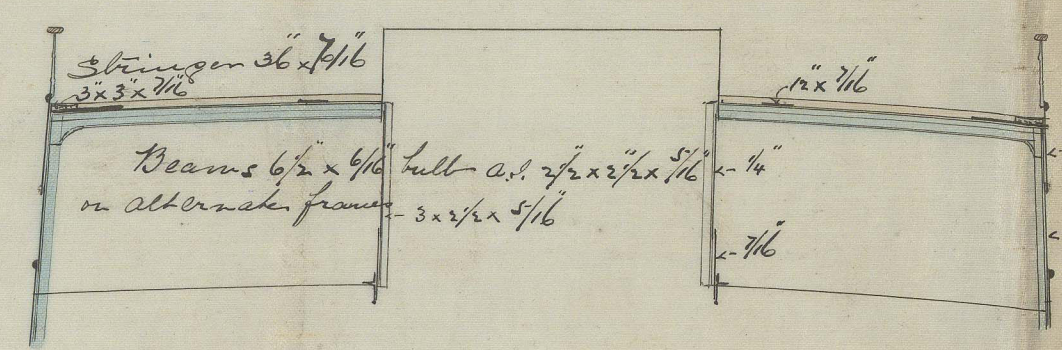


Section thro: Deck House

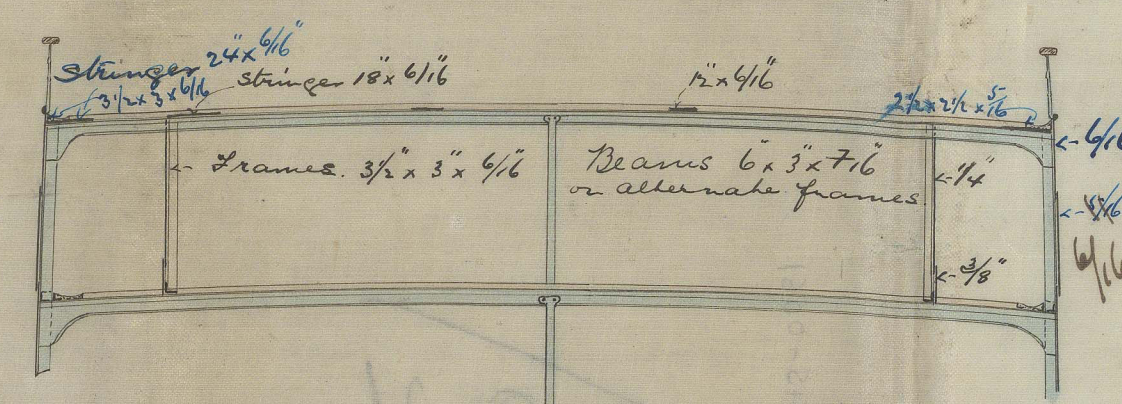


Section thro: Fore Cattle Shelter

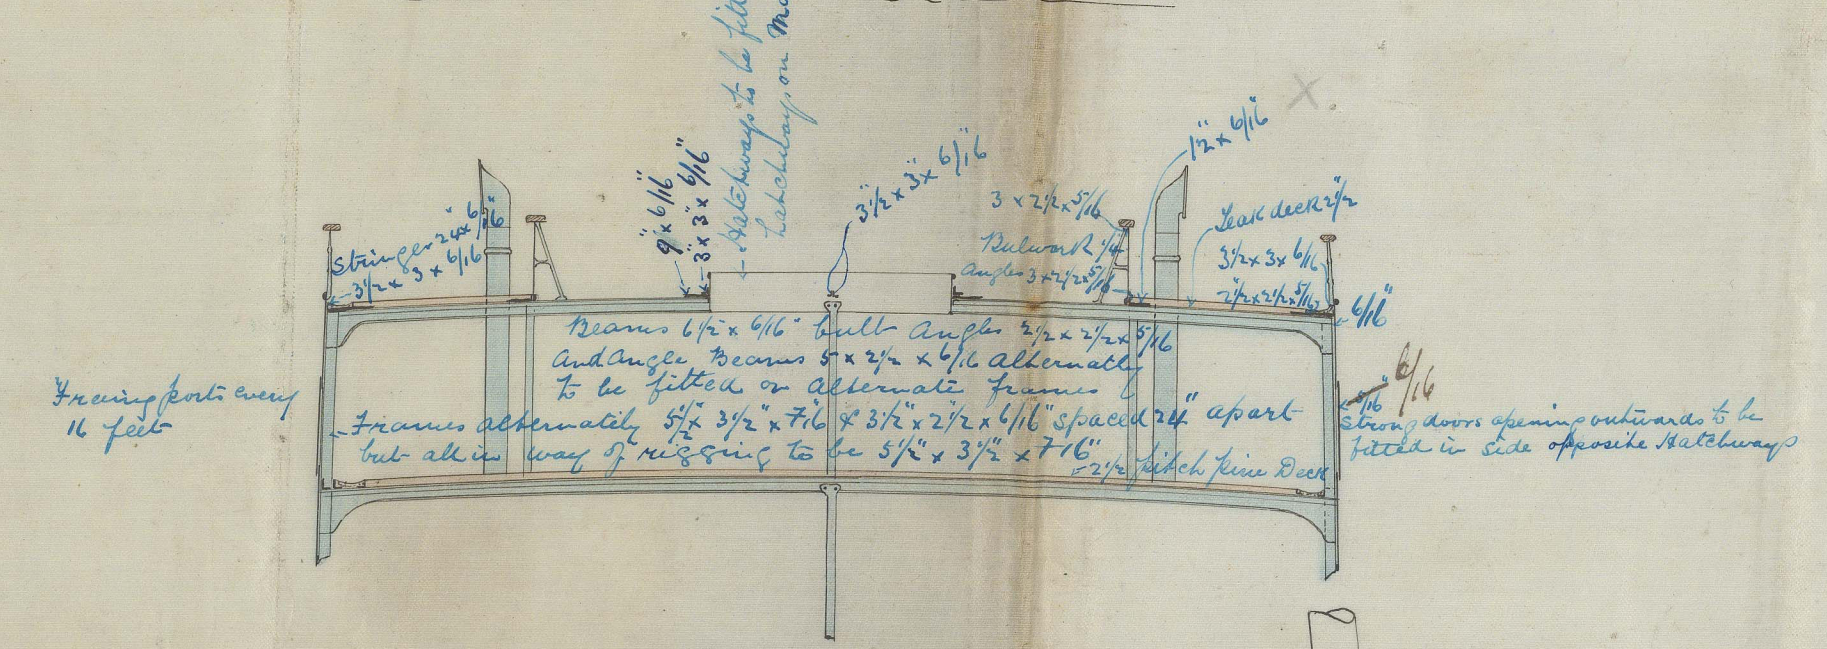


Section thro: Forecastle

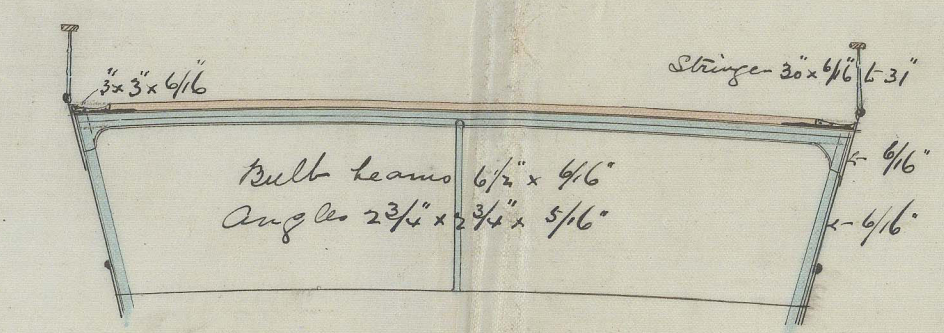

Original Scantling of Poop, Bridge & Fore-castle approved by Lloyd's the 28. 1. 80 Shown in Black -  
Scantling of Proposed Cattle Shelter Shown in Blue

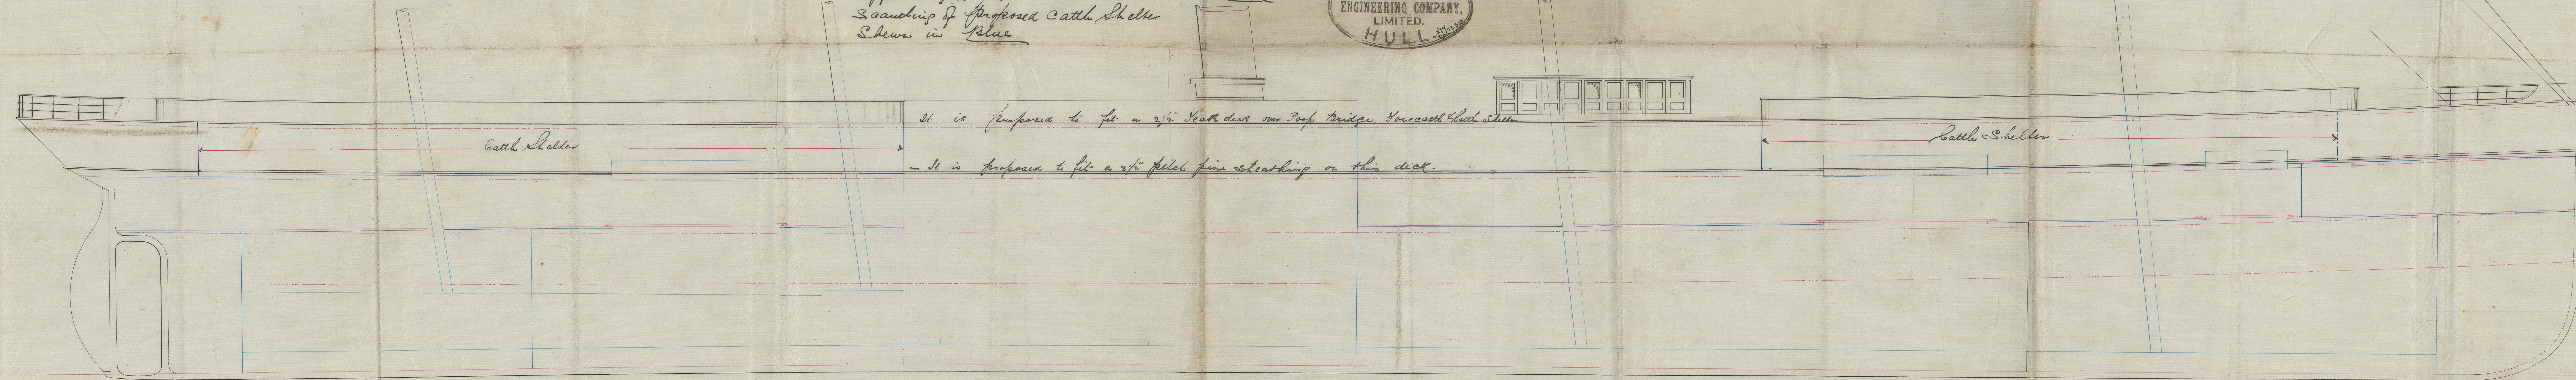




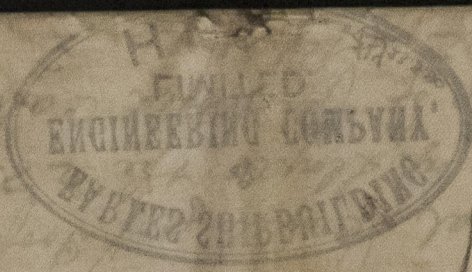

no 6

(KONS45-0061)

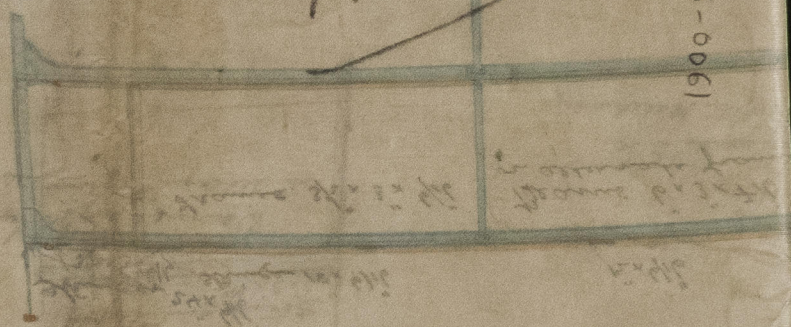






© 2021  
Lloyd's Register  
Foundation