


*"Assyrian Monarch" Shelter deck plan*


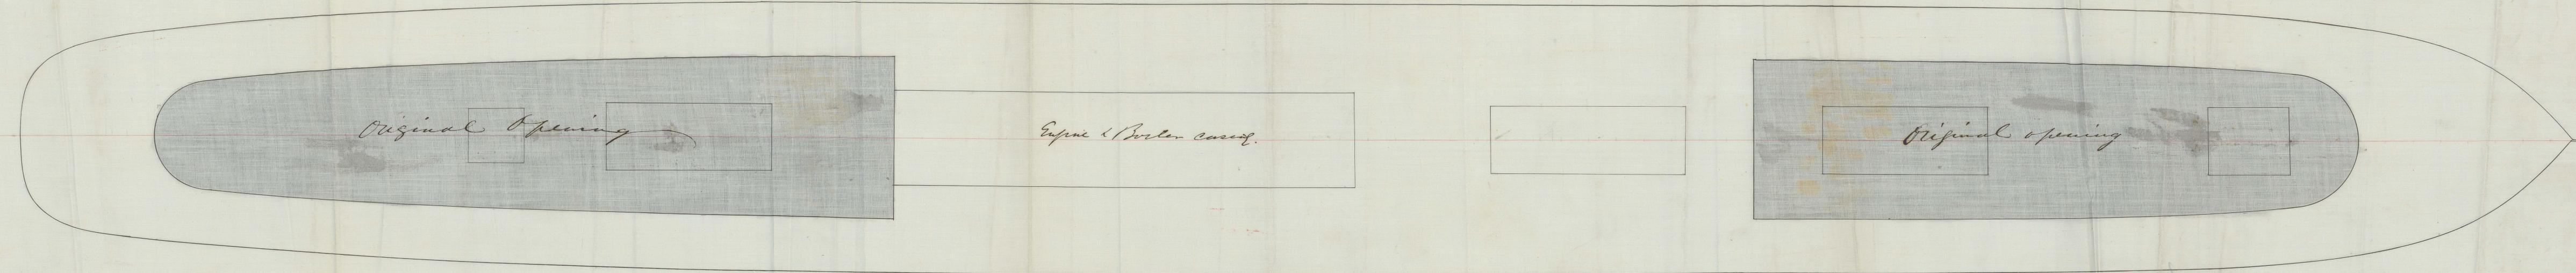


*AW*  
*ds*

120545-0064  
120545-0064

100002-0081  
IRONS45-0064

Atty In

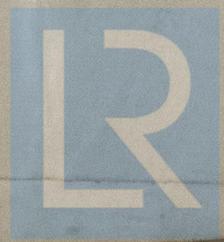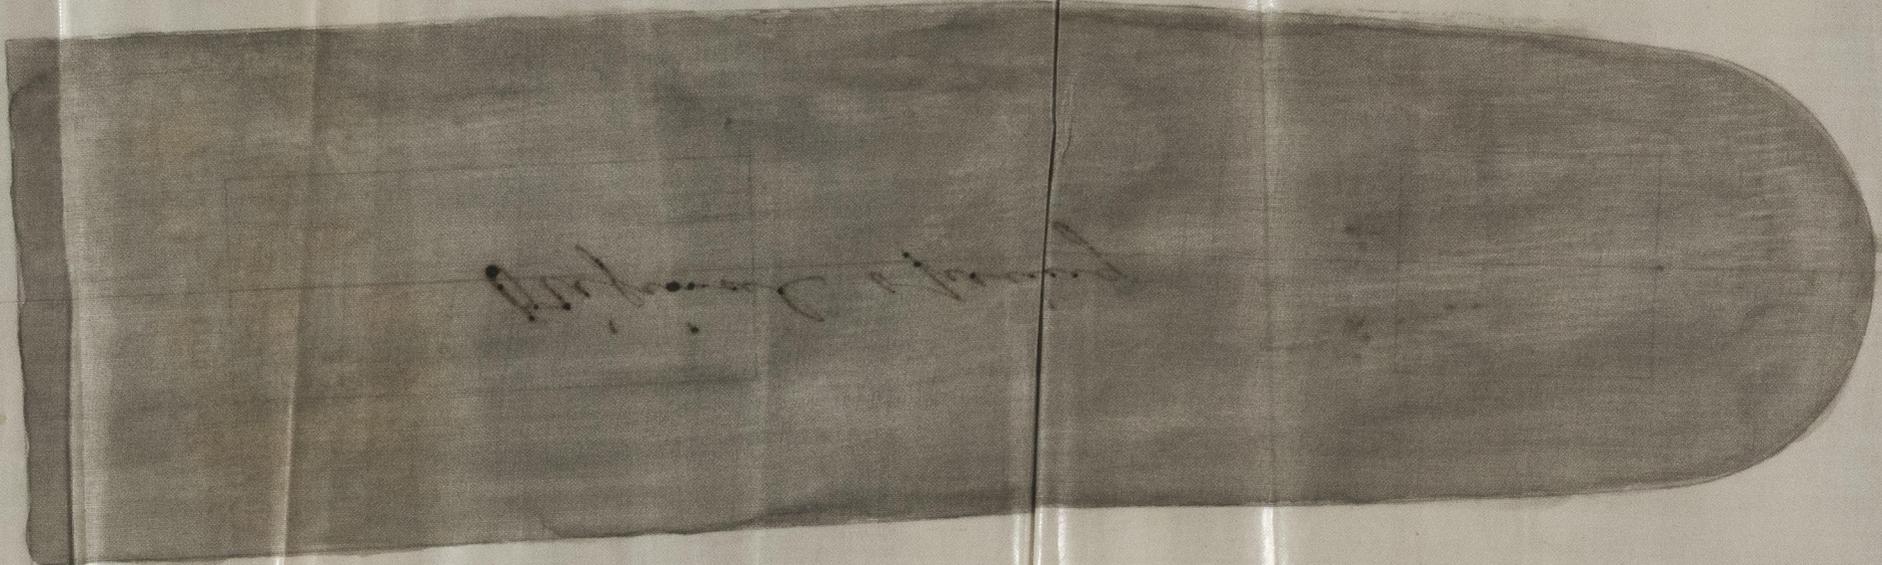

© 2021  
Lloyd's Register  
Foundation