

SECTION AT CENTRE OF
AFTER HOLD

S S N^o 1110

SCALE - 1/2" INCH TO 1 FOOT

28/5/80

Quarter Deck

Proposed Compensation in lieu
of a third tier of Beams in
after Hold.

For position of Partial Bulkheads
see profile.

Hold Stringer

The dotted Blue lines show where
position of Beams would be
with the third tier of Beams

Plate 1 1/4" x 7/16"

about angle iron

SHORT BROTHERS,
IRON SHIP BUILDERS,
SUNDERLAND.

Wanda 21/5/80


Amel.

28/5/80



sp "Olga"
ex (Bellini)
Iron 28309

IRON 546-0013

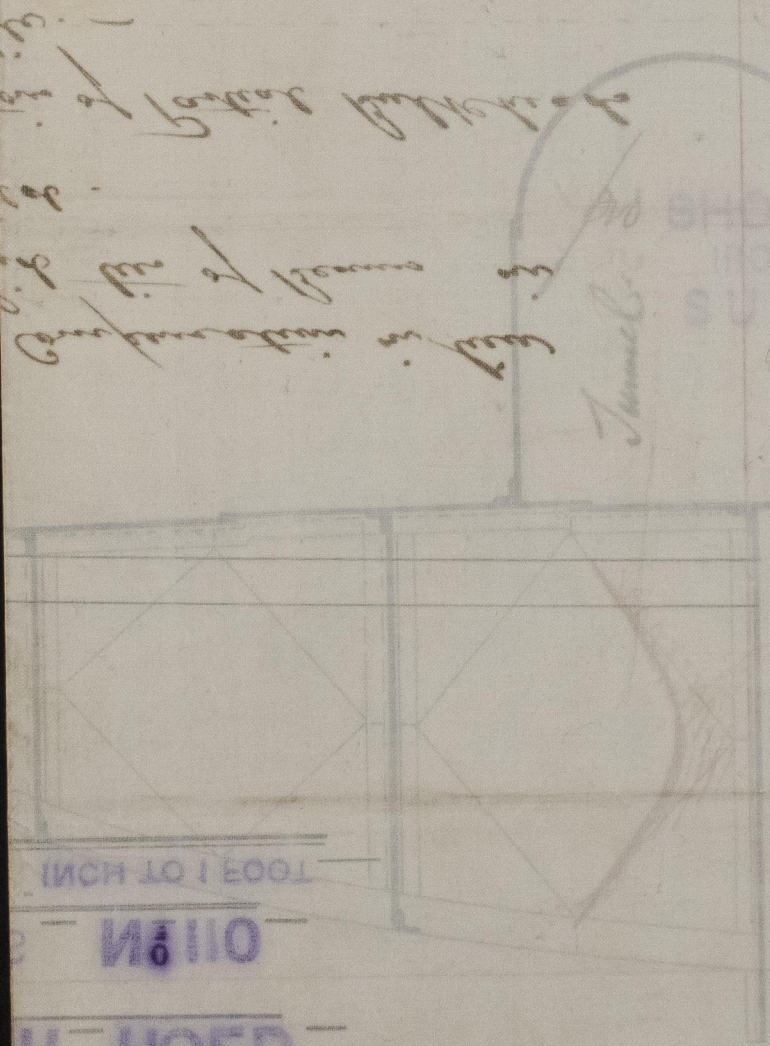

INCH TO 1 FOOT

1/10

W HOD

CEITRE OF



© 2021

Lloyd's Register
Foundation