

(No 1.) S. S. "Ethel"

Belfast report No 2712

MIDSHIP SECTION

S. S. 150' 0" x 21' 6" x 10' 9" (hold)

Class 90A at Lloyds

Scale $\frac{1}{2}'' = 1 \text{ foot}$

Numeral's


$$10.75 + 20.15 + 11.91 = 42.81 \text{ Framing}$$
$$42.81 \times 148.92 = 6345 \text{ Plating}$$
$$6375 + 425 =$$

6800 Equipm

6.8 Breadths

12.5 Dept Ehs

4 with $\frac{1}{15}$ added (to plating v.c.) for
erections, combined length less
than $\frac{1}{4}$ the vessels' length.

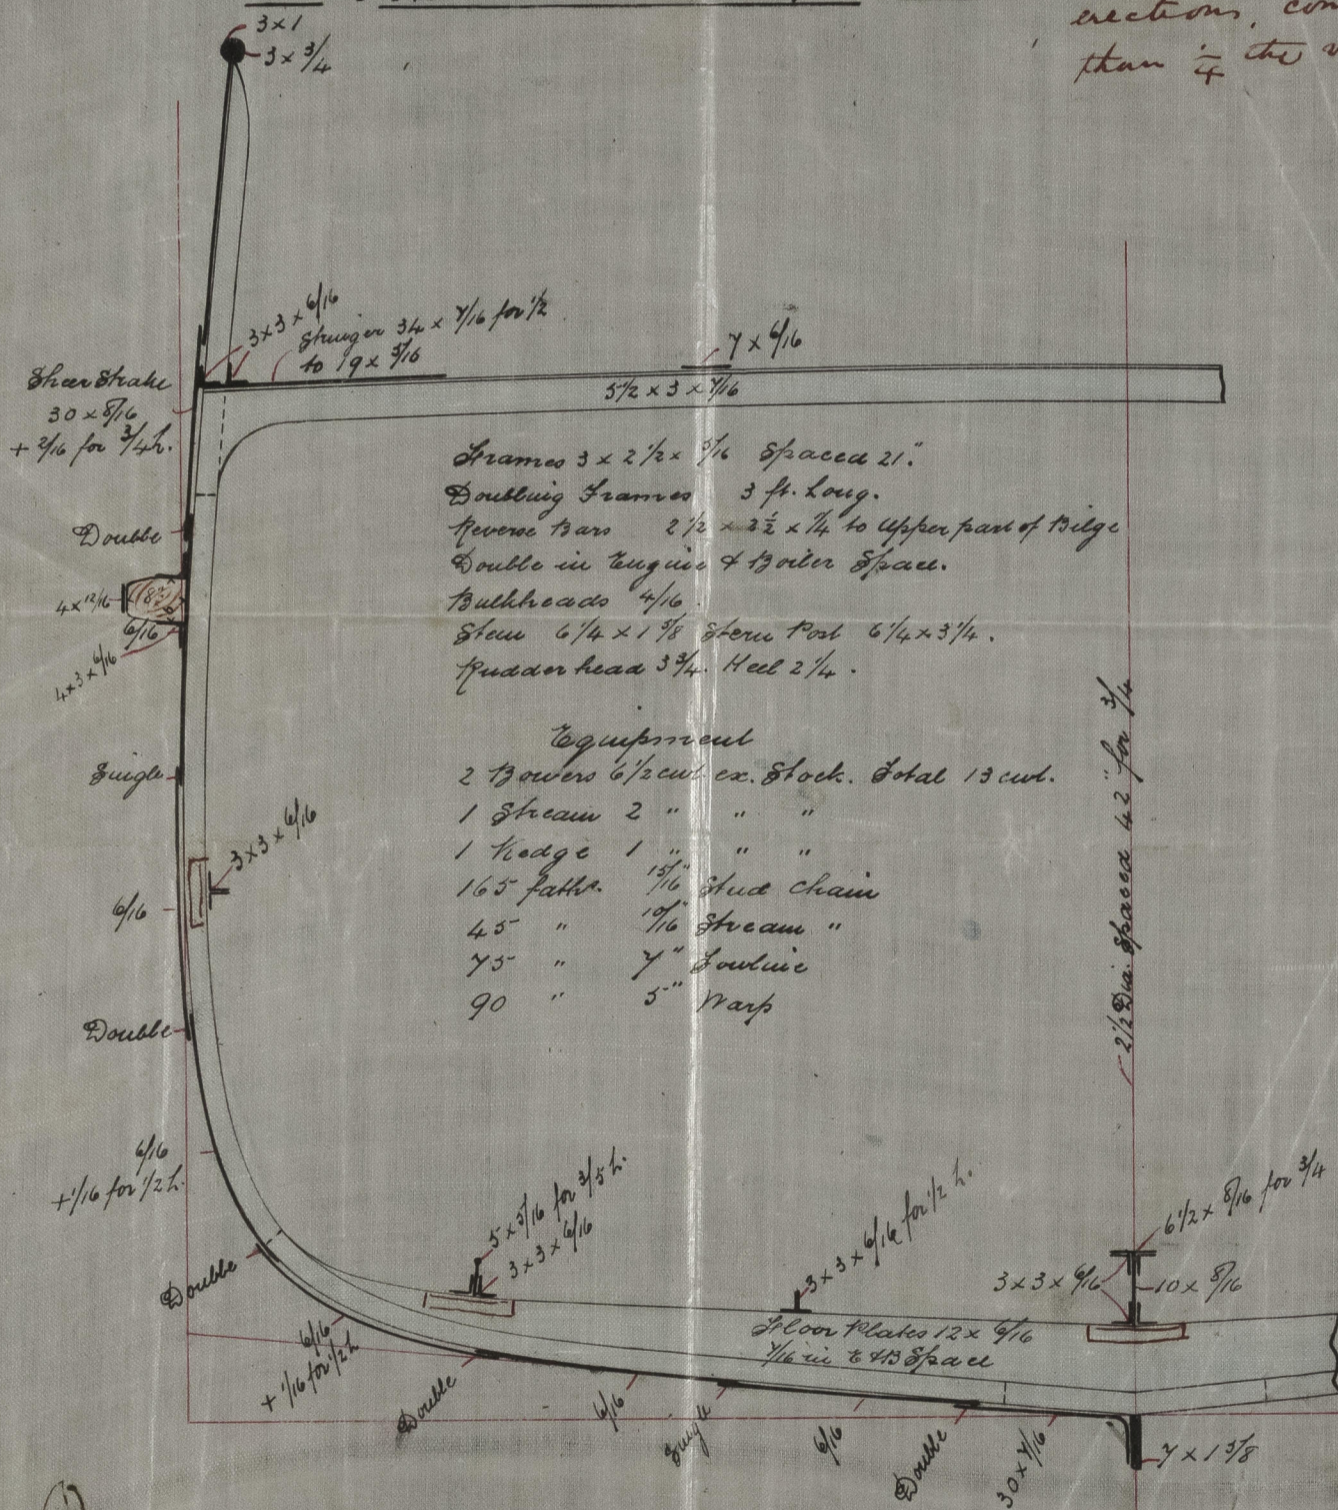

Workman Clark Hey.

to clear

18/3/80

Lloyd's Register
Foundation

IRONS46-002S