



*St. Pierre Atmarch*

*Belong on September 5, 19*

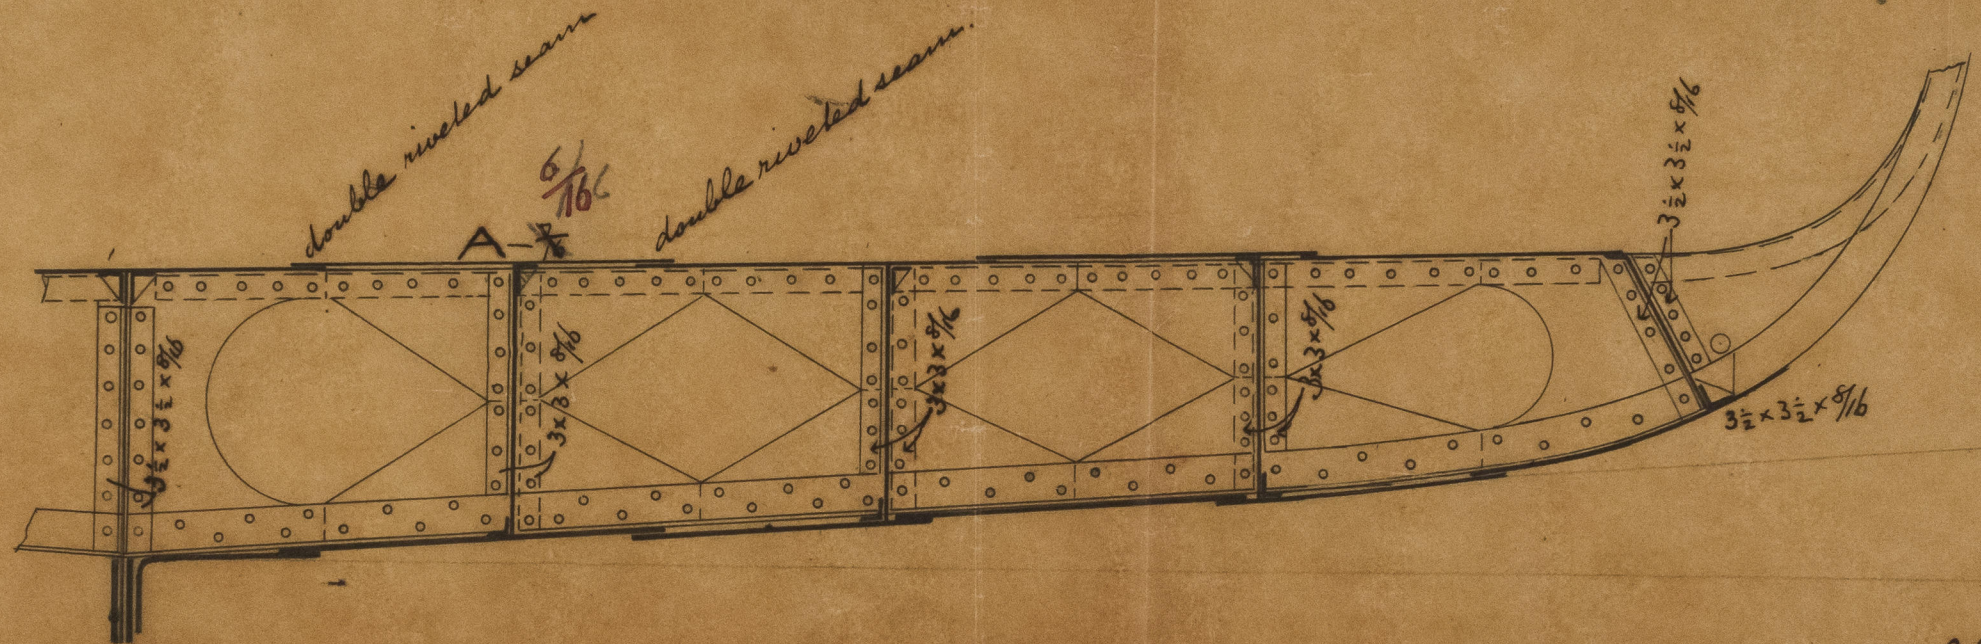

*137M  
6/12/79*

*J.H.*

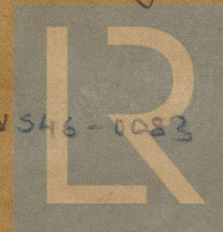

© 2021

Lloyd's Register  
Foundation

IRON 546-0083