

10.3.80

"S.S. William Henle"

Belfast report No 2721

No 2

MIDSHIP SECTION

160'-0" x 22'-6" x 11'-11" (top of floors)

Class 100 A at Lloyd's

Scale $\frac{1}{2}$ " = 1 foot


Numerals

11.25 + 22.08 + 13.25 = 46.58 Framing

46.58 x 158.92 = 7402 Plating

7402 + 740 = 8142 Equipment

11.9 depths - 7.06 breadths

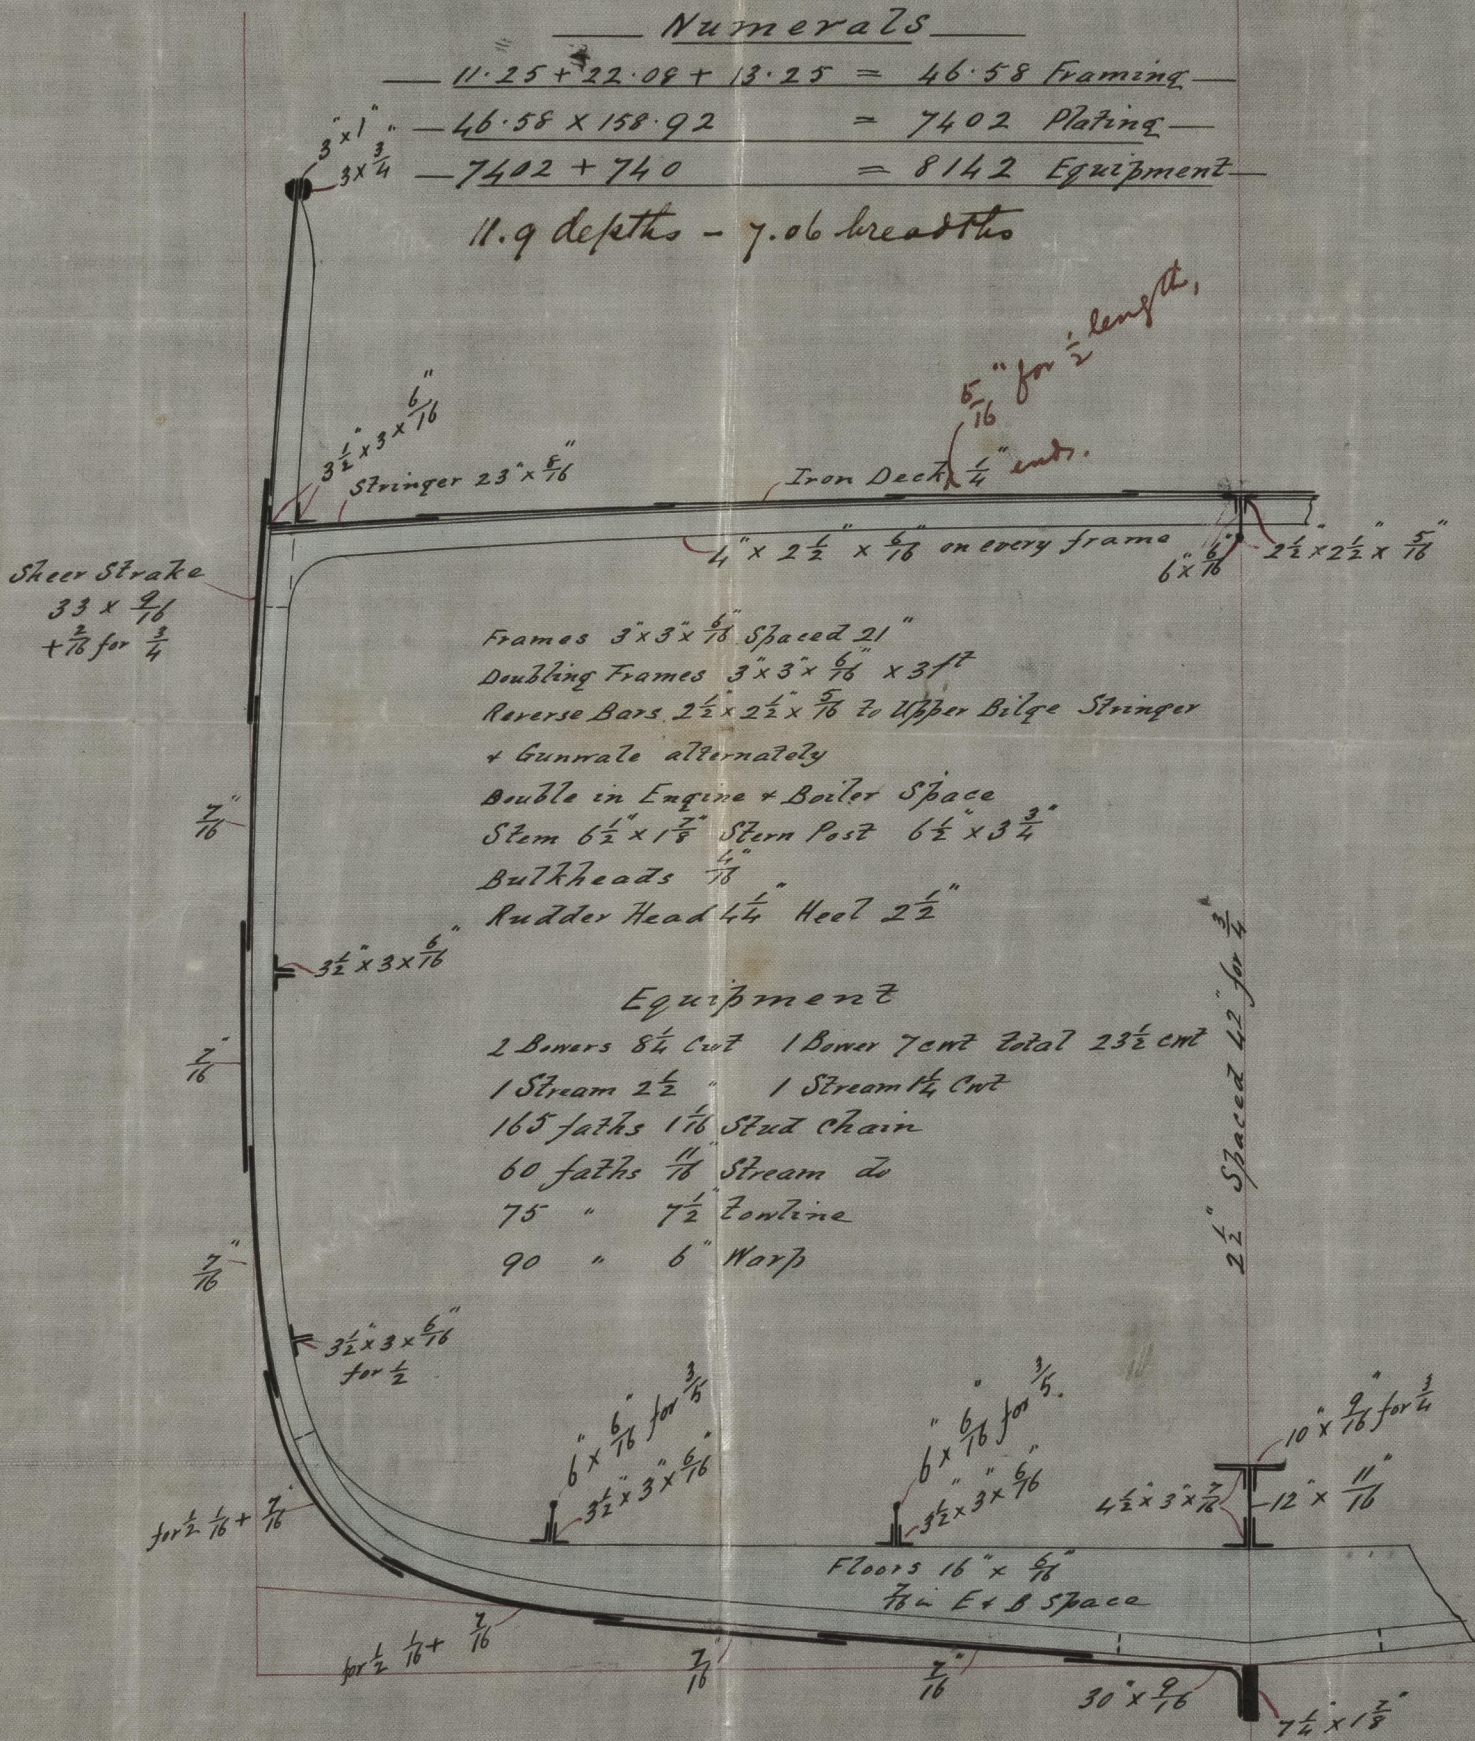

Workman Clark & Co
Spencer Dock 5/3/80
Belfast

6/9/80

2021
Lloyd's Register
Foundation

IRONS46 - 0170

