


Profile of S.L. No 2.

S. S. William Hinde  
Belfast report No 2721.

Iron 28549

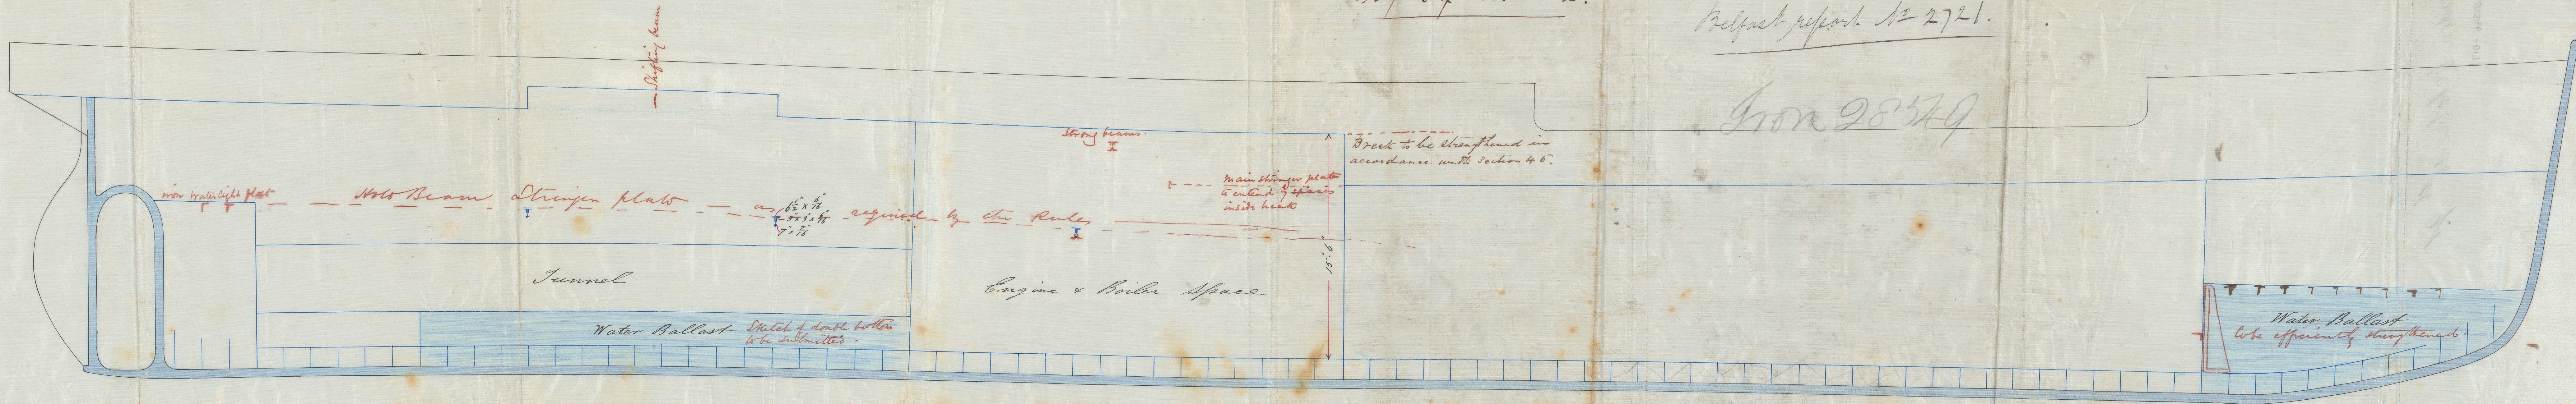

Workman Clark & Co  
Belfast Shipyard  
Belfast

5/3/80

J.W.  
6/3/80

J.W.  
10/3/80




© 2021  
Lloyd's Register  
Foundation



London October 10<sup>th</sup> 91

IRONS46 -017

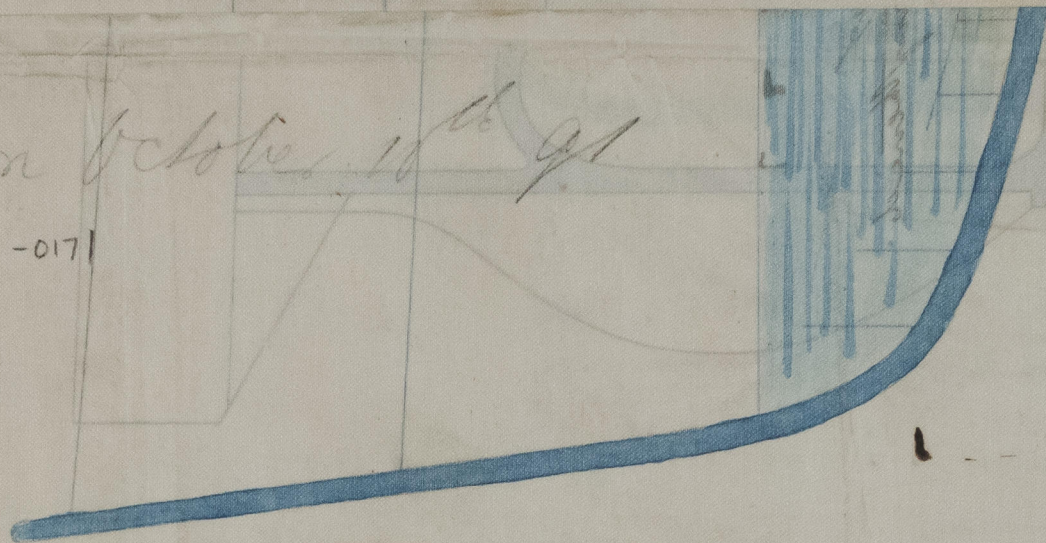




© 2021

Lloyd's Register  
Foundation