
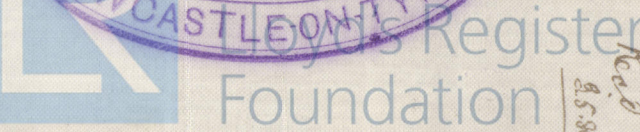


Scale $\frac{1}{8}$ Inch = 1 Foot.

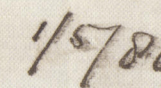

IRON 547-0025

W.C.
3/5/80

3/2/80

W.F.



1/2/80

28639 Lion

"Teddington"

120547-0025



© 2020

Lloyd's Register
Foundation