


Screw Steamer Valencia

of Ardrossan
Greenock Report No. 4804.

Midship section for Steel Screw Steamer
No. 155-S S
Length Keel & Foremast -- 240' 0"
Breadth Moulded -- 32' 3"
Depth of Hold -- 17' 0"
Gross Tonnage about 1200 tons

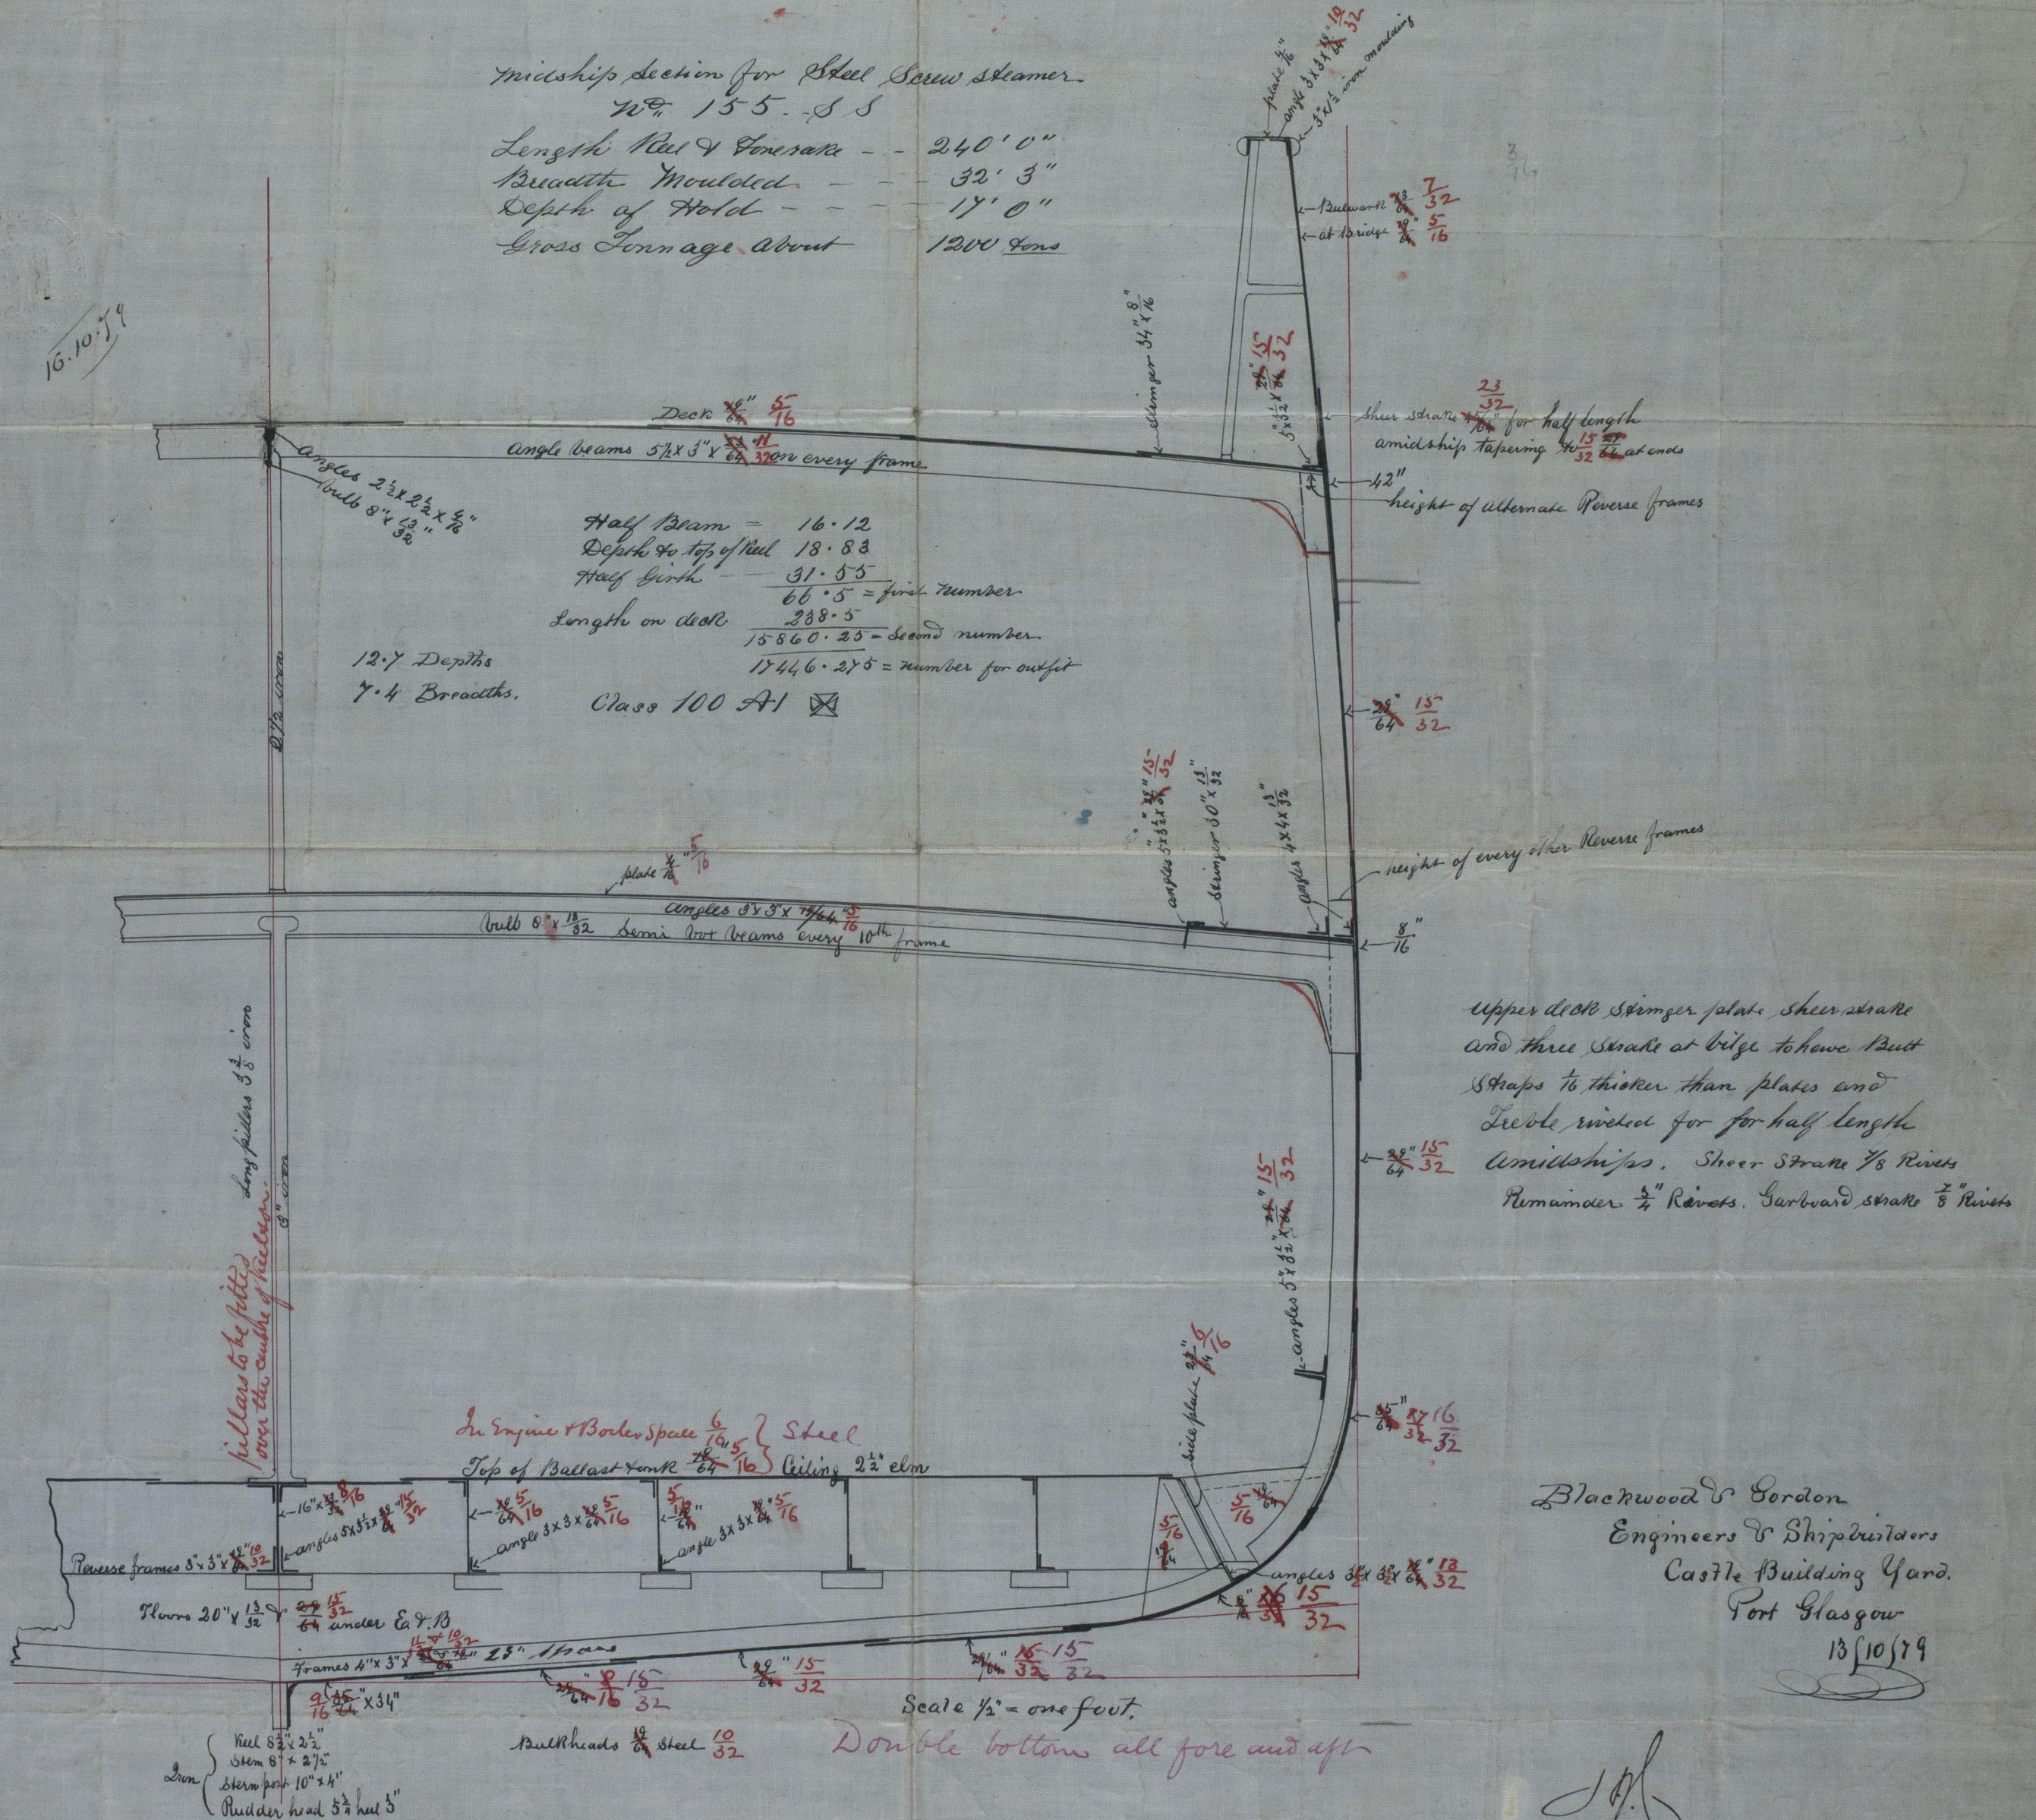

16/10/79
22/10/79