



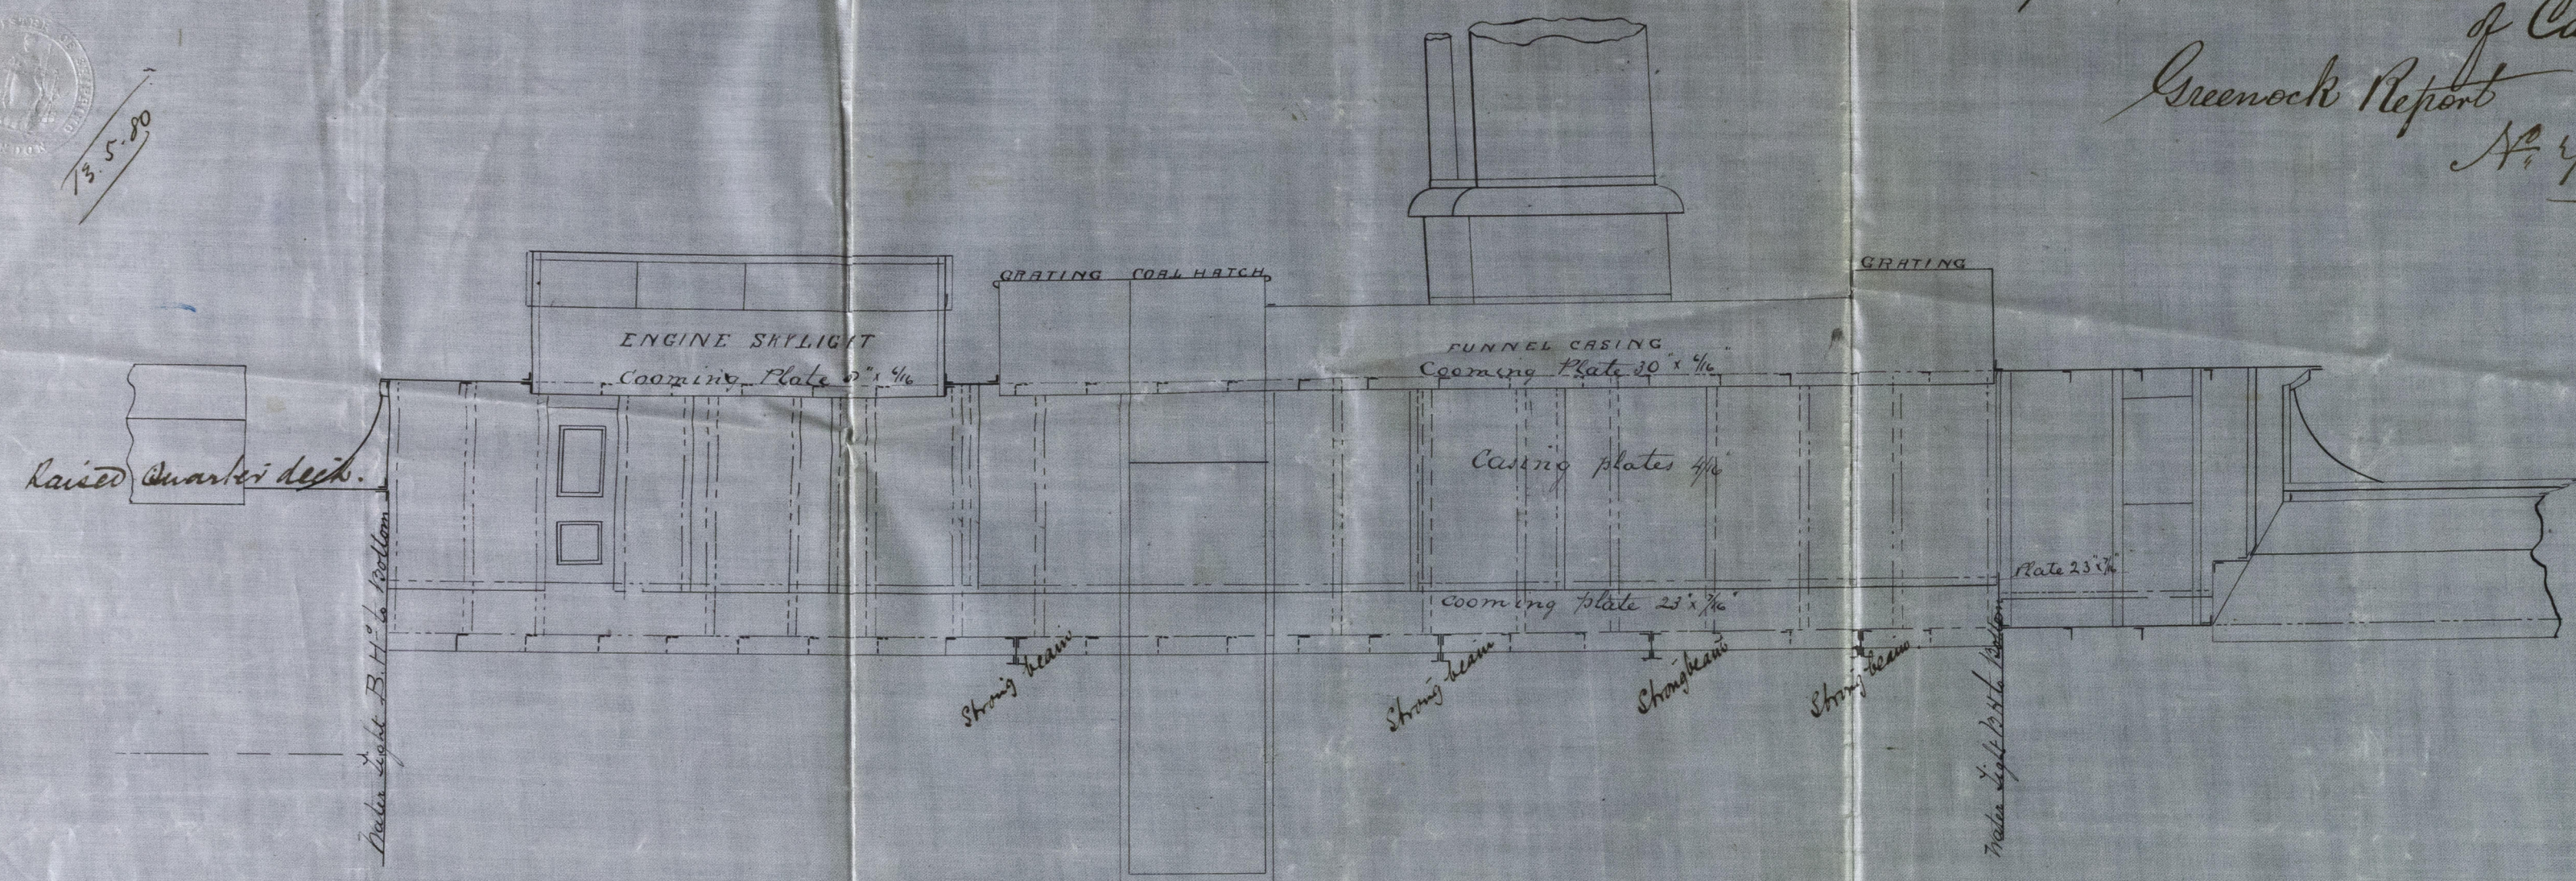

S. S. Advance of Cardiff
Greenock Report
N^o 4916.

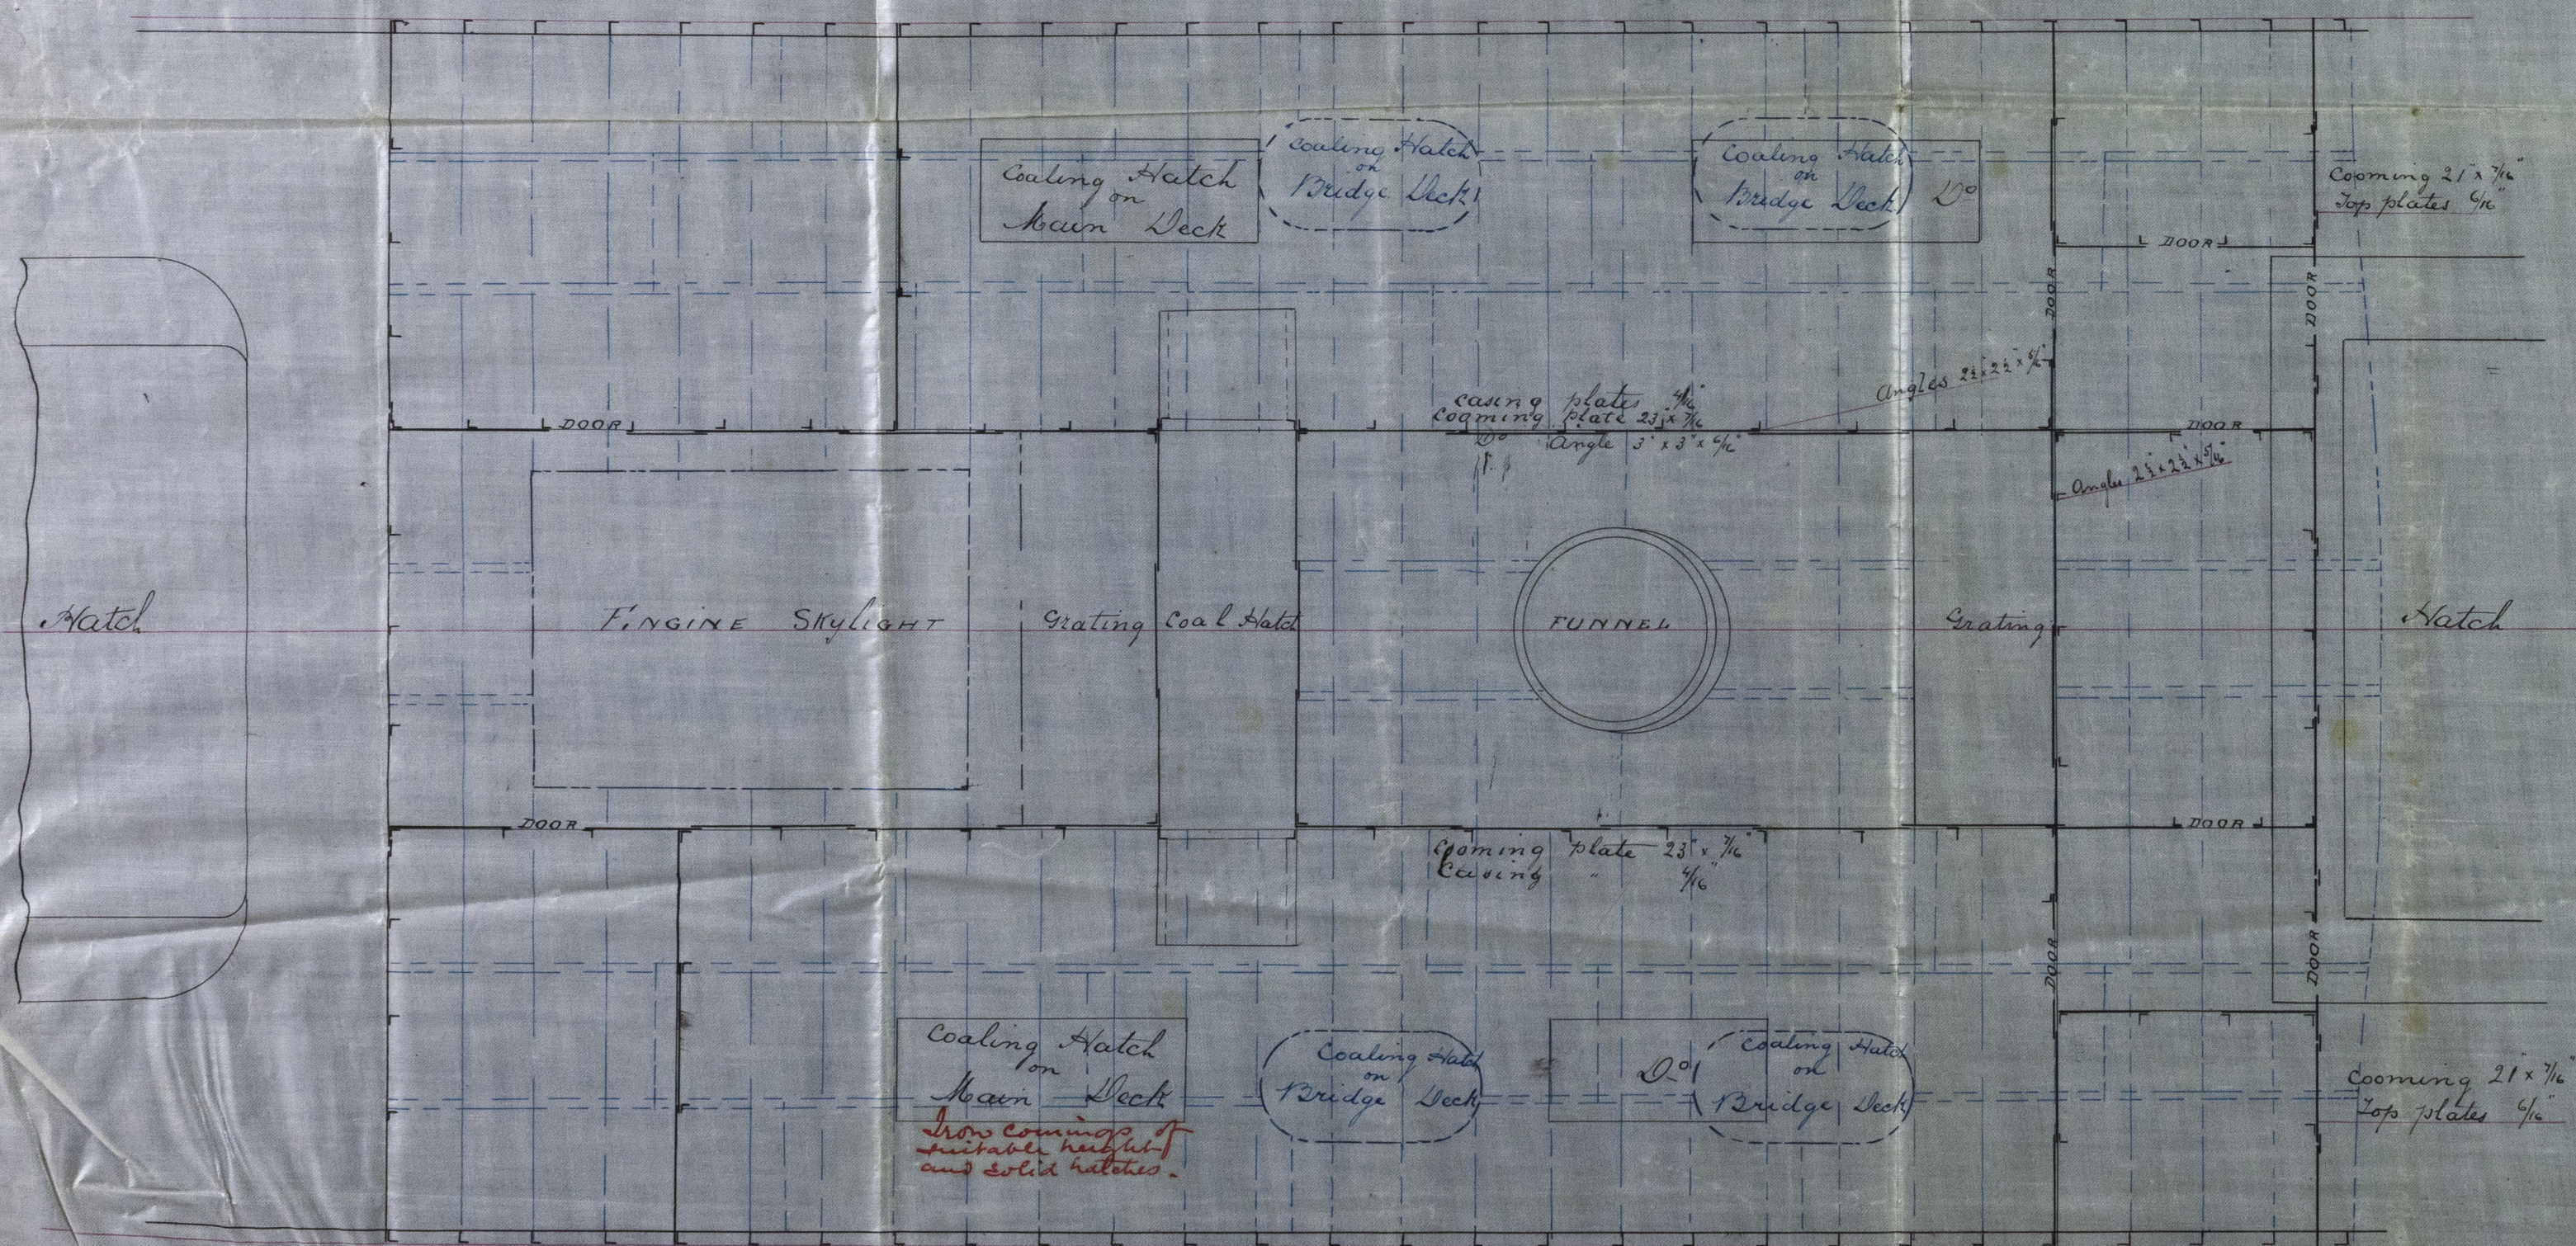

— BRIDGE BEAMS & PLATES IN BLUE —
— MAIN DECK & CASING IN BLACK —



— ARRANGEMENT OF ENGINE & BOILER CASING —
— BETWEEN MAIN & BRIDGE DECKS —
— S. S. N^o 151 —
— SCALE 1/4 INCH = ONE FOOT —
— ROBERT DUNCAN & CO —
— SHIP BUILDERS —
— PORT GLASGOW —
— 8/5/80. —

18th
13/5/80
J.H.