





S. S. N^o 107

S. S. "Sikh" 5256
Glasgow Report N^o 5256

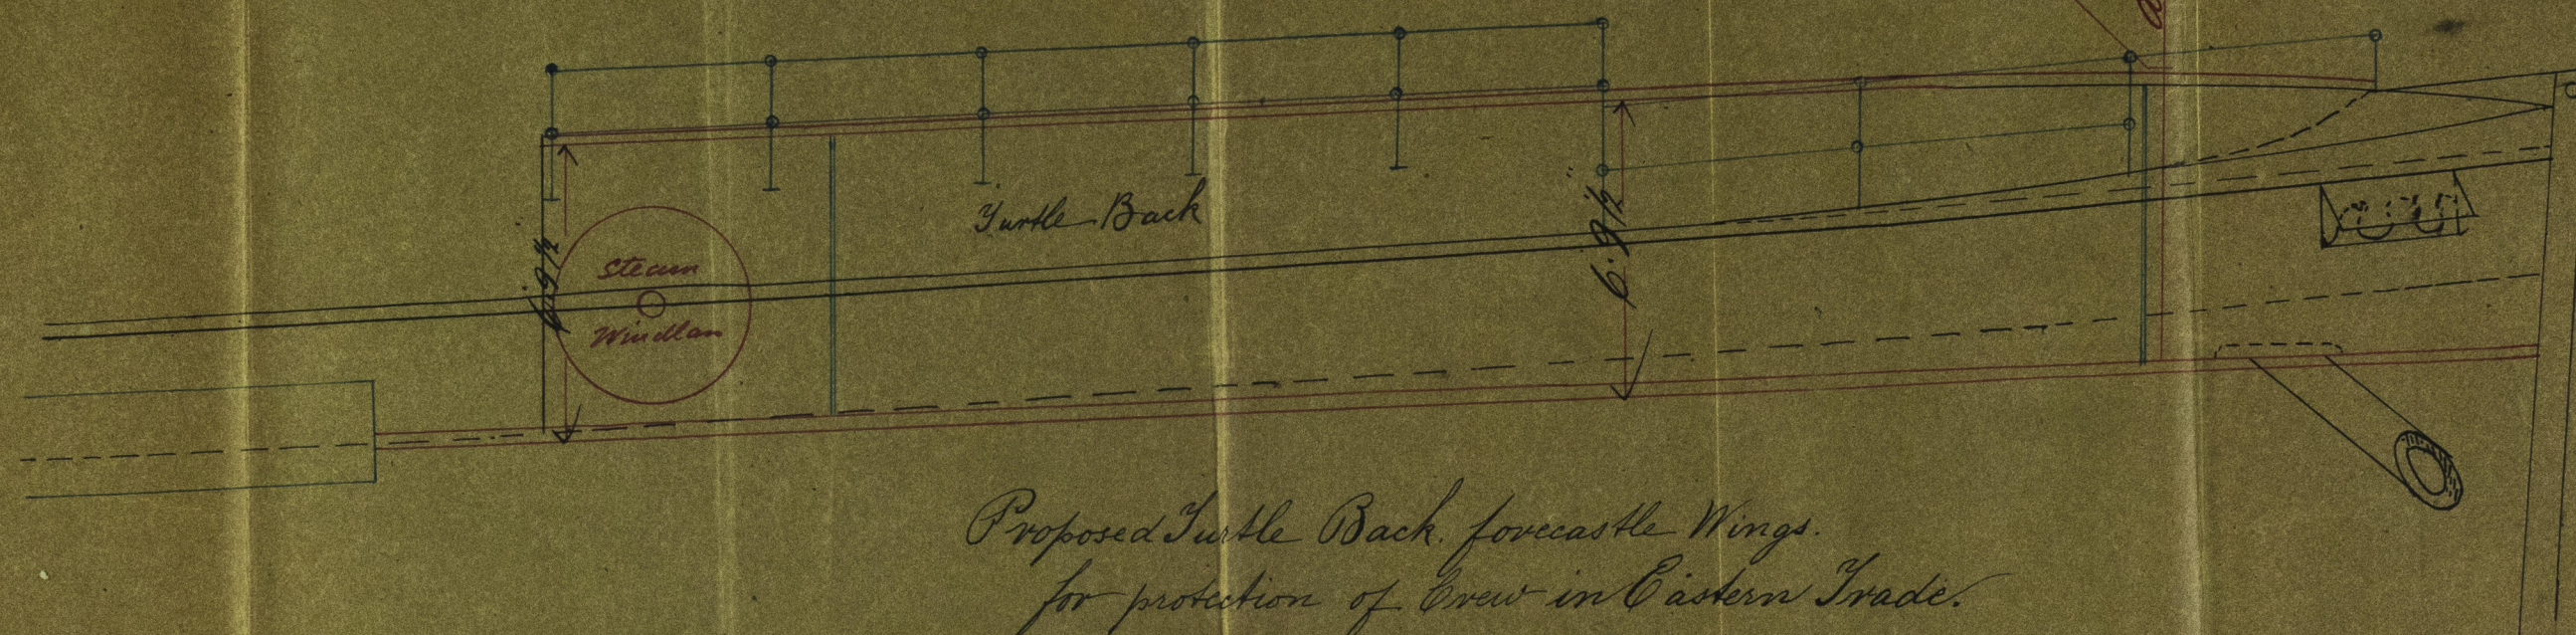

Proposed Turtle Back, forecastle Wings.
for protection of Crew in Eastern Trade.

Scale 1/4 of an inch = 1 foot.

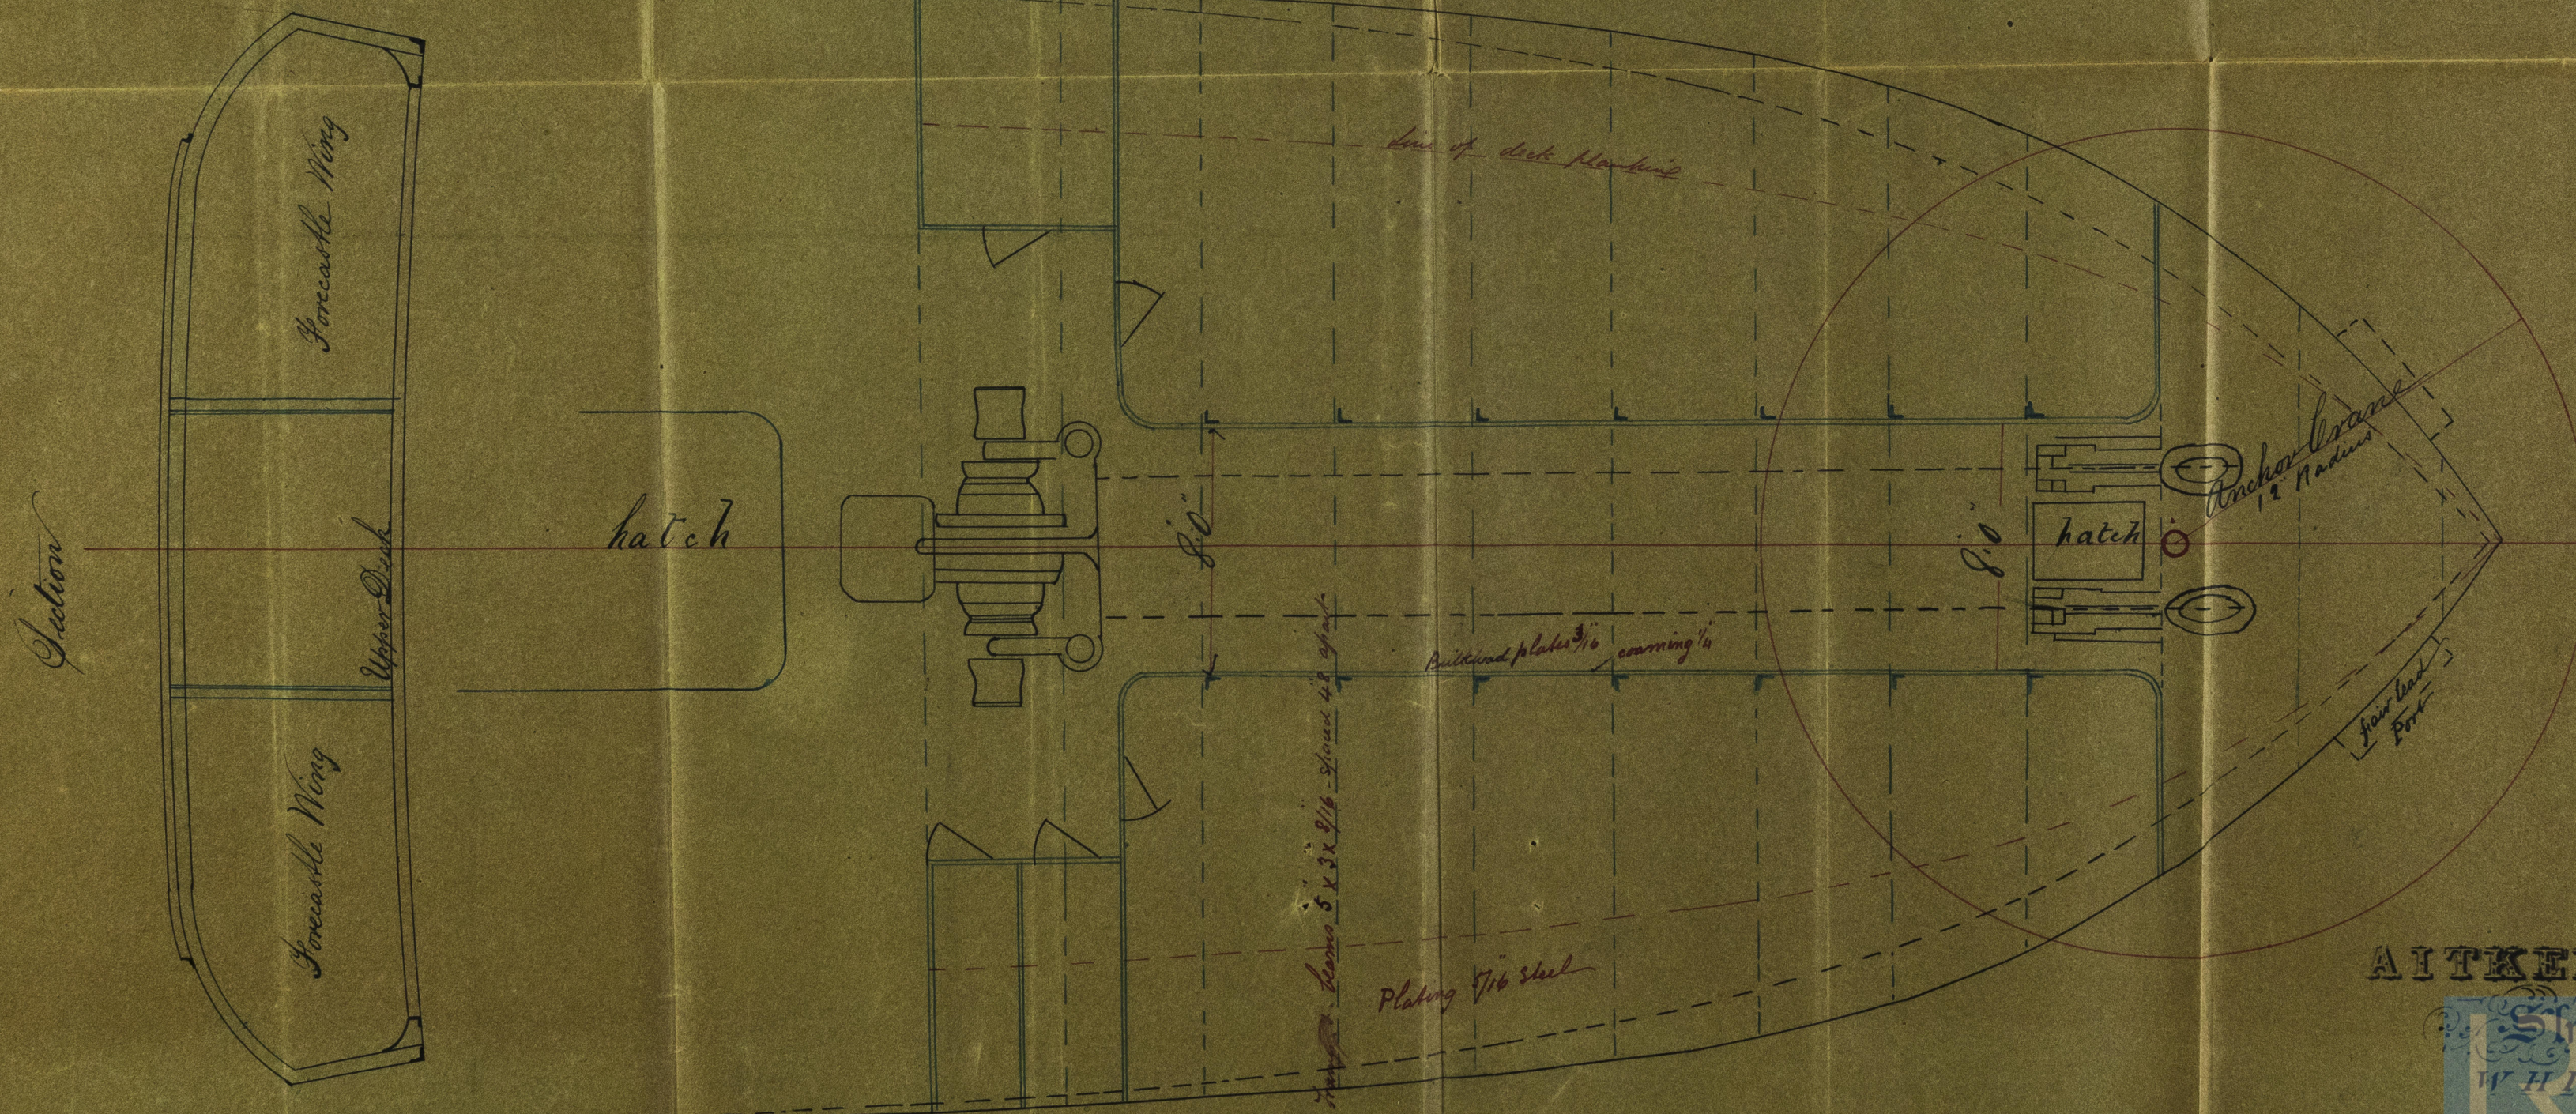

27/9/82

AITKEN & MANSELL

Shipbuilders
WHITEINCH
GLASGOW

IRON 547-0018