

Lt. H. L. 23/6/83.

New Schooner building  
at Sarsden by W<sup>m</sup> P. Linn.


Dimensions Length 88 feet  
do of Keel " 82 "  
Breadth Extreme " 21.4 mts  
Depth of Hold " 9.7 "  
Gross Tonnage (about) 100  
Room and Space 19 mts  
Floors Sides 8" moulded at Keel 9"  
First footboards sides 4" moulded 8" 2<sup>nd</sup> 4" 8 middle  
3<sup>rd</sup> and top timbers sides 6" moulded 5 3/4 10 5/4.  
Six pairs of long iron knee riders  
and English oak lodging knees  
Vessel to be salted for one year  
extra in Classification.

Submitted for 9 years Table A  
2 " Mixed material  
1 " Salt  
12 years

Liverpool June 20<sup>th</sup> 1883.

"Agnes Glover"

Liverpool Report No. 2909

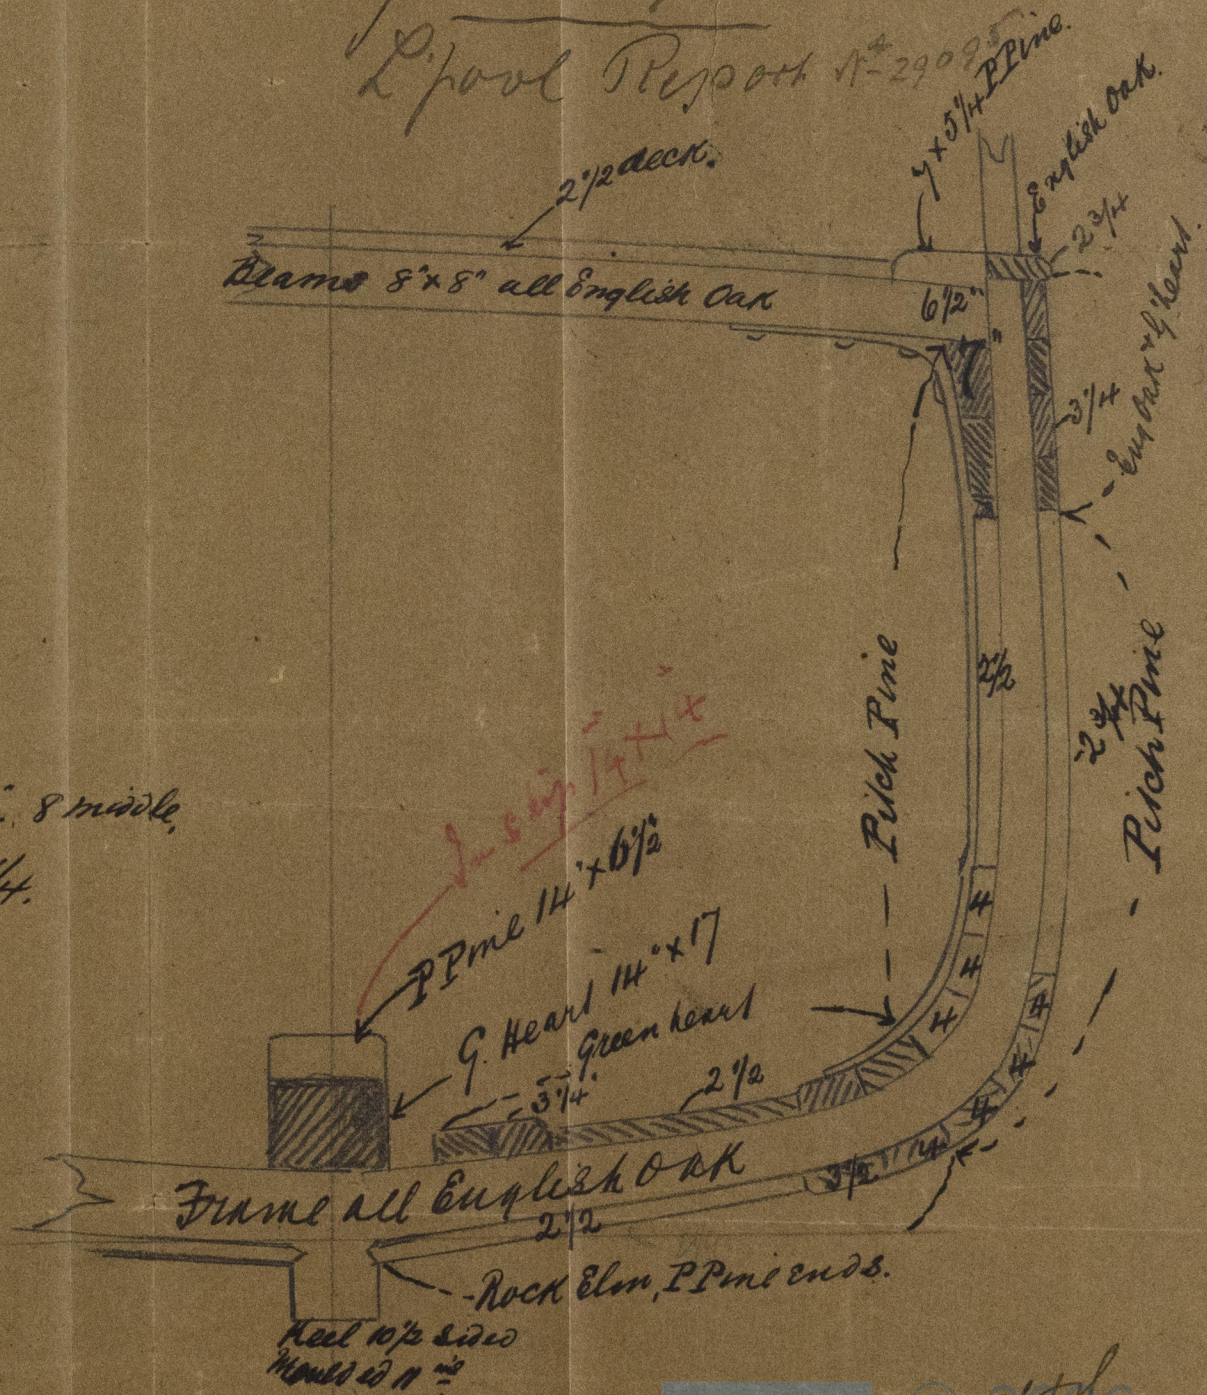

© 2010  
22/6/83  
Lloyd's Register  
Foundation

LWS86-0234