


L.H. & L.H.
 7/6/83.
 14/6/83

(SS) "Severn" Liverpool Report N^o 29378.

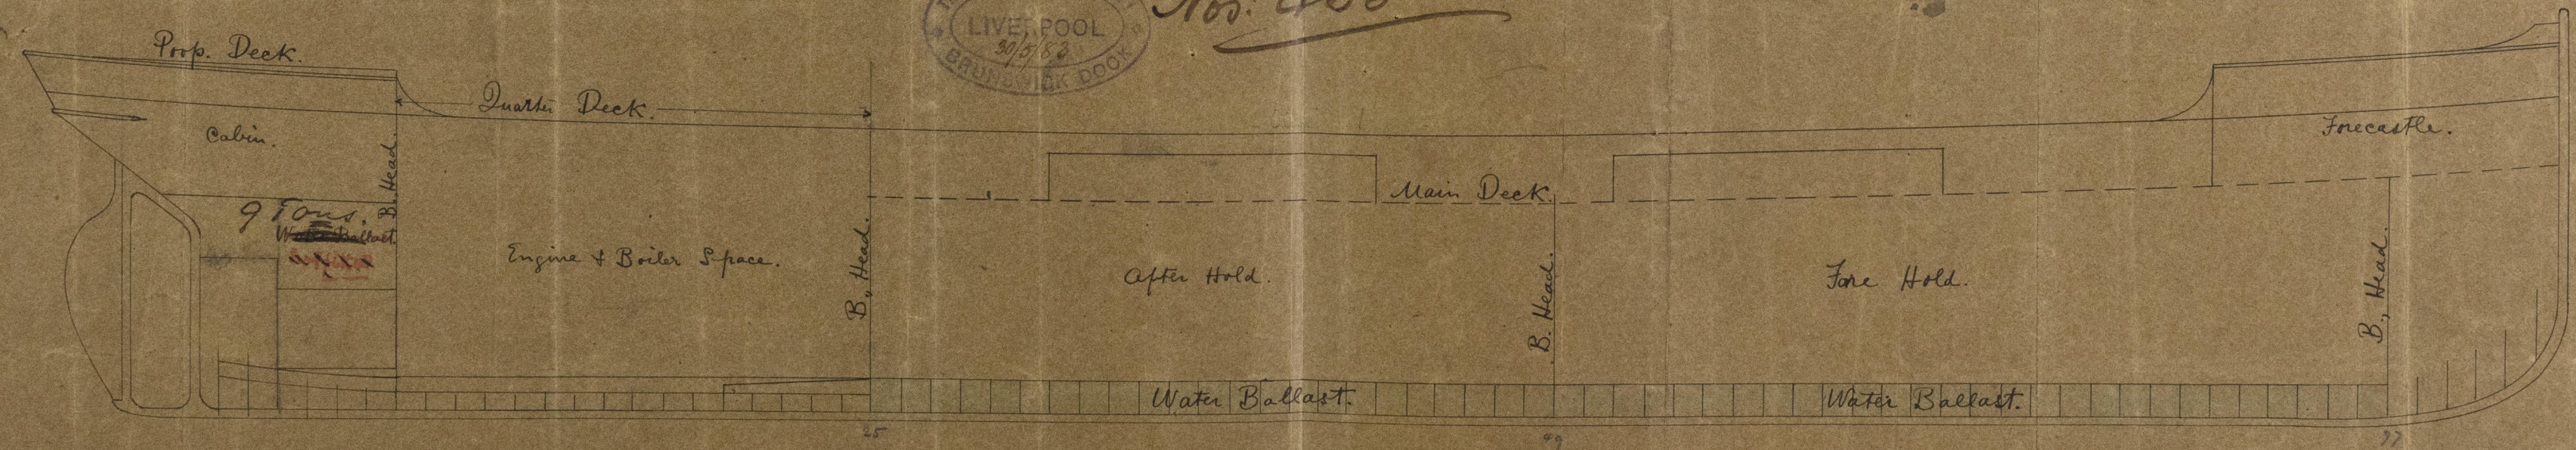

Nos: 455. S.



© 2021
 Lloyd's Register
 Foundation
 LN587-0023