

"Violent" Iron Paddle Wheel Passenger Steamer
Liverpool Reg. No. 29482 for the
Wallasey Local Board
To be classed 100A1 at Lloyds for Ferry Purposes

Plan shewing Bulkheads
dividing vessel into 12 Watertight Compart^{ts}

Boilers Engines Boilers

1 2 3 4 5 6 7 8 9 10 11 12

Dimensions	Length over all	150.0
	Breadth Moulded	26.0
	Depth do.	10.5




Scale $\frac{1}{2}$ of an Inch to the Foot

William Anson & Sons,
Engineers & Shipbuilders, &c.,
Preston.

Lloyd's numbers

Half Beam	13.00
Depth	10.9
H Girth	22.0
	<hr/>
	45.90 x 149 = 6839

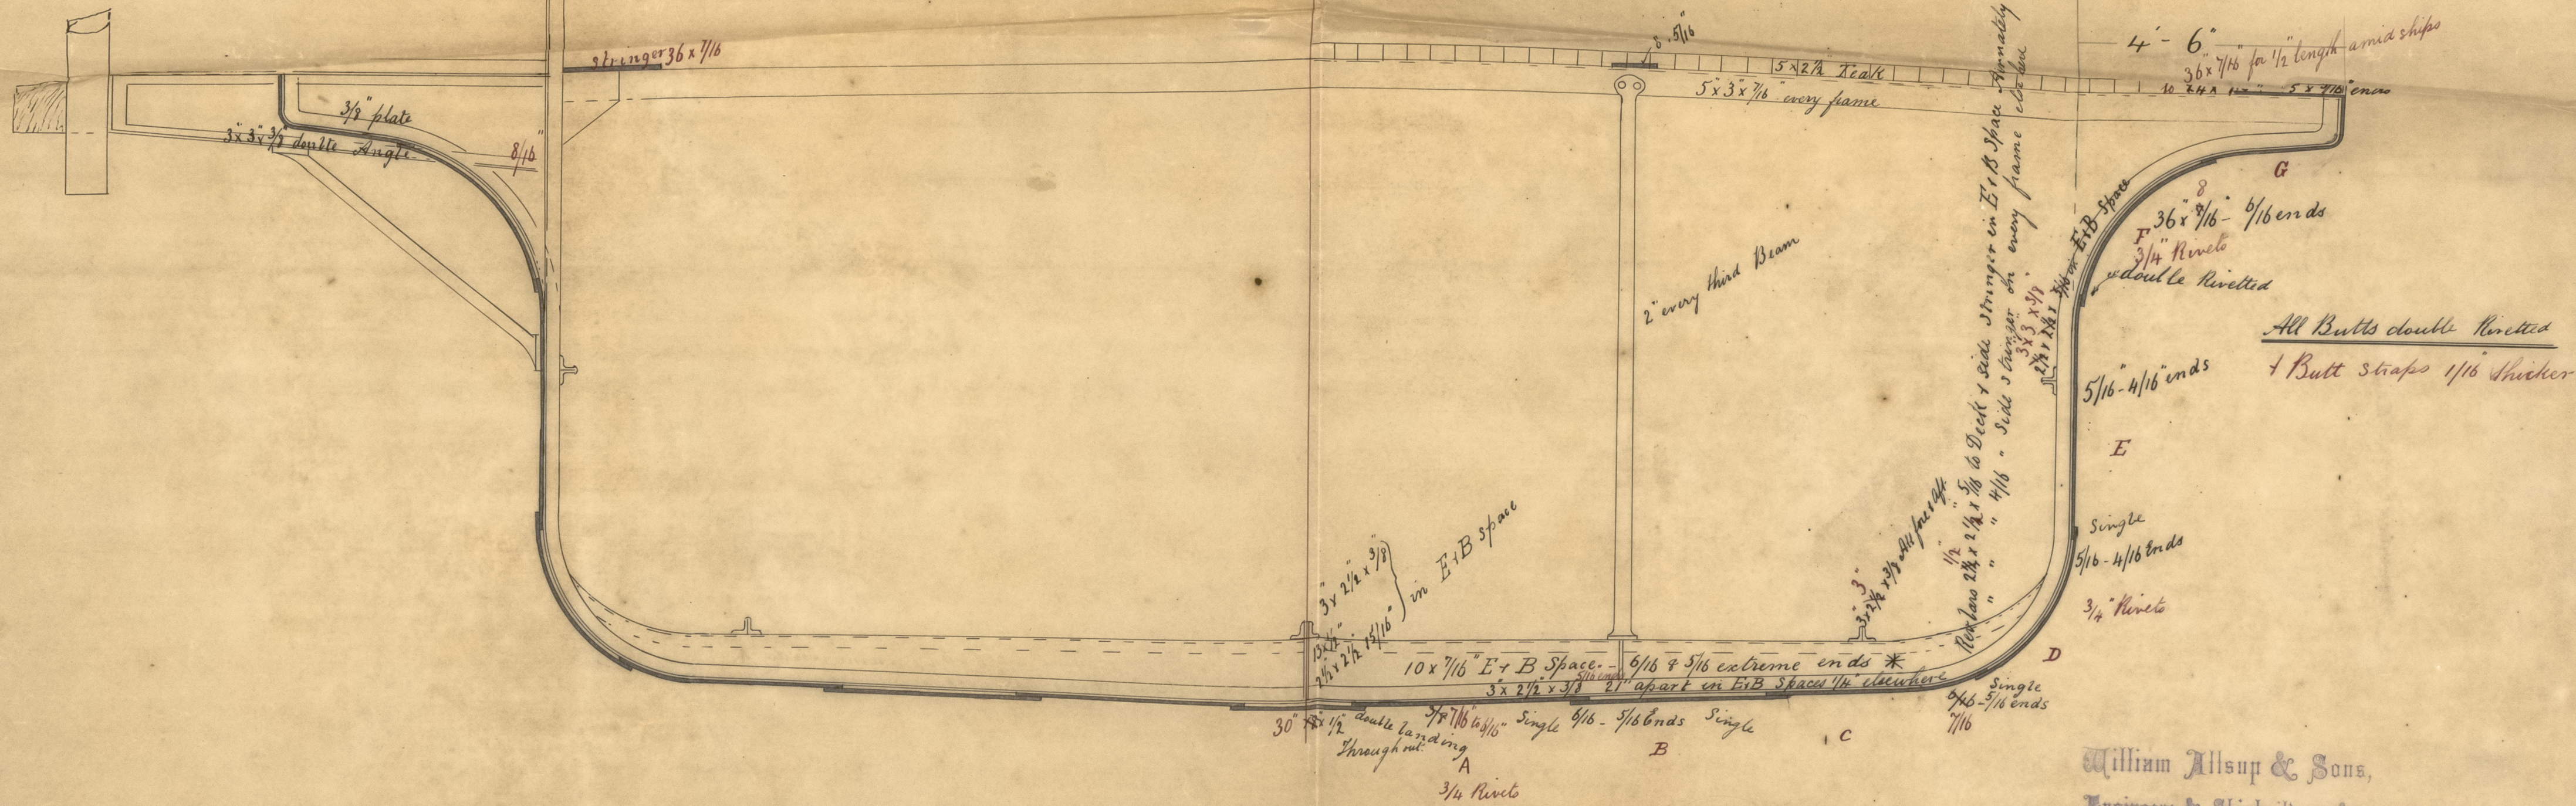

William Allsup & Sons,
Engineers & Shipbuilders, &c.,
Preston.

* N.B. Floors in "Primrose" & "Daisy" only $9 \times \frac{3}{8}$
Have reduced depth & increased thickness
because of Height for Boilers.—