

Lyons Report #29575


MIDSHIP SECTION N°229

Scale $\frac{1}{2}$ in. = 1 ft.

Thomas Royden & Sons
Iron Shipbuilders
Liverpool.
16/6/83.

Lib. & Liv.

30/6/83

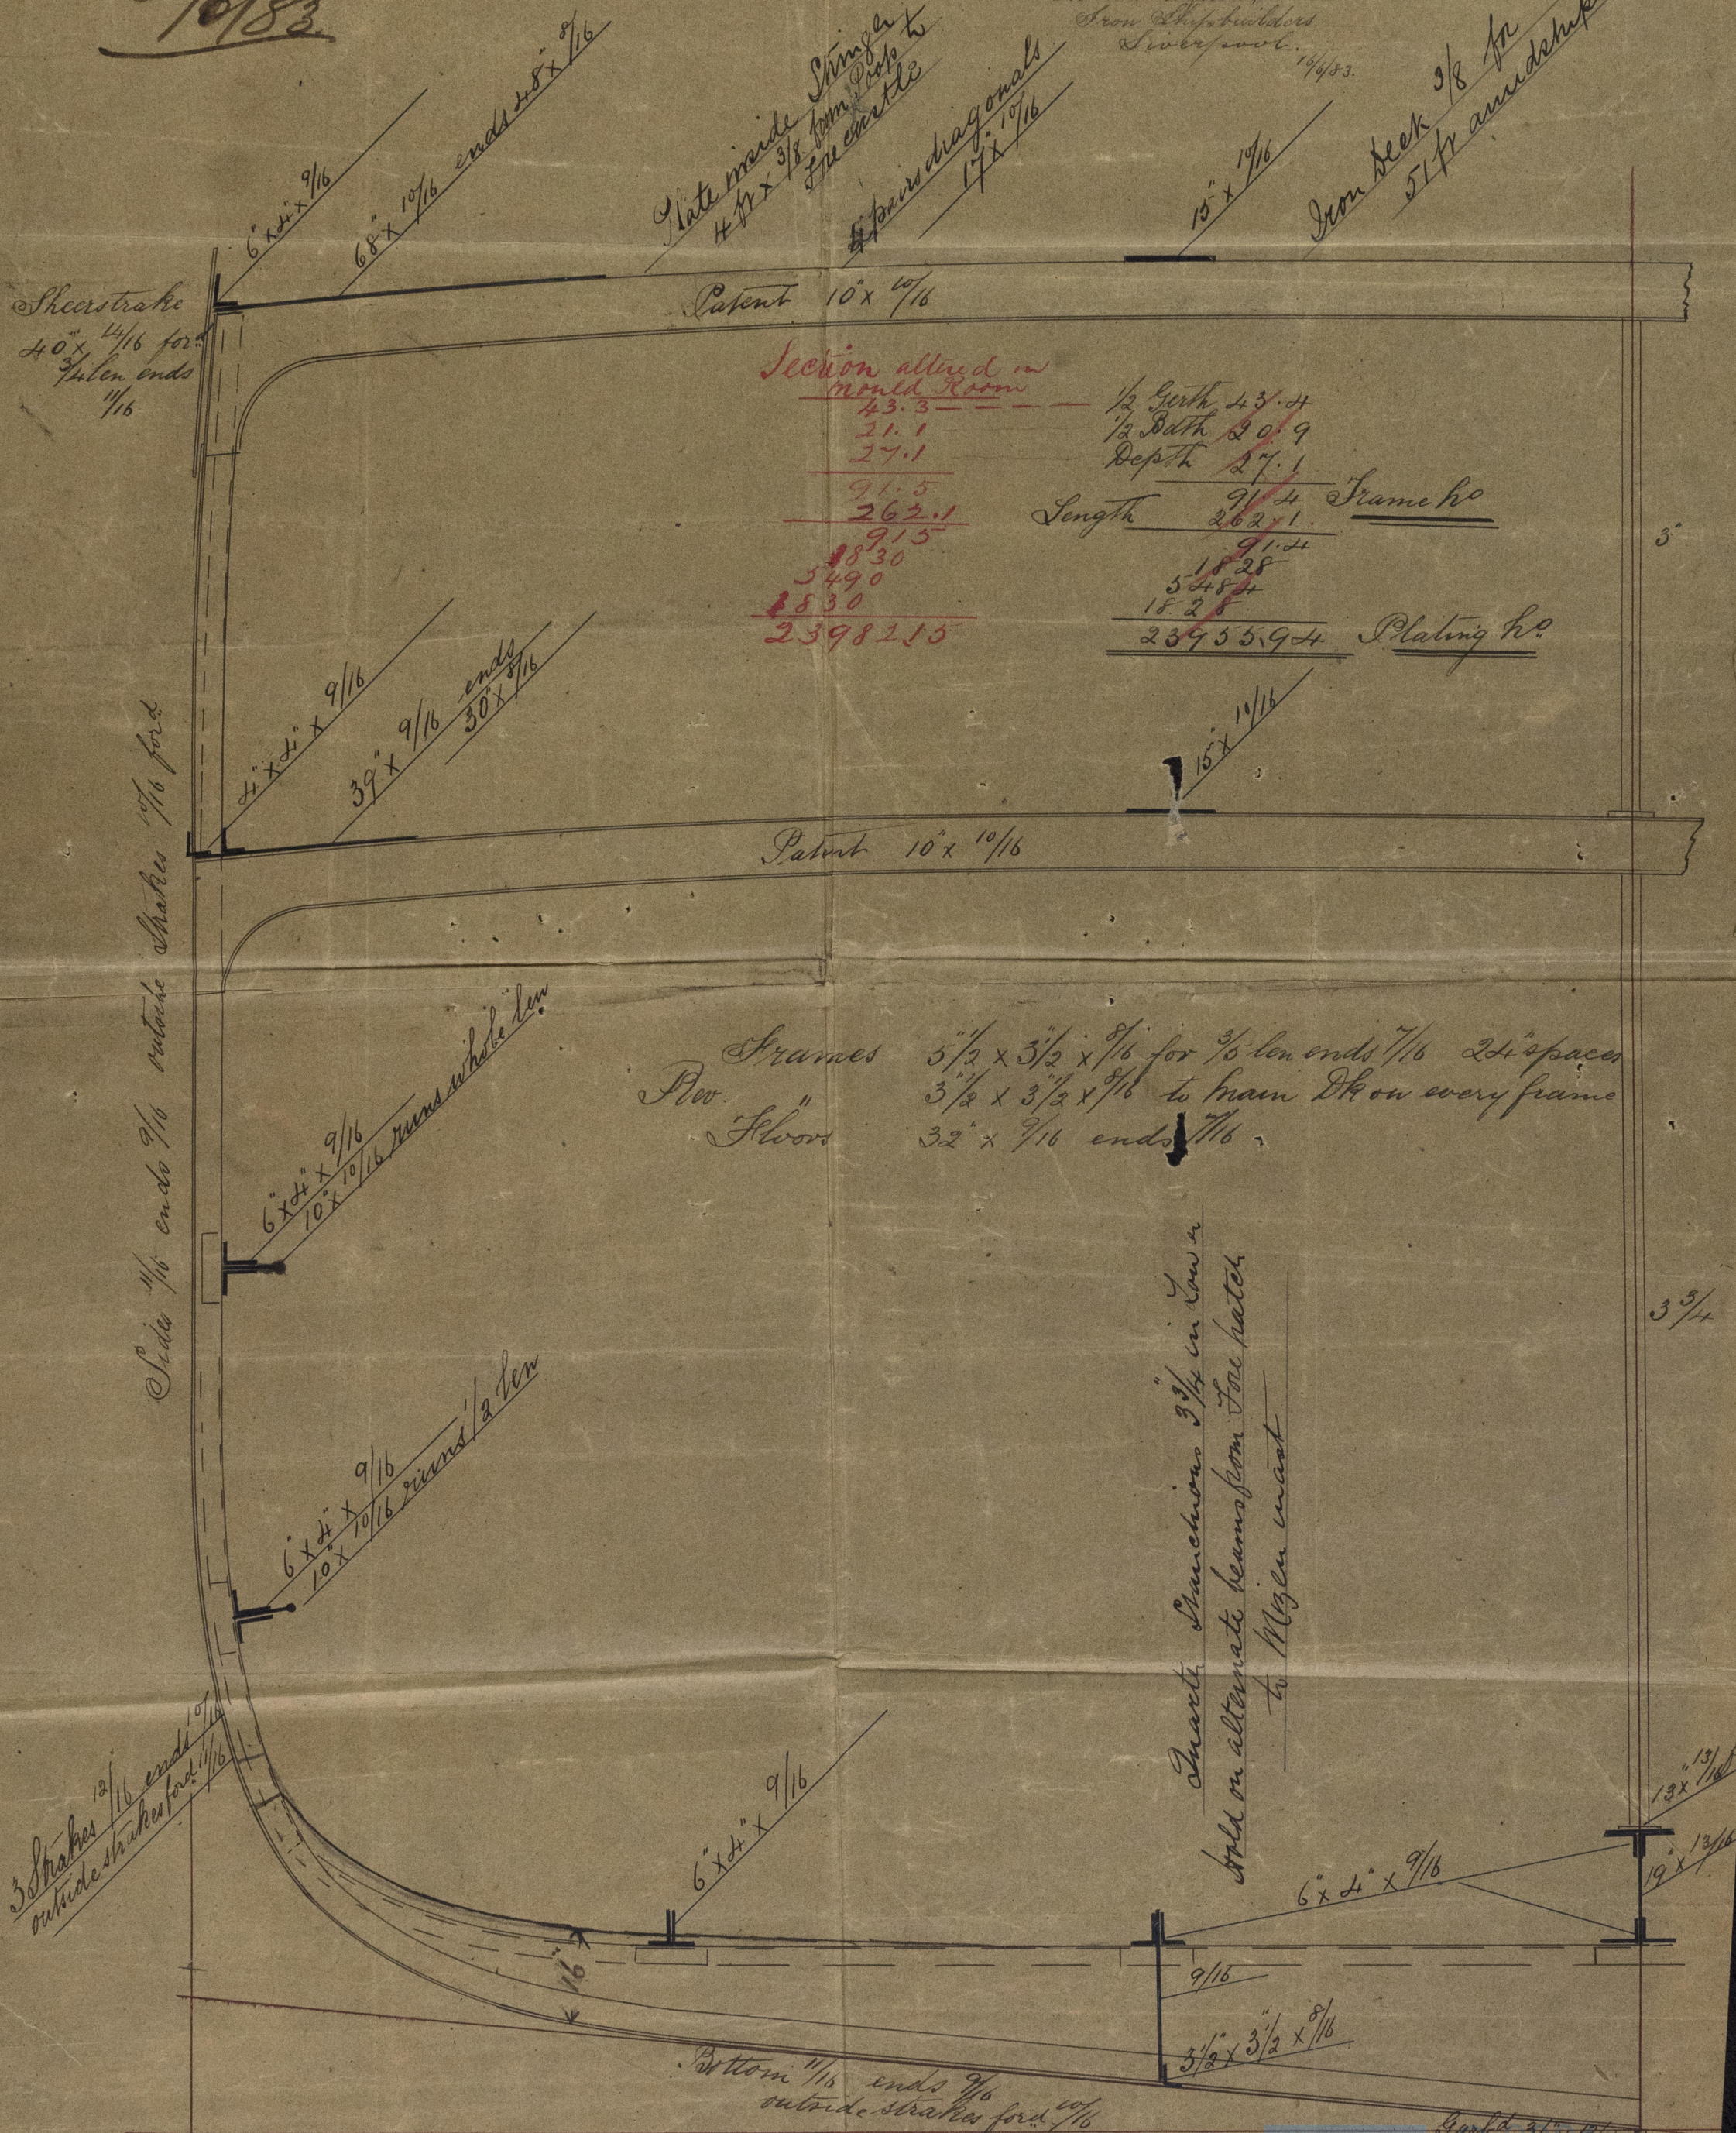

Butt straps of shear stake,
Deck stringer plates and
4 shapes of plating round
belts $\frac{1}{16}$ thicker than plates
and treble rivetted for $\frac{1}{2}$ len.

30/6/83

Keel Stem 10" x 6 3/4"
Sternpost 10" x 6 3/4"
Rudder Hd. 6 3/4" x 6 3/4"

LN587.0079