


Ensemble ⁴

2. Final Report

N^o 28846

Length as per Rule _____ 289'-0"
Breadth - - - - - 45'-0"
Depth in Hold - - - - - 24'-8½"

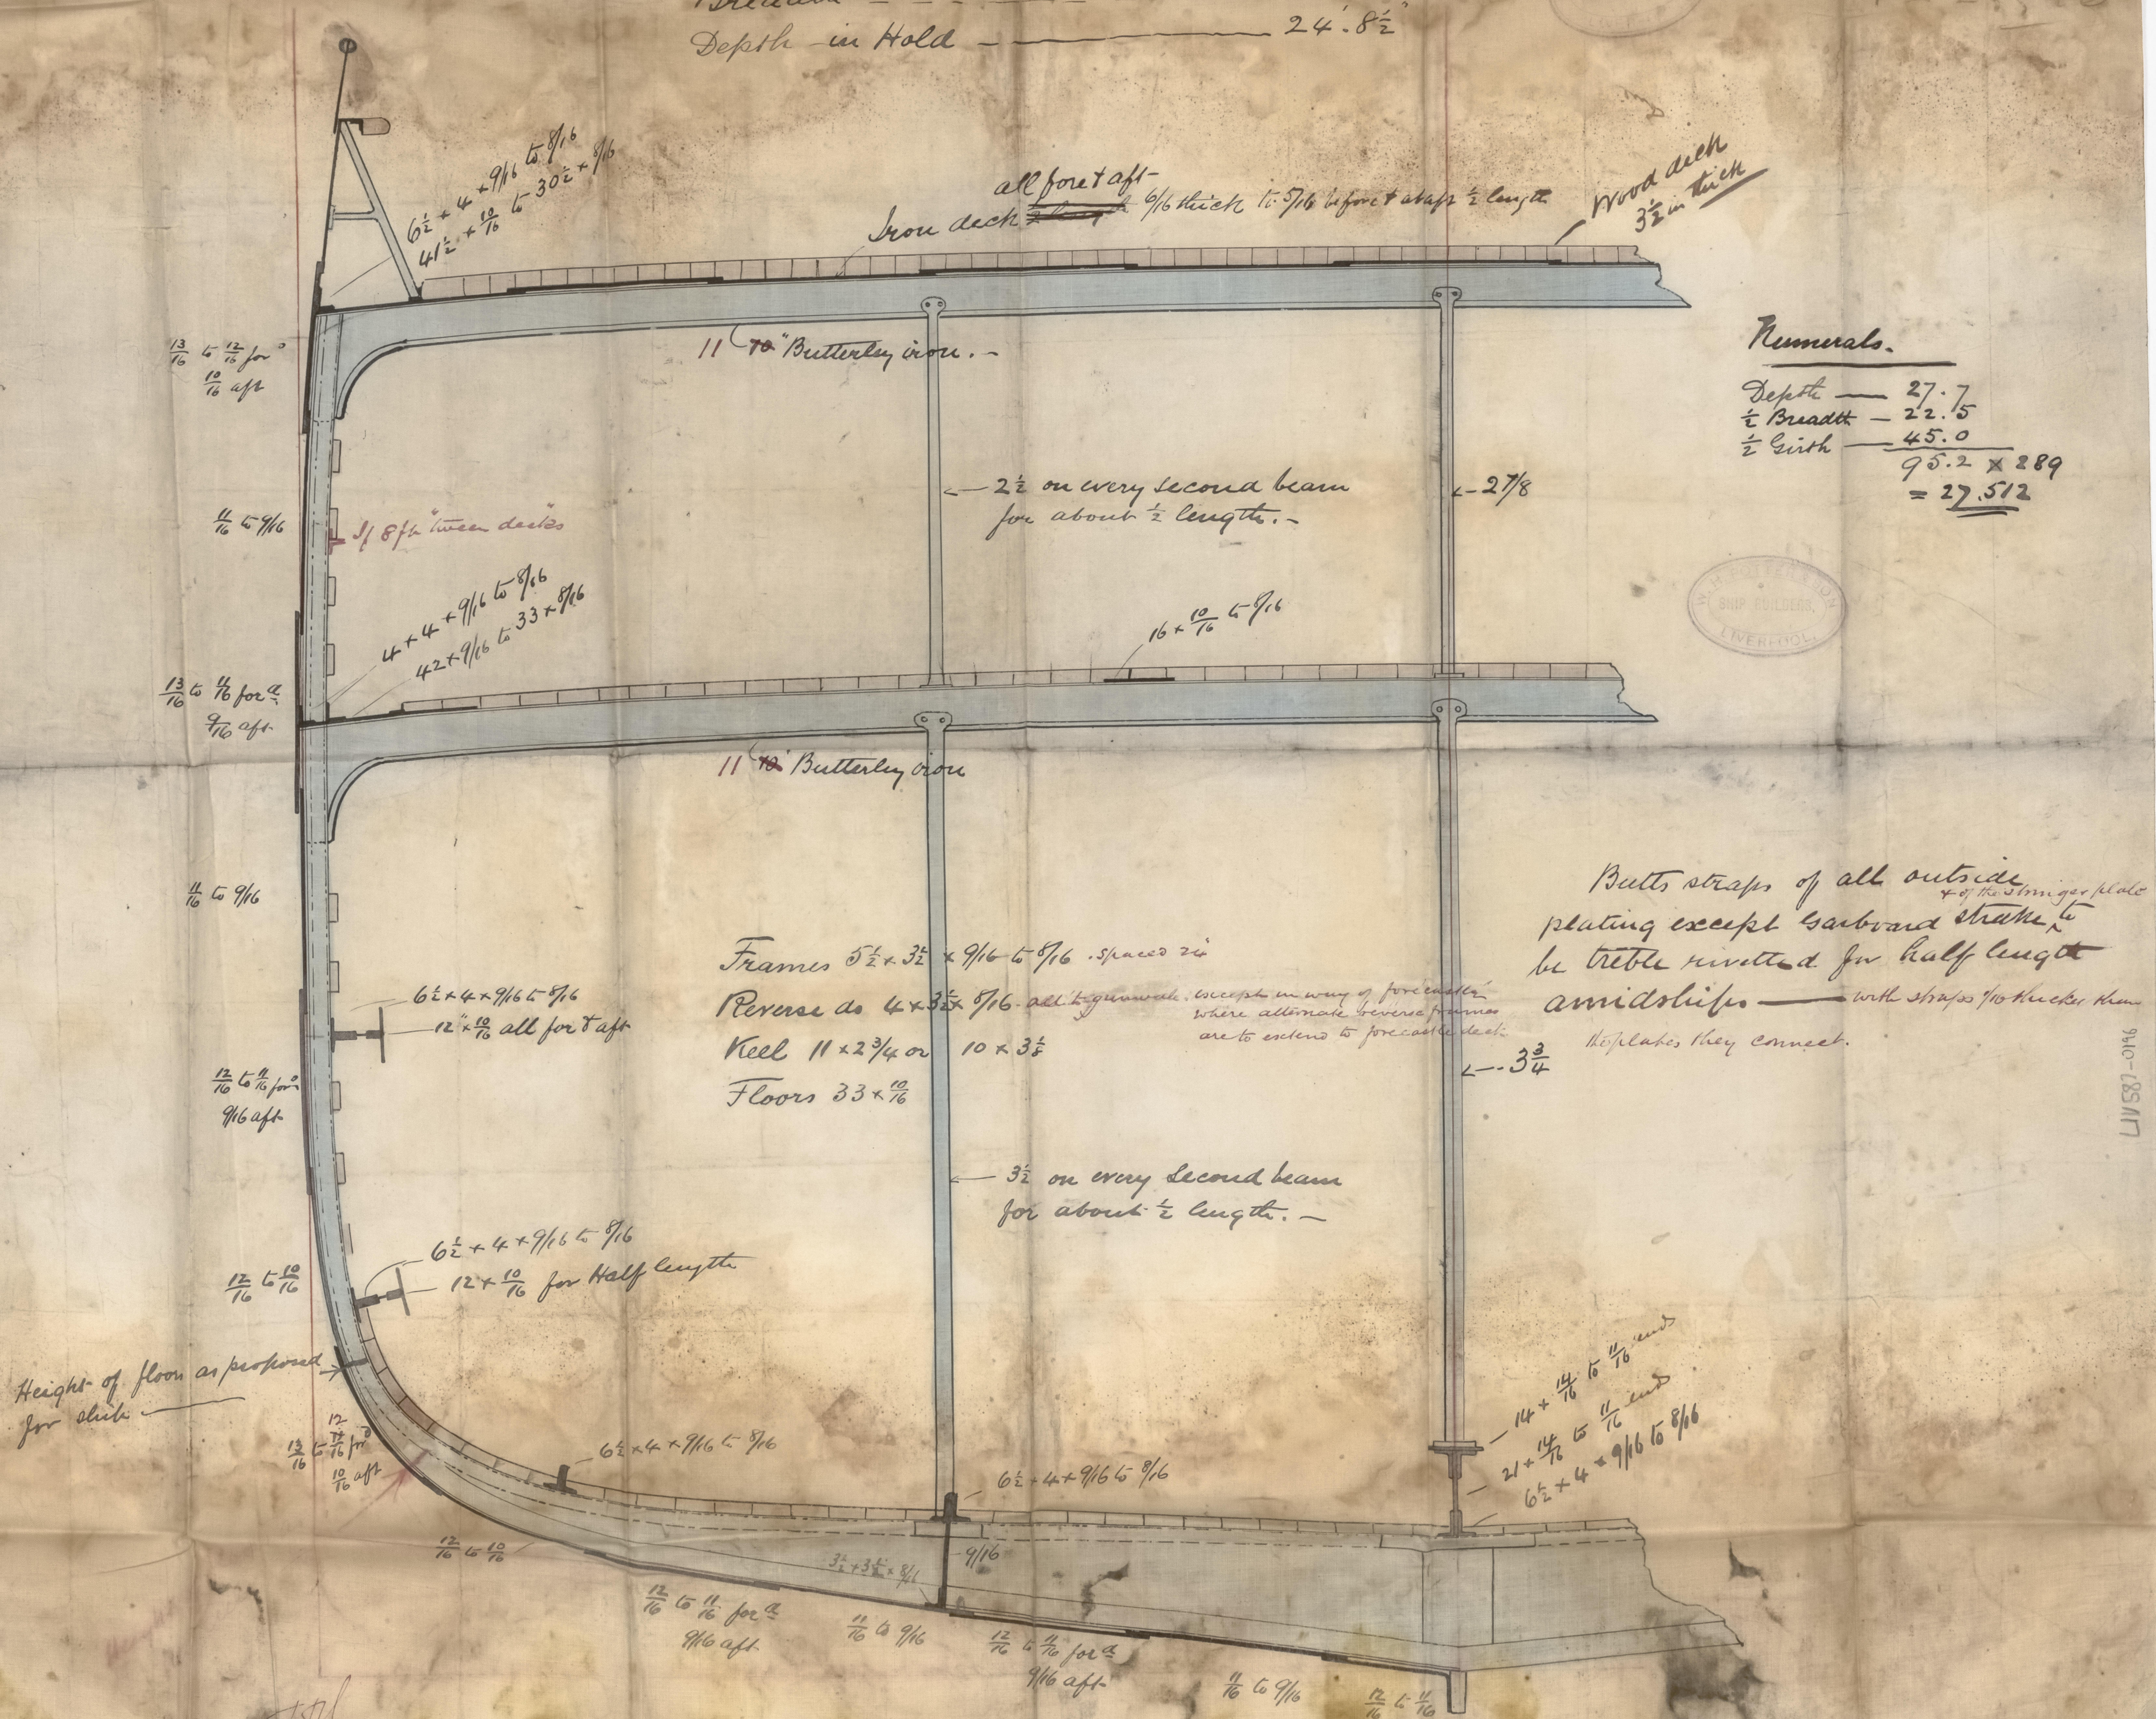

Numerals.

Depth — 27.7
 $\frac{1}{2}$ Breadth — 22.5
 $\frac{1}{2}$ Girth — 45.0

 95.2 \times 289
 = 27,512

Butts straps of all outside ^{4 of the stringer plate}
 plating except Garboard strake ^{to}
 be treble riveted for half length
 amidships. — with straps $\frac{1}{10}$ thicker than
 the plates they connect.

9610-68511