LIVS87-0198

No 103 "Crocus" Liverpool Report No 29975
No 104 "Snowdrop" Liverpool Report No 30126

New Double Twin Ferry Steamers
for Wallasey Local Board No 103 & 104

Scale 1/8" = 1 Foot.

Lt: to Liv: 17:1:84

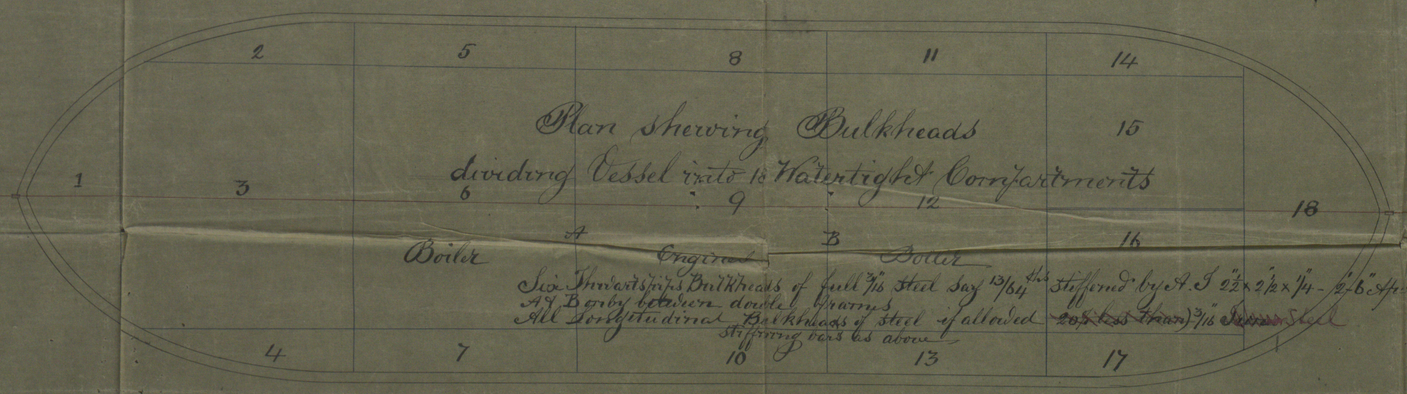

100 A1

Scale 1/2" = 1 Foot.

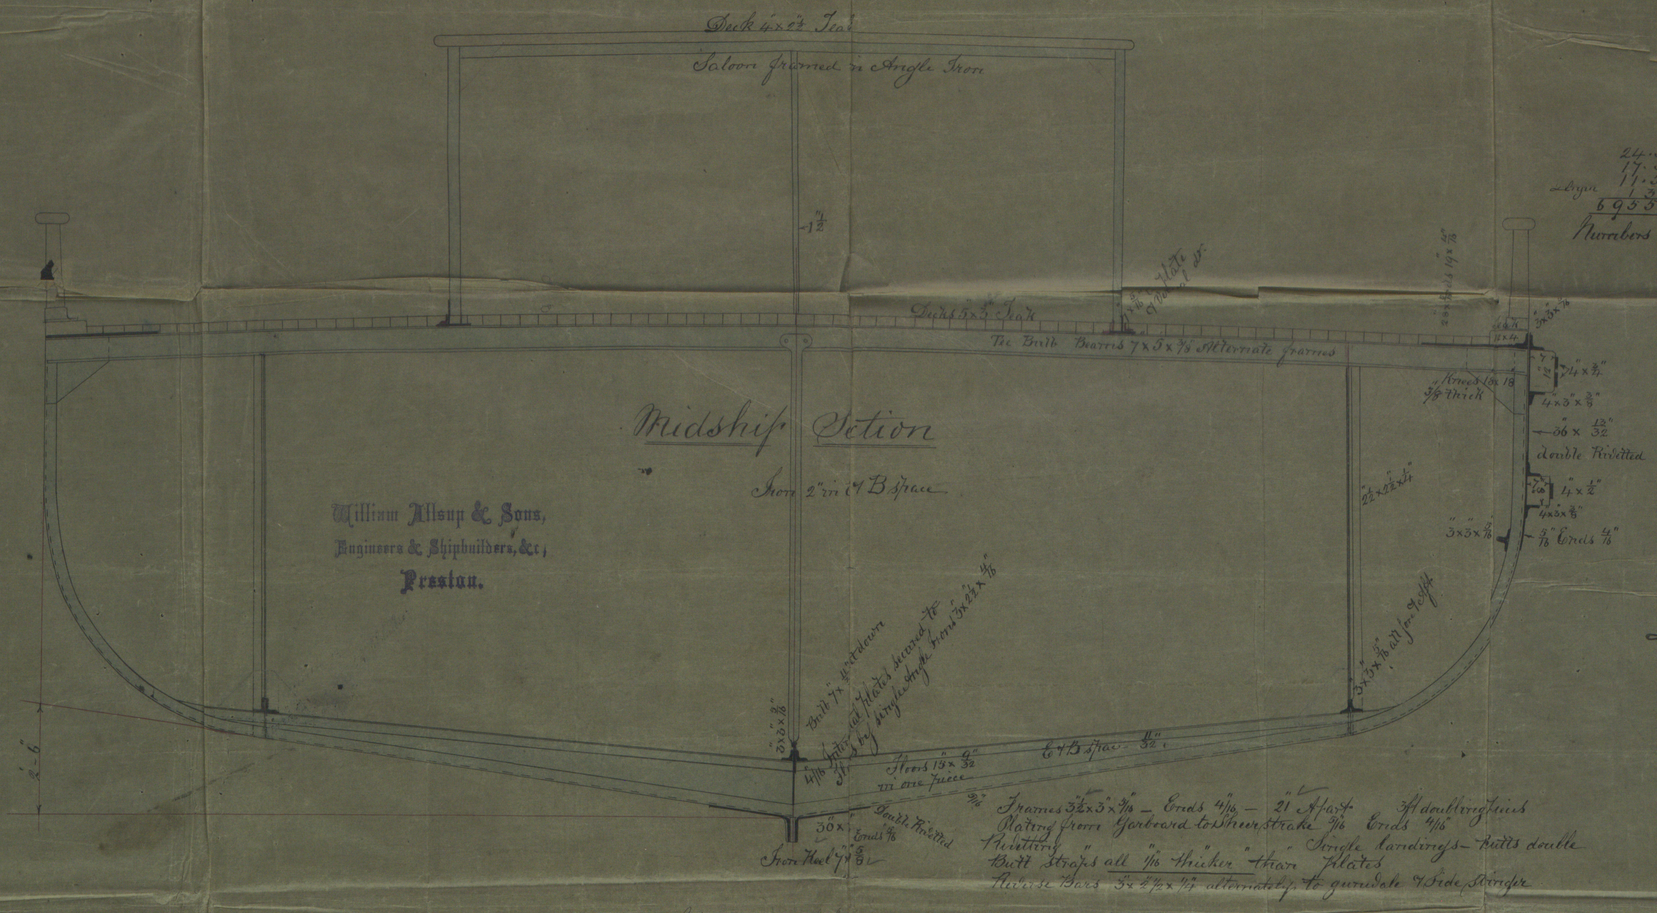

24.5 Half Girth
17.5 - H Beam
11.5 - Depth
Length 130
6955.0
Numbers for Scantling

Length over all 130 ft
Breadth Moulded 35 ft
Depth " 11.5"

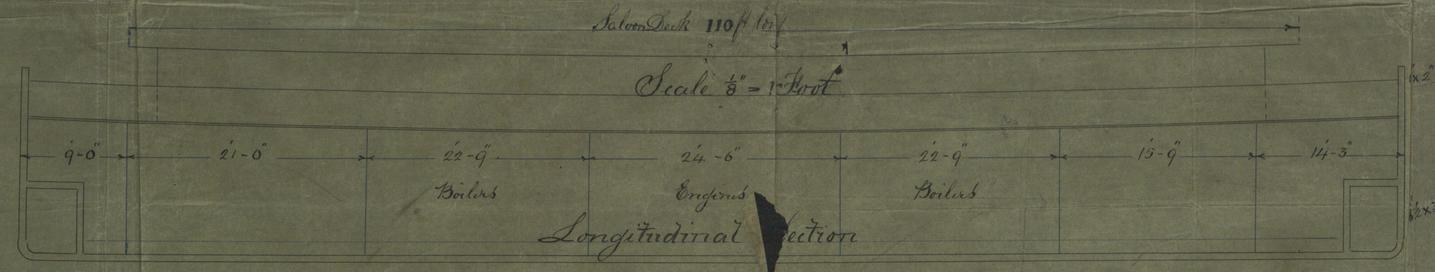

William Allsup & Sons,
Engineers & Shipbuilders, &c,
Preston.

Lt: to Liv: 9/1/84

J Johnston
Chairman Wallasey Local Board
Liverpool 18 January 1884

J M
18/1/84

These Plans & Scantlings are in accordance with the requirements of the Wallasey Local Board for the Lloyds Certificate of Class 100 A.1. for Ferry Purposes subject to Rules of Lloyds being worked to in their respects for said Certificate.

Flannery & Fawcus
11/12/83