



LIVERPOOL N° 30295

Midship Sect: N° 118

Scale $\frac{1}{2}$ inch = one foot




Proposed Bilge & Le Bidge Ribs shown in red

and also Quarter Stanchions.

Lt. & Sir.



4/9/84

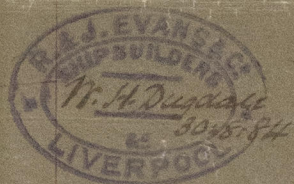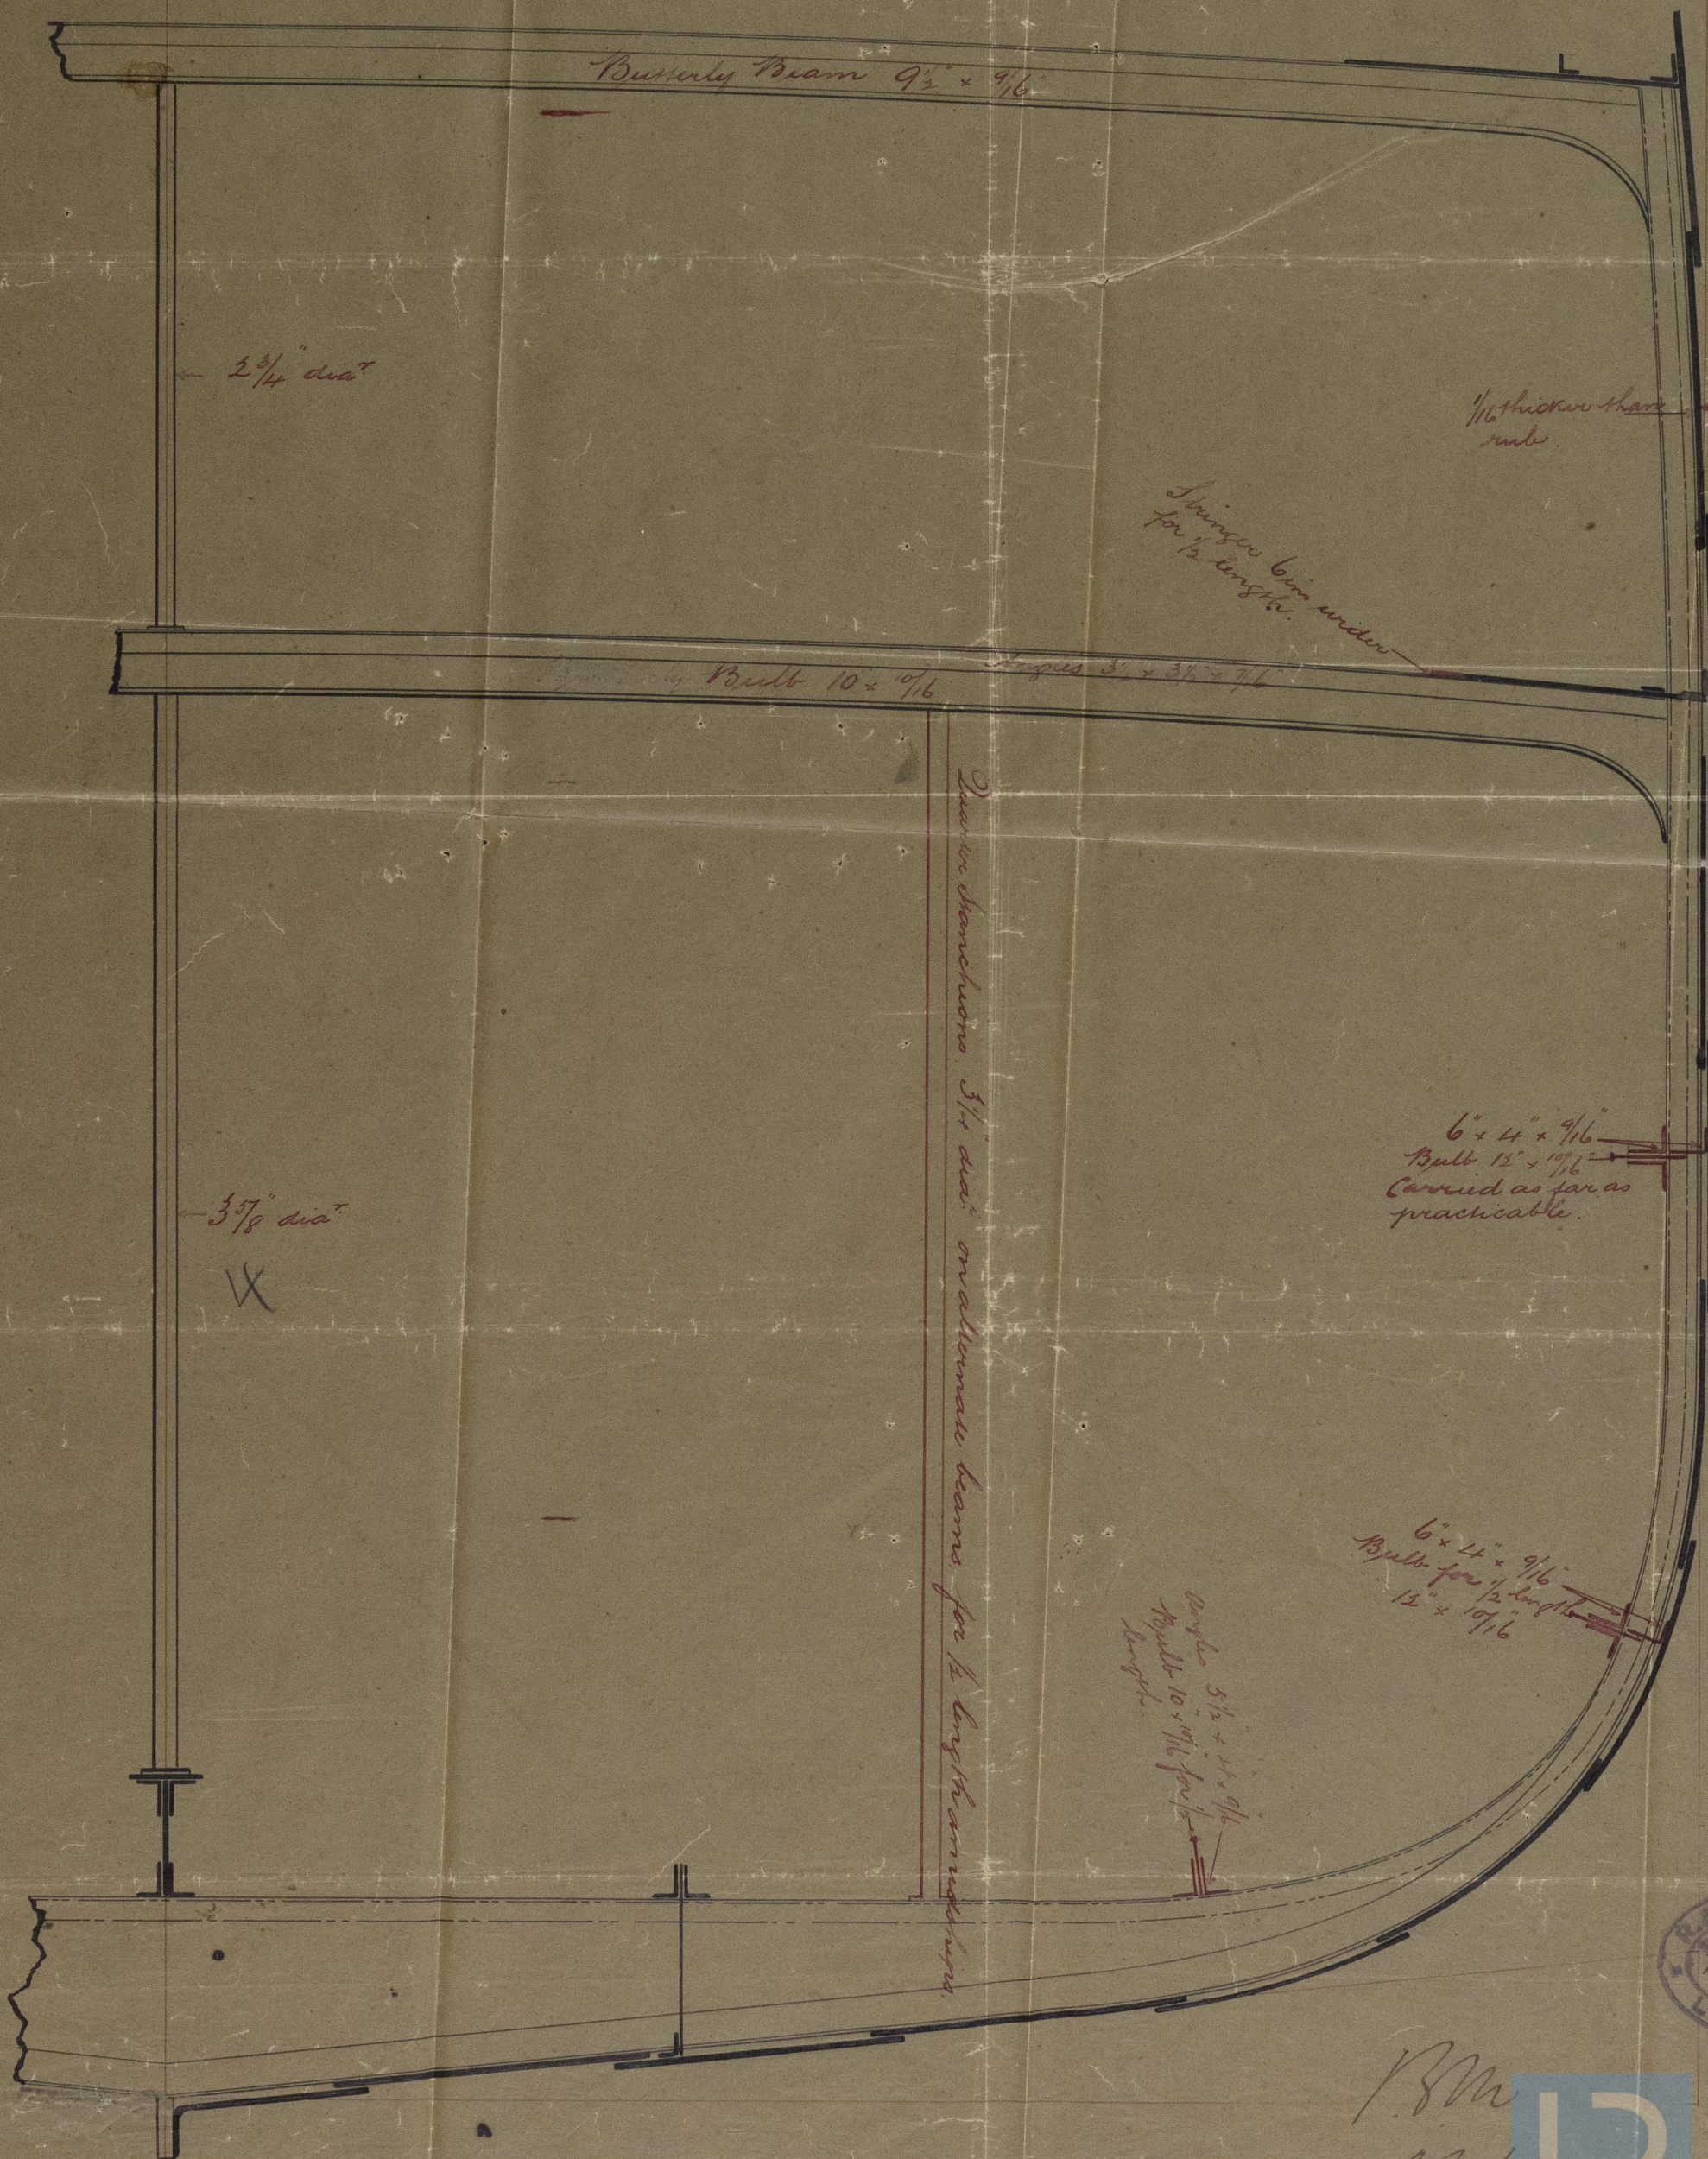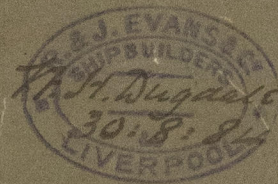

1800

3/9/84



© 2021

Lloyd's Register Foundation