


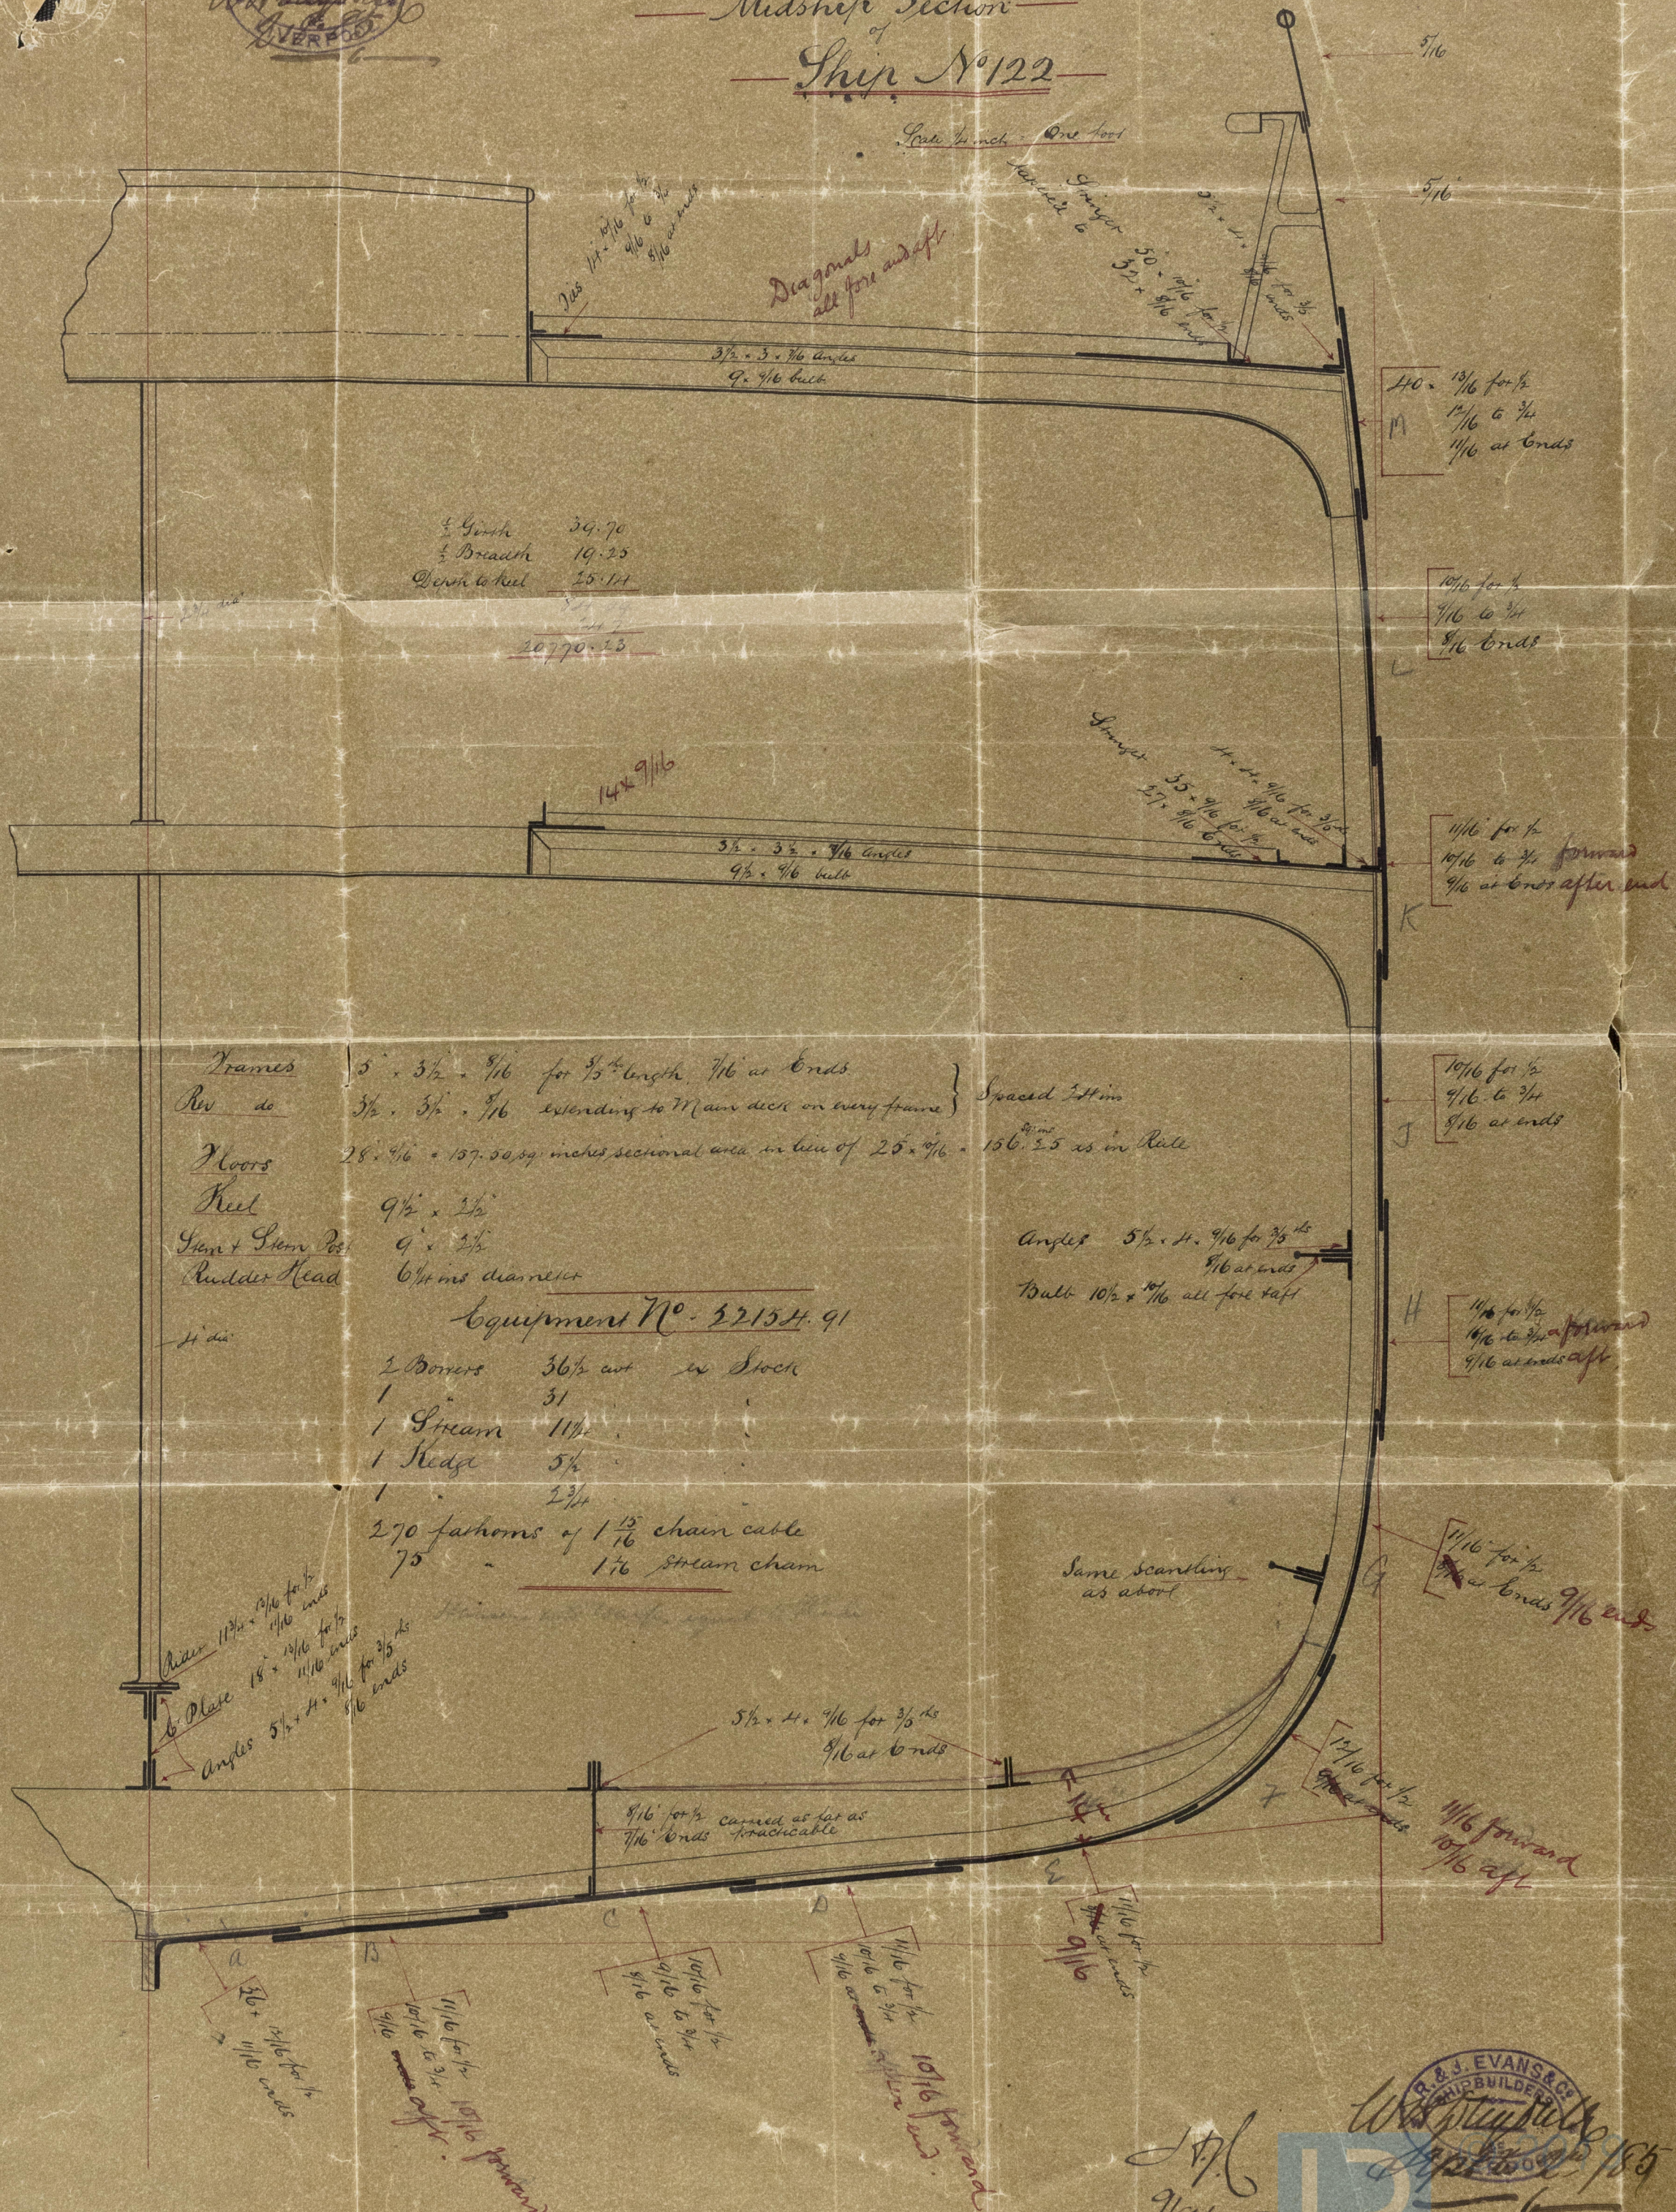

Midshep Section
Ship No 122



Lloyd's Register
Foundation

LIV 588-0034