

17/12/85.

# No 124 Midship Section

Scale  $\frac{1}{2}$  in = one foot


Length as per Lloyds. — 264'-0"  
Breadth moulded — 39'-9"  
Depth in hold — 24'-0"

3-12-85

Ship "Wayfarer"  
Liverpool Report No 31583

1 to 2  
To be substituted  
for 1 to 1

$\frac{3}{8}$  iron deck amidships for a length of about 56 feet amidships tapering to about 90 feet at stringer. — Diagonals forward and aft of this.

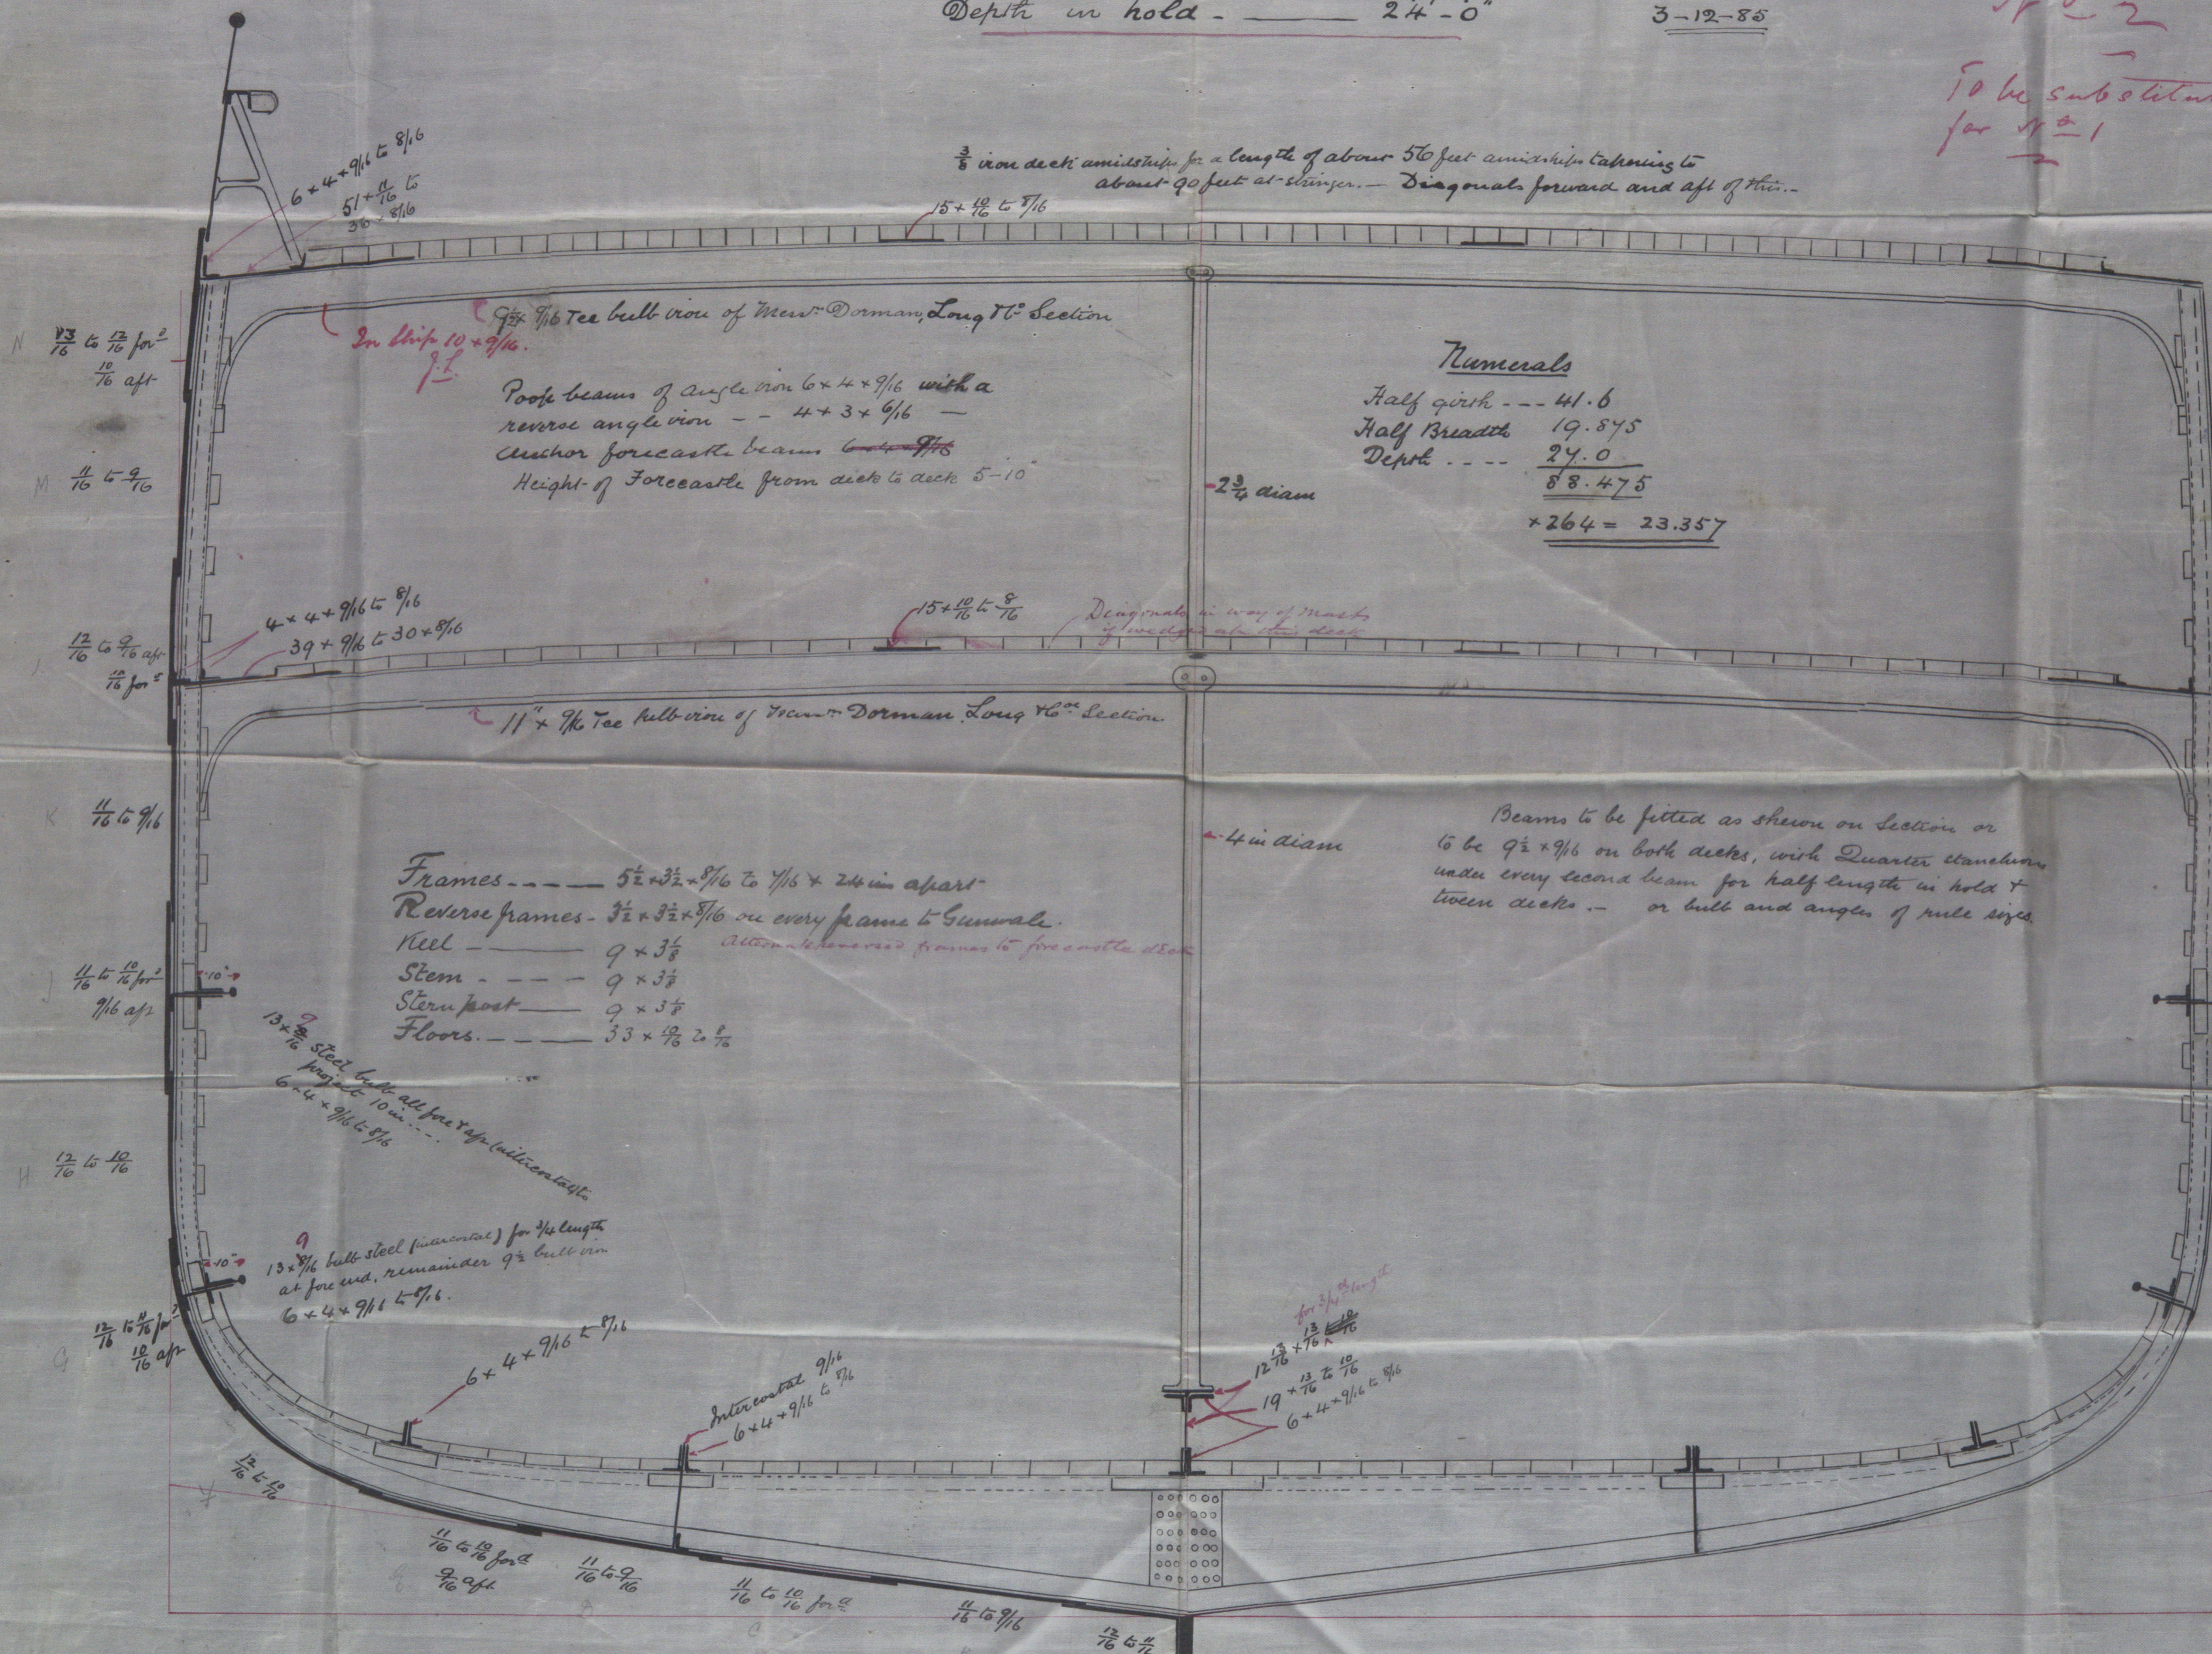

## Numerals

Half girth --- 41.6  
Half Breadth --- 19.845  
Depth --- 24.0  
88.475  
x 264 = 23.357

Beams to be fitted as shown on section or to be 9 1/2 x 9/16 on both decks, with Quarter clankers under every second beam for half length in hold & tween decks — or bulk and angles of rule size.

17/12/85