


2/10/86.
2/12/86
16/12/86.

Midship Section
From Ship No 123

Scale $\frac{1}{2}$ inch = One foot.

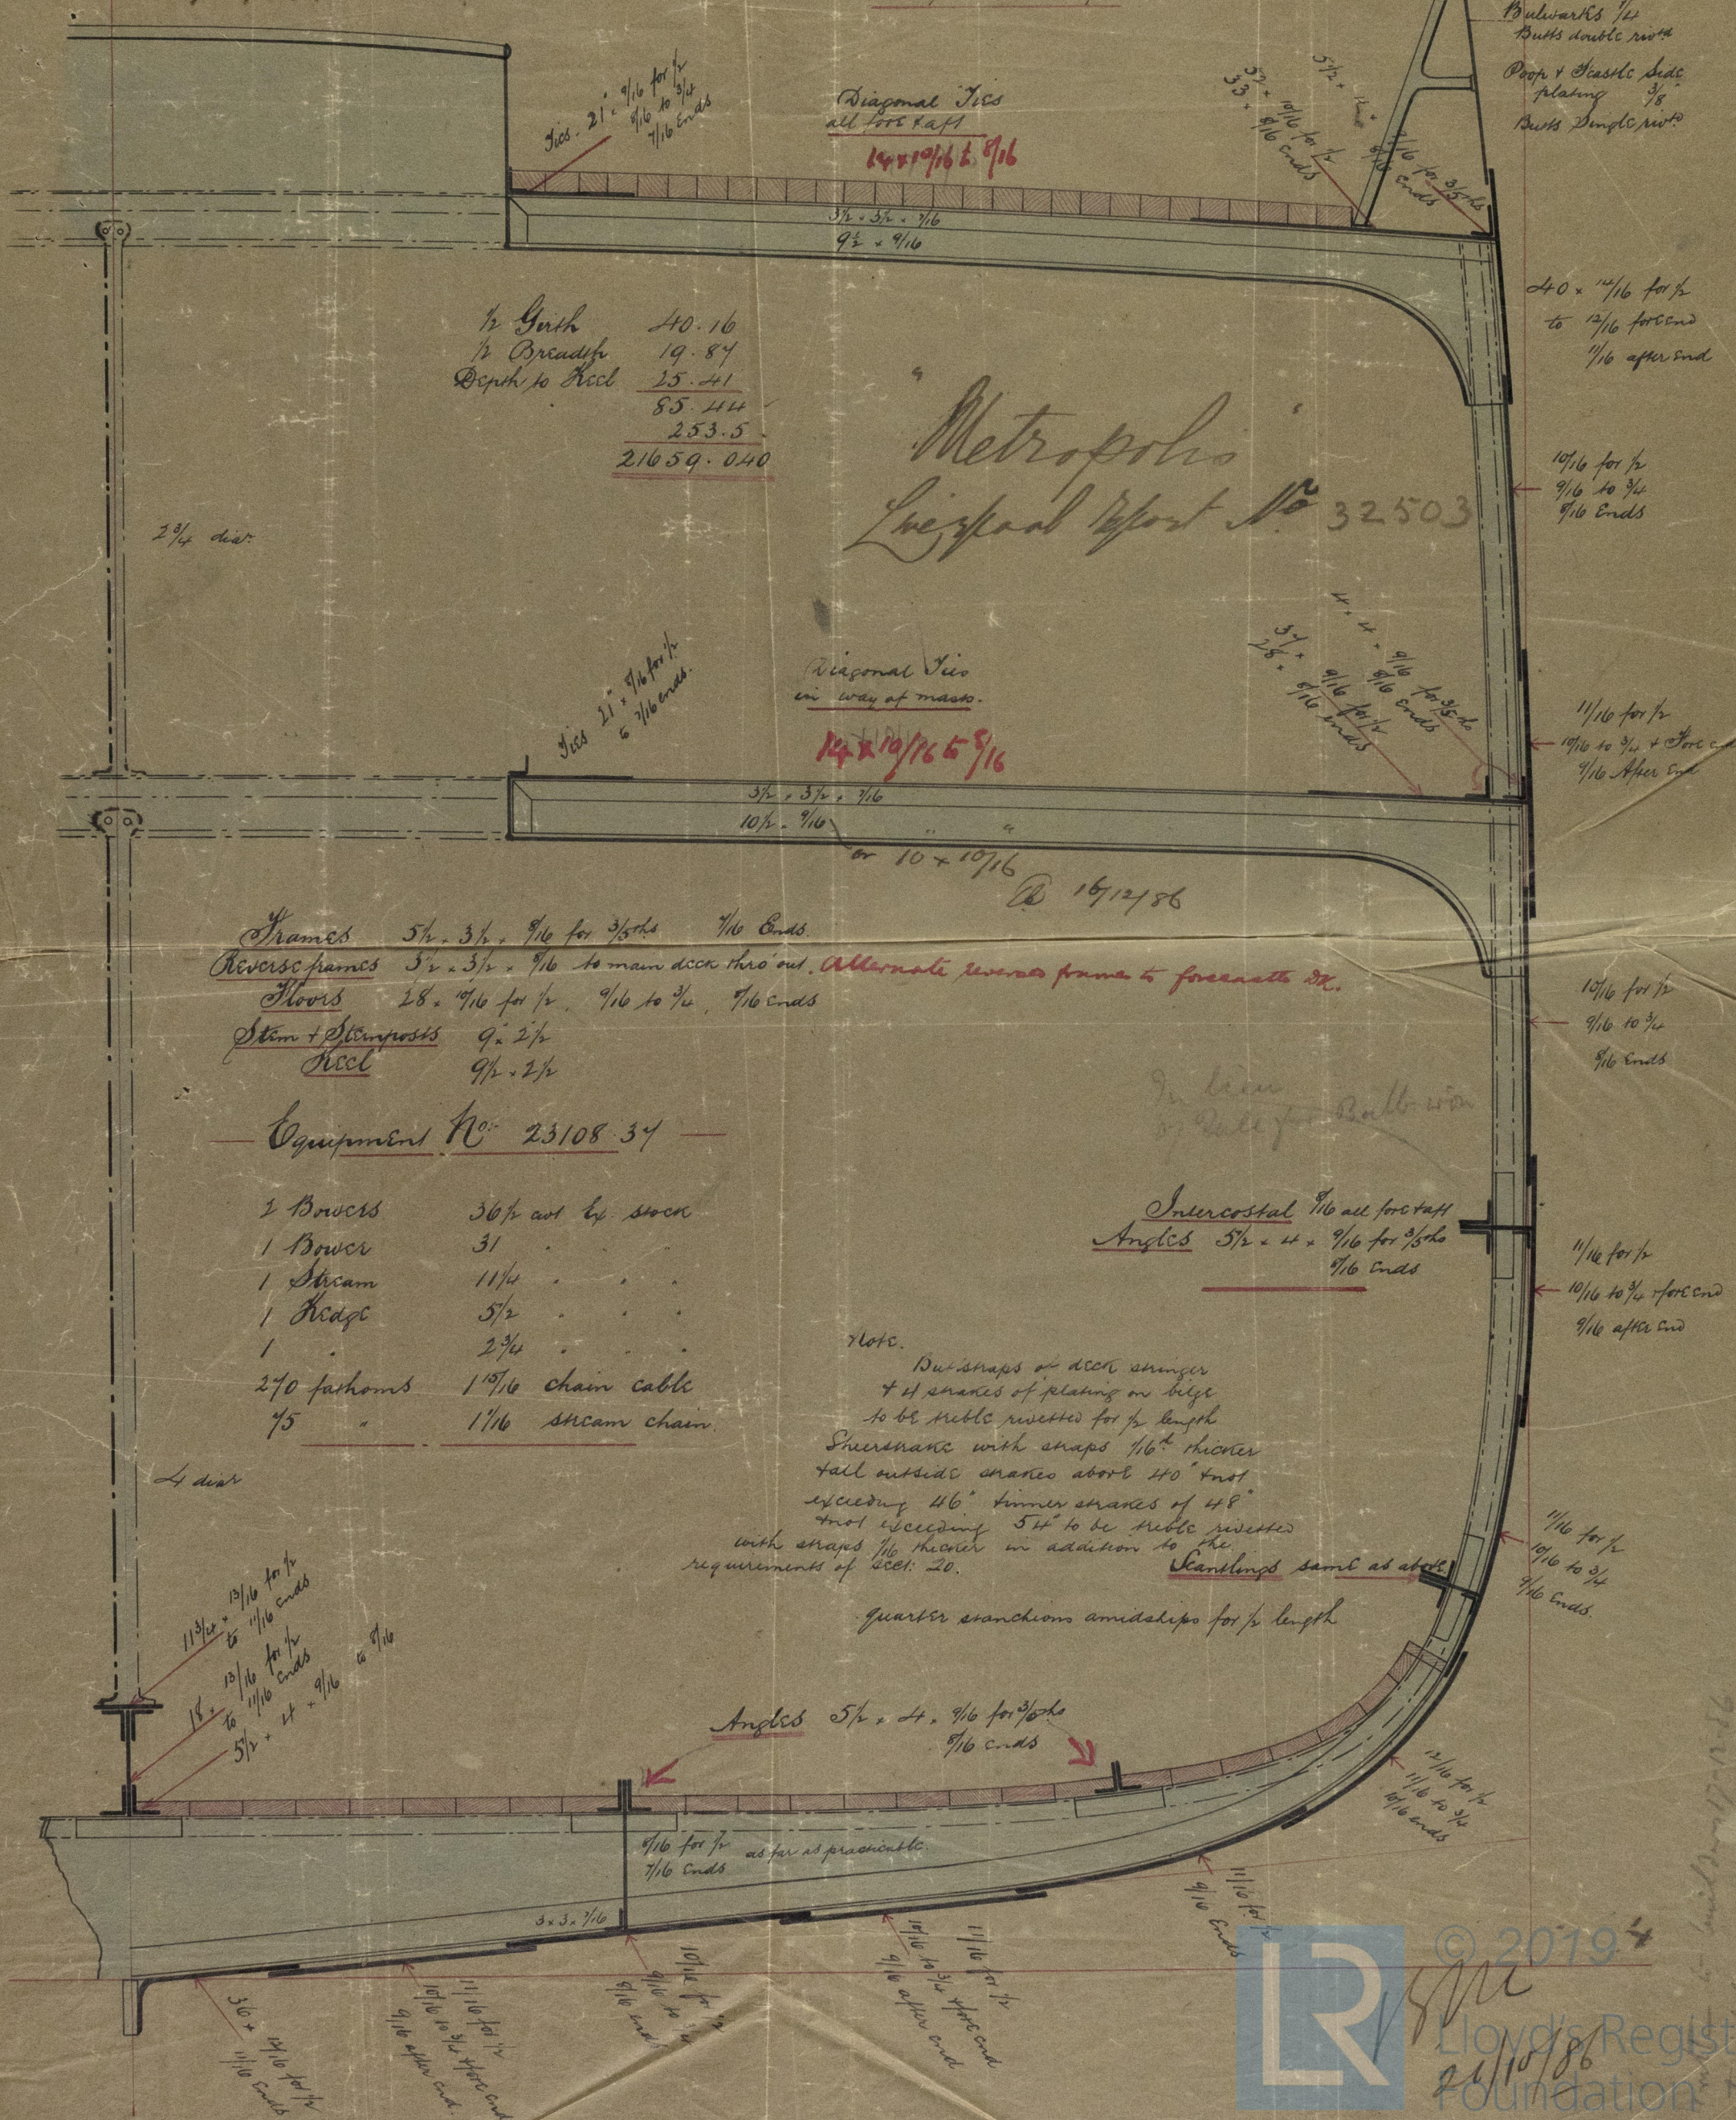

LIV 588 0117


RECEIVED
16 DEC 83
LLOYD'S REGISTER
OF SHIPPING





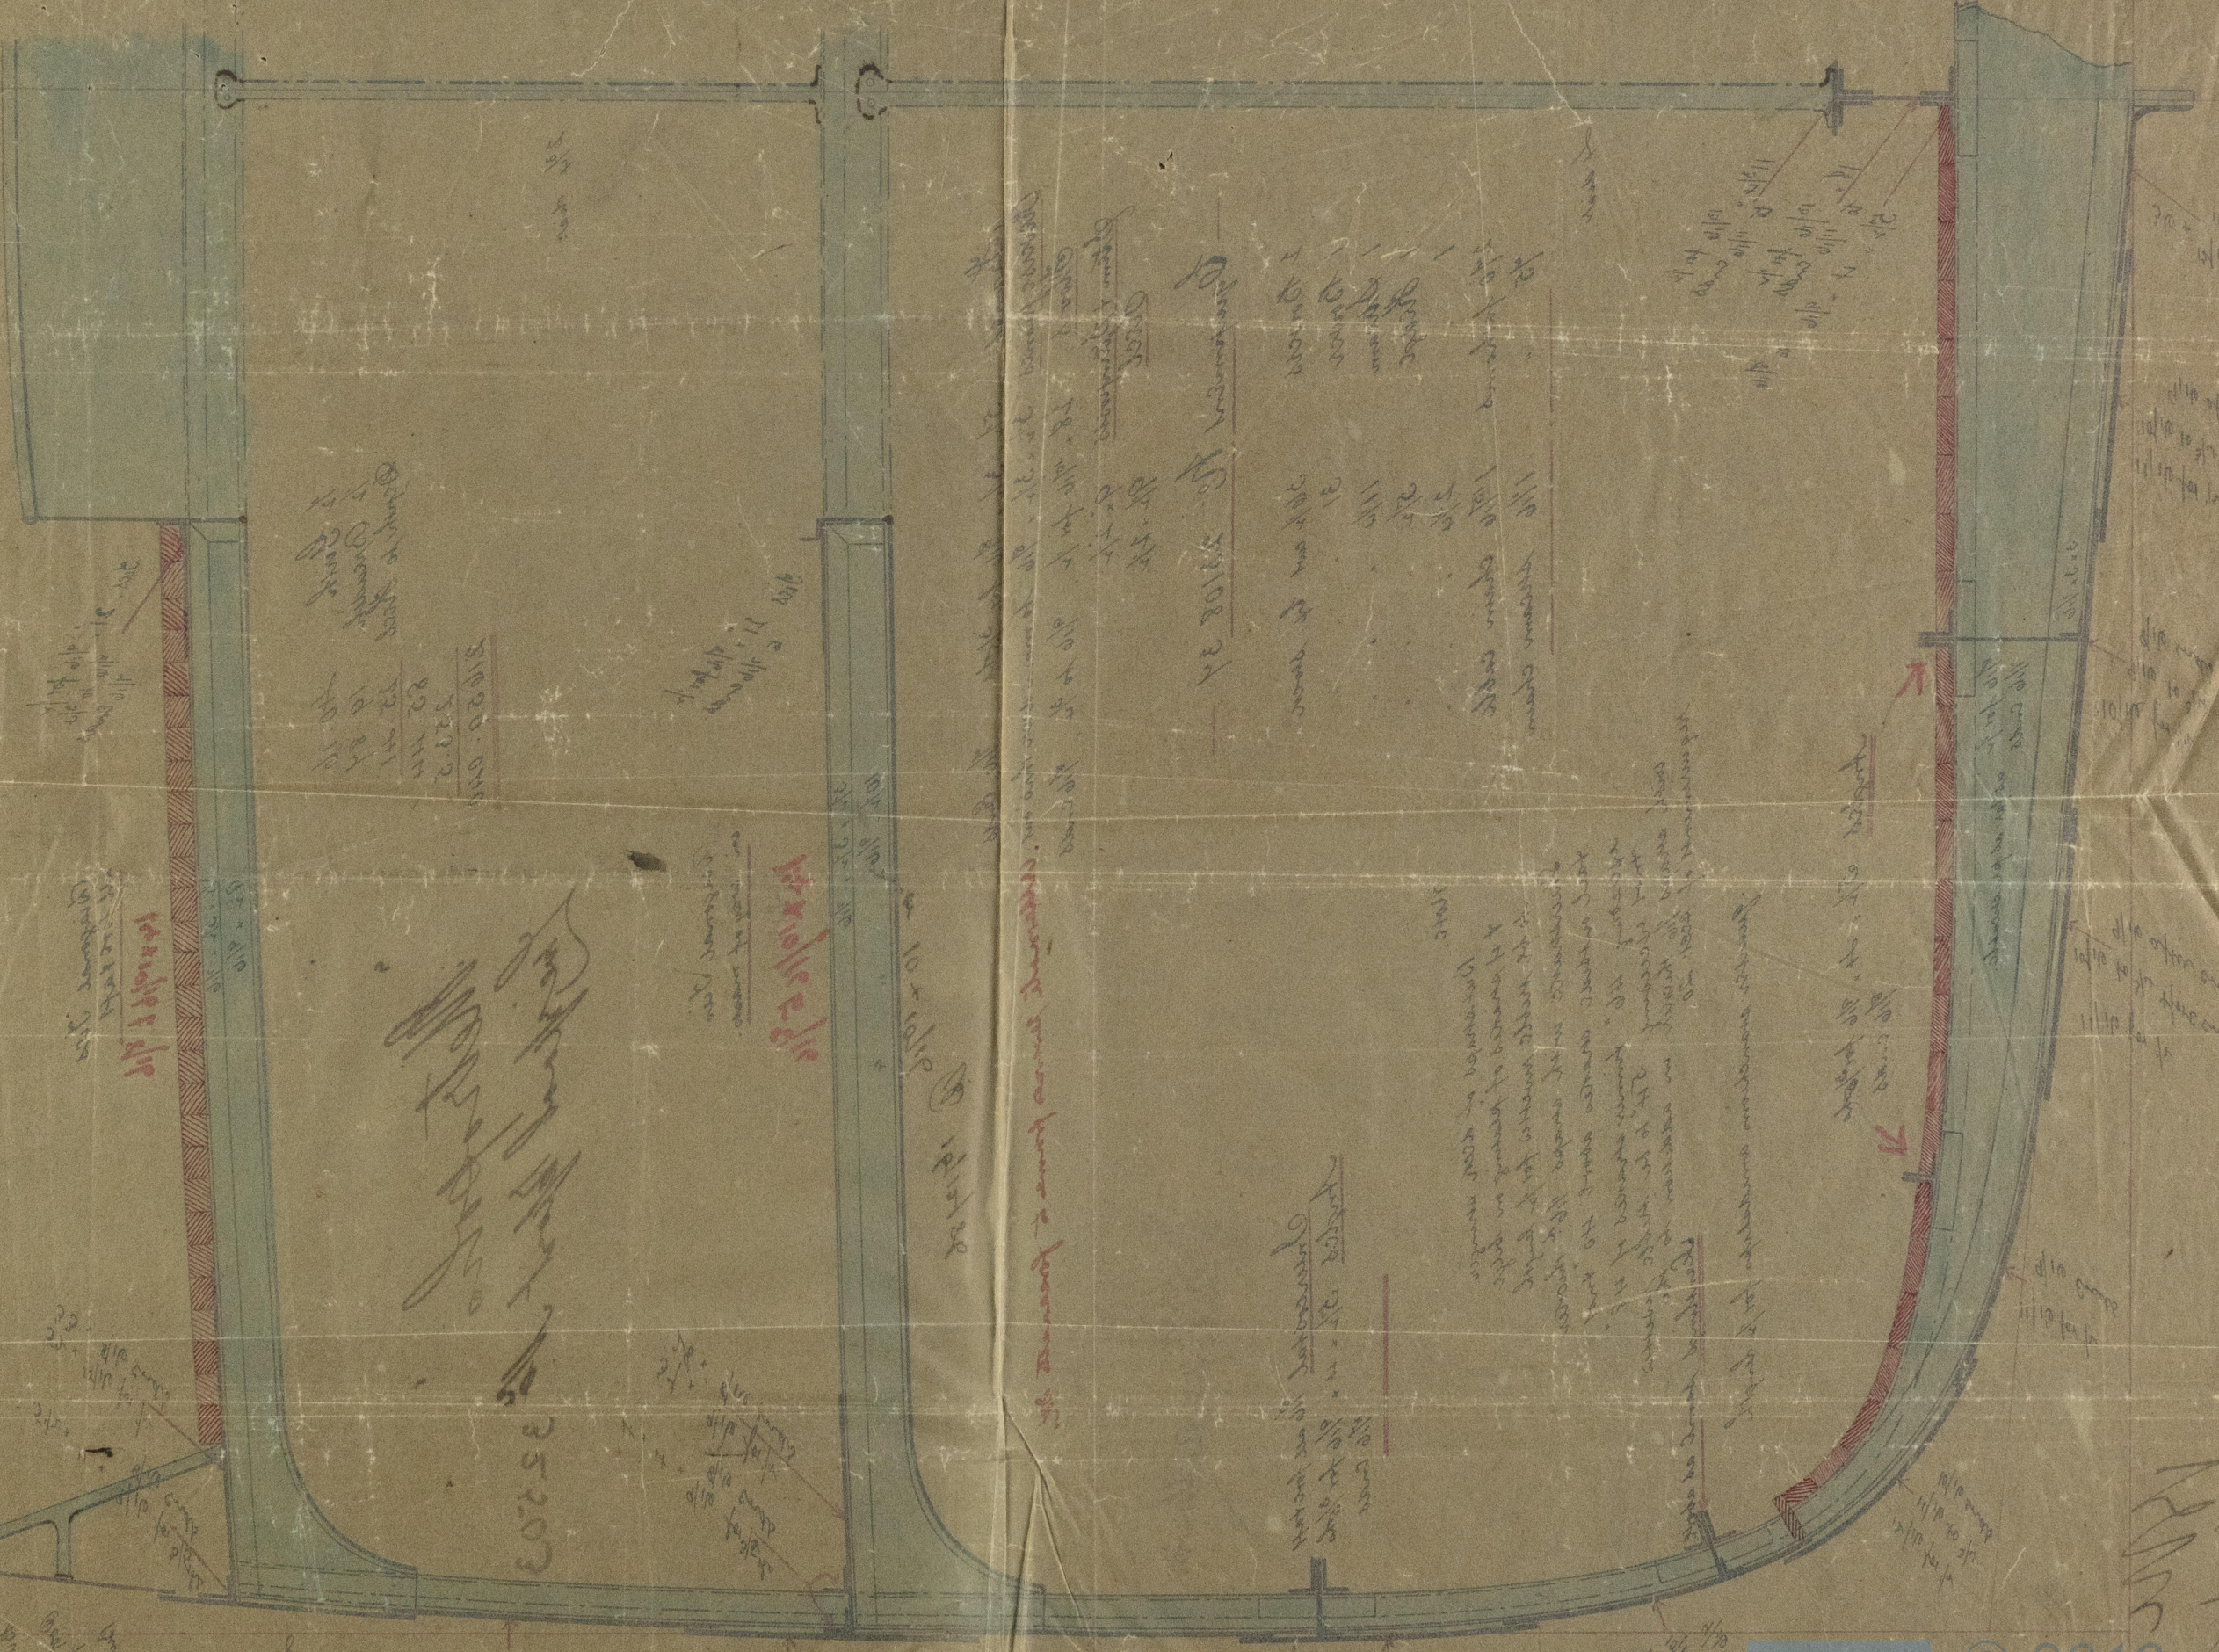

10 x 10 1/2
1 1/2 x 1 1/2
1 1/2 x 1 1/2










