

MIDSHIP SECTION


No 258

DIMENSIONS LFP 290.0; B.M 42.11; D.O.H 23.10.

Scale 1/2" = 1 Foot

WAS ROYDEN & SONS
1363
9/1/90
BUILDERS OF
FIVEBOOTS

22.1.91

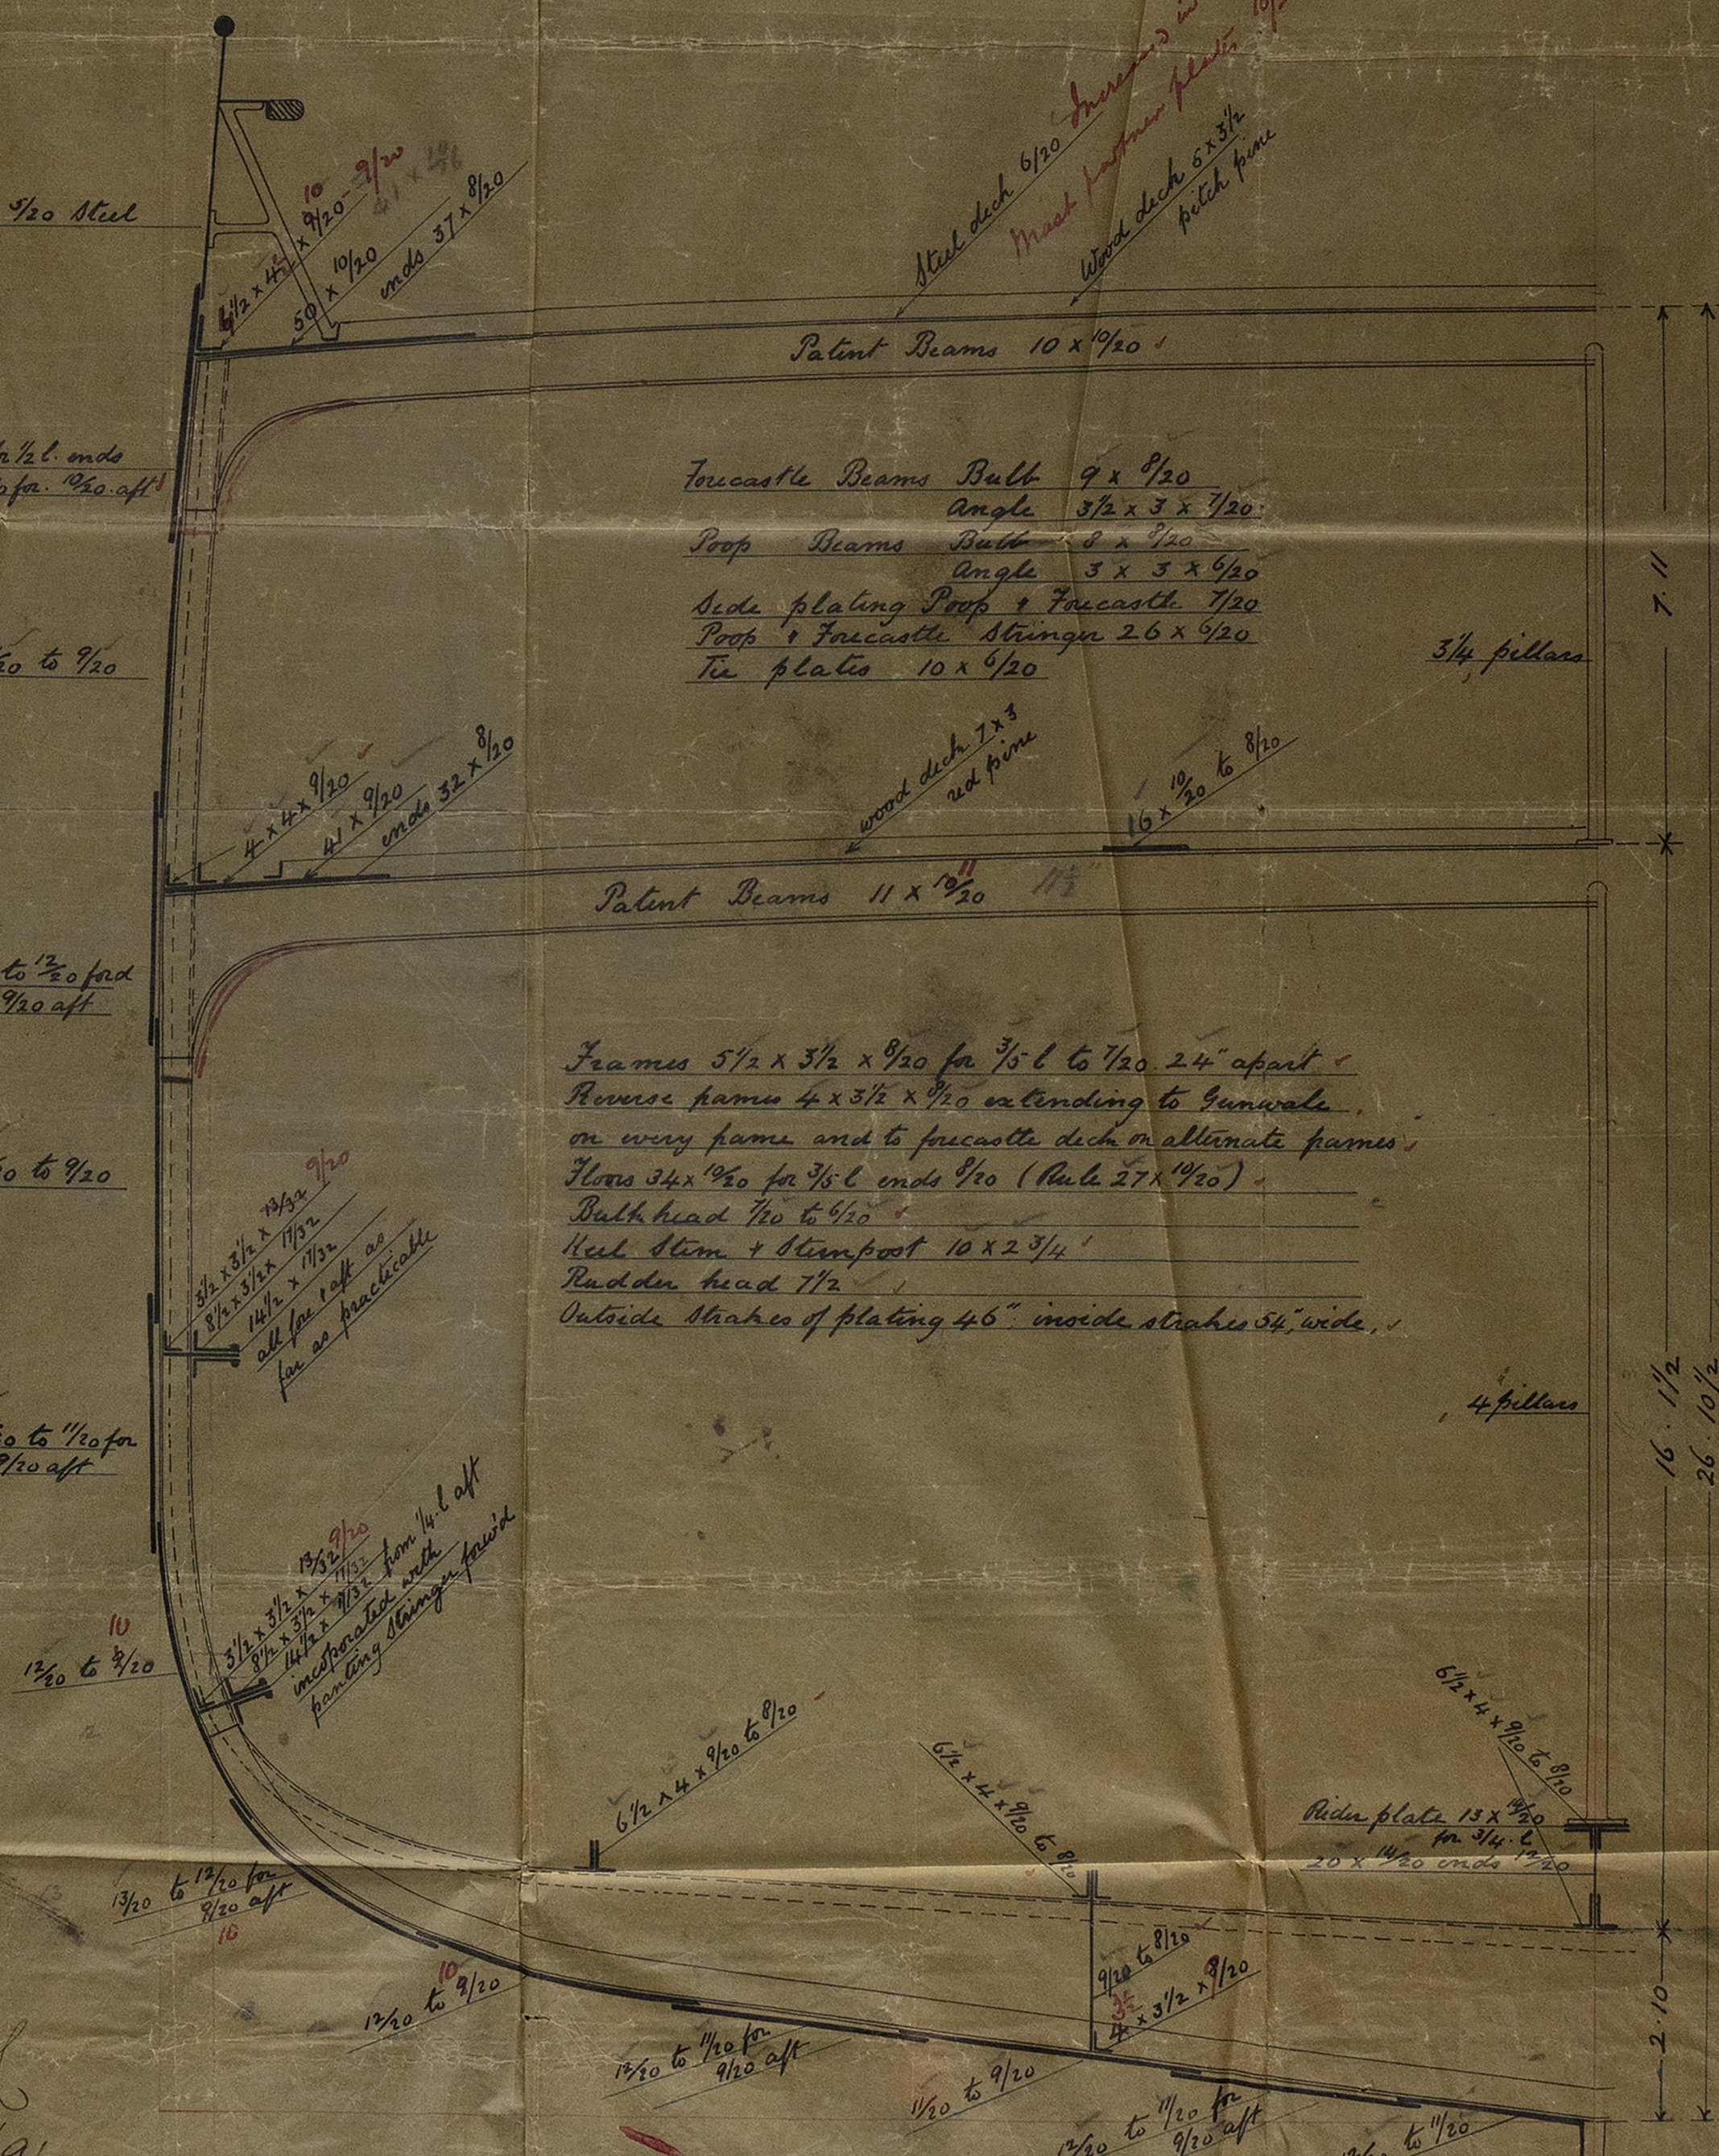

Numerals

Half breadth	21.47
Depth	26.87
Half length	42.62
1st Numeral	90.96
	289.16
	54576
	9096
	81864
	72768
	18192
2nd Numeral	263019936

Breadths to length 6.7 Depths to length 10.7

Depth of Hold 23.10

Ceilings 2 1/2

Floors 2.10

26.10 1/2

9 Camber

Moulded D. 26.7 1/2

Red Camber 10 1/2

12/20 to 11/20 for 9/20 aft

2/1/91

LIV 590-0149



© 2020
Lloyd's Register
Foundation

