
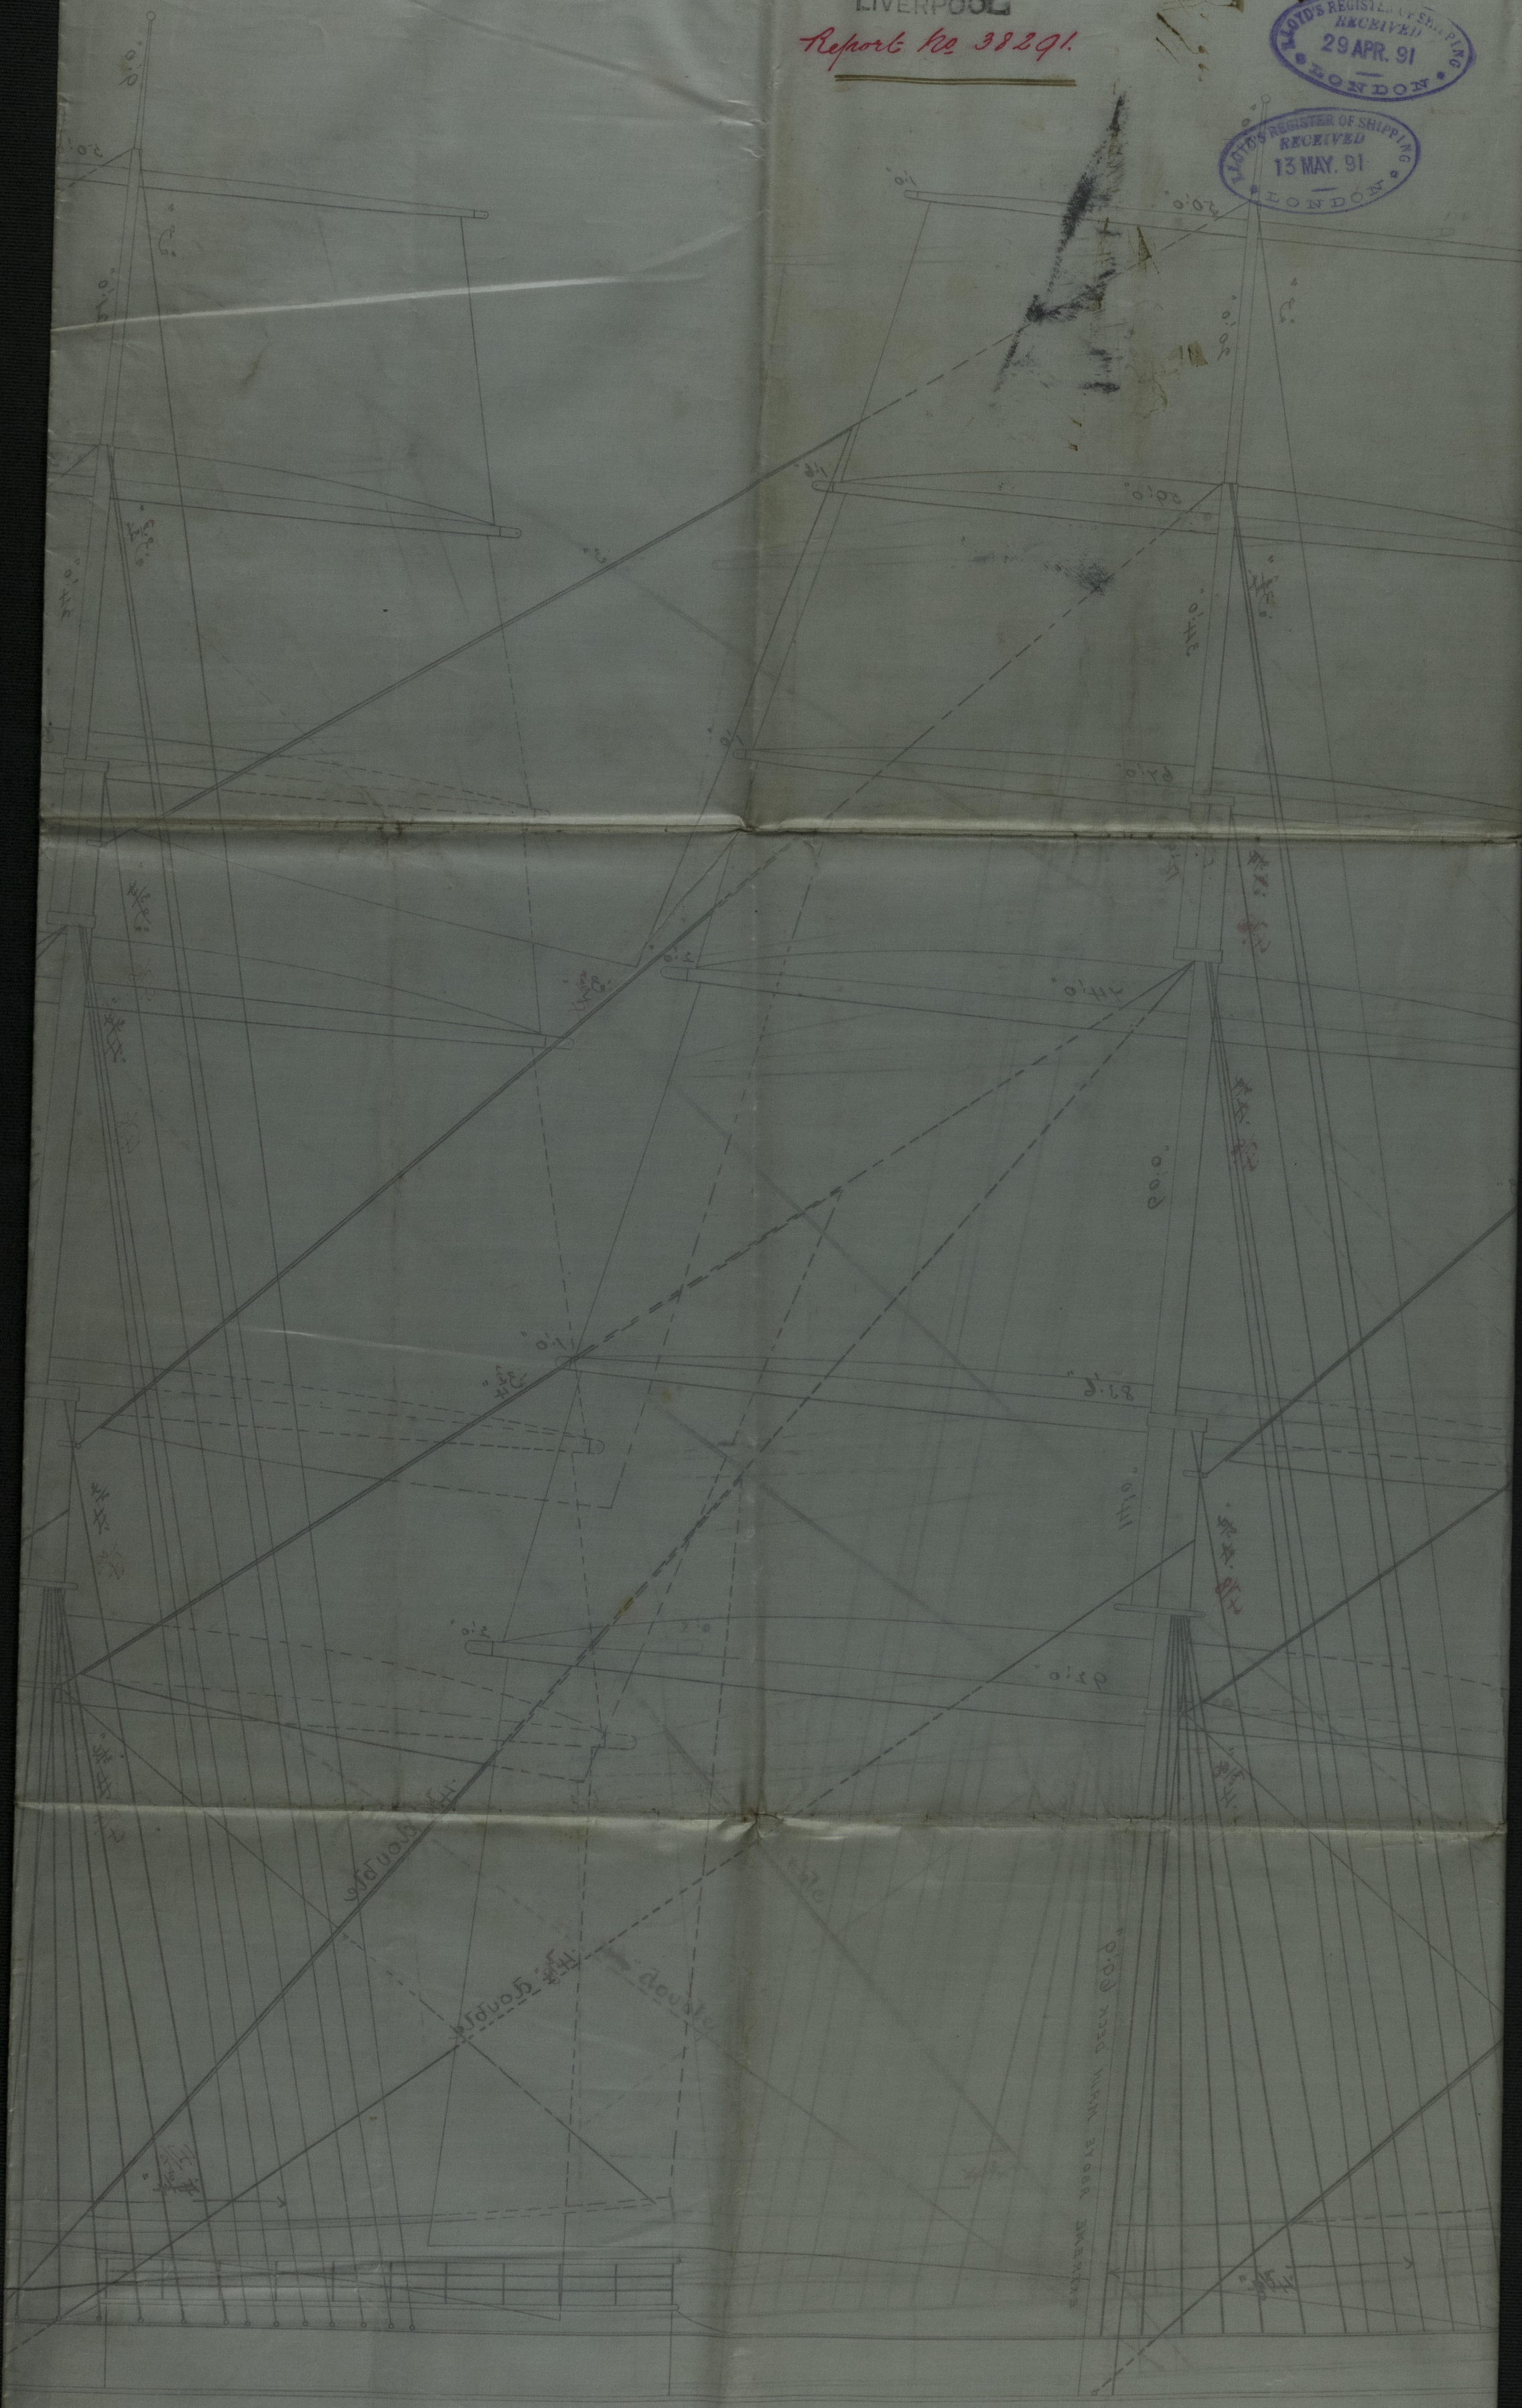
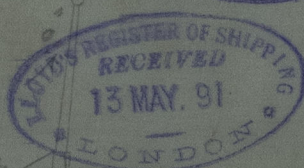


© 2020
Lloyd's Register
Foundation

"Osborne"

LIVERPOOL

Report No 38291.

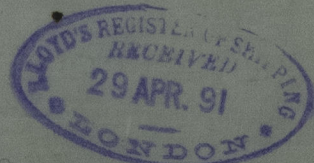

LIV590-0169