

Cradley Boole, C.


100 lbs

6340

6341

6342

Lloyds Test 184 200 lbs. 20/4/06 F.W.P.	Lloyds Test 200 lbs 11.89. 29.8.06 PFM	Lloyds Test 200 lbs 11.90 29.8.06 PFM
---	---	--

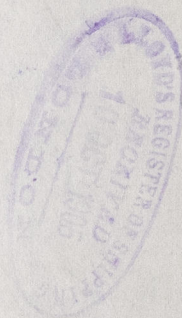

for BK
Pinnock

Shef 1585^R

WED. 12 SEP 1906




LIV594-0169



© 2019

Lloyd's Register
Foundation


~~12:10:05~~

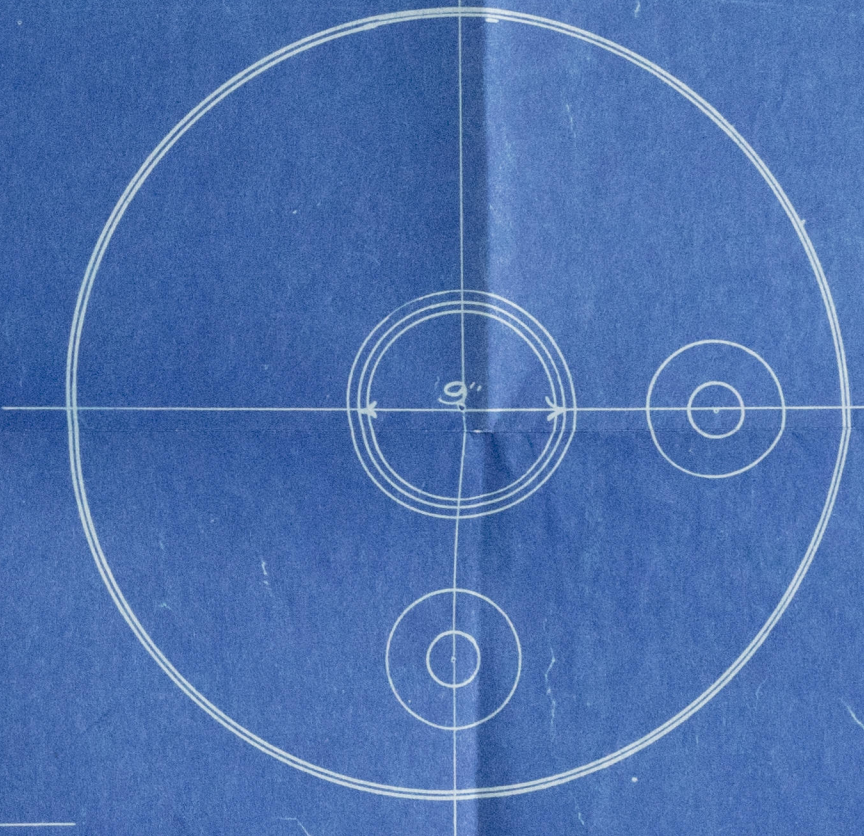

6' 3" x 3' 0" Mild Steel Vertical Cross Tube Boilers
Working Pressure 100 lbs " "
Hyd Test Pressure 200 lbs " "
Plates "Dall" "
Scale 1/2" = ONE FOOT

10/ 6340 89
6341 90
6342

Feb. 6th 1908
Cradley Boilers &
Cradley Works

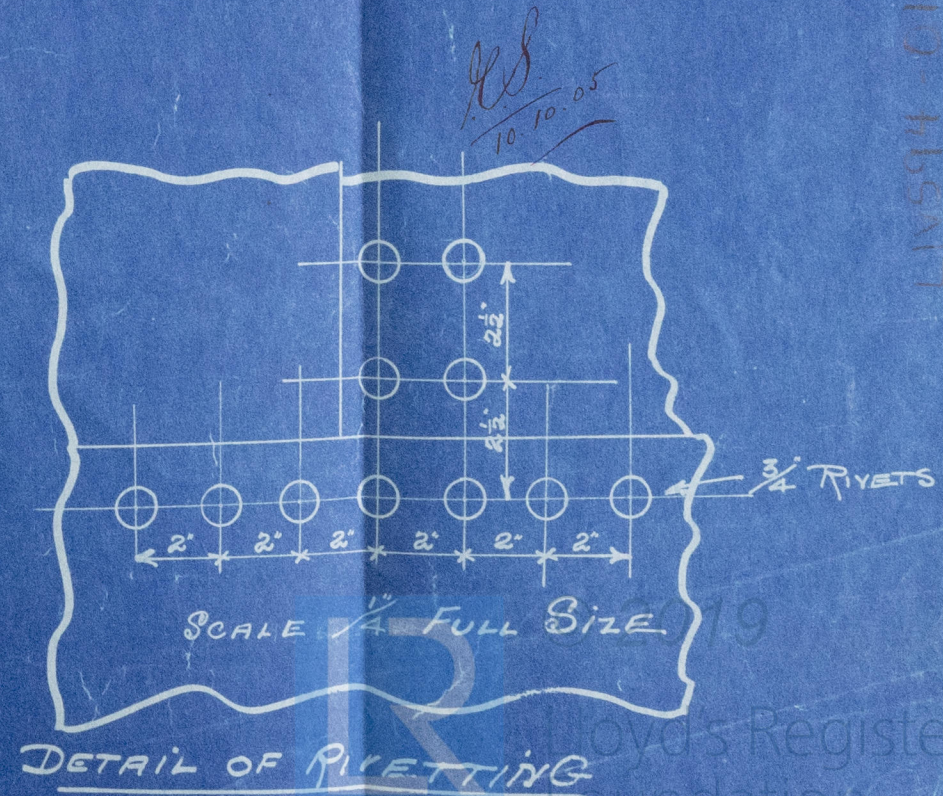

