




Port of London

Continuation of Report No. 56406 dated

Apr 1905 on the

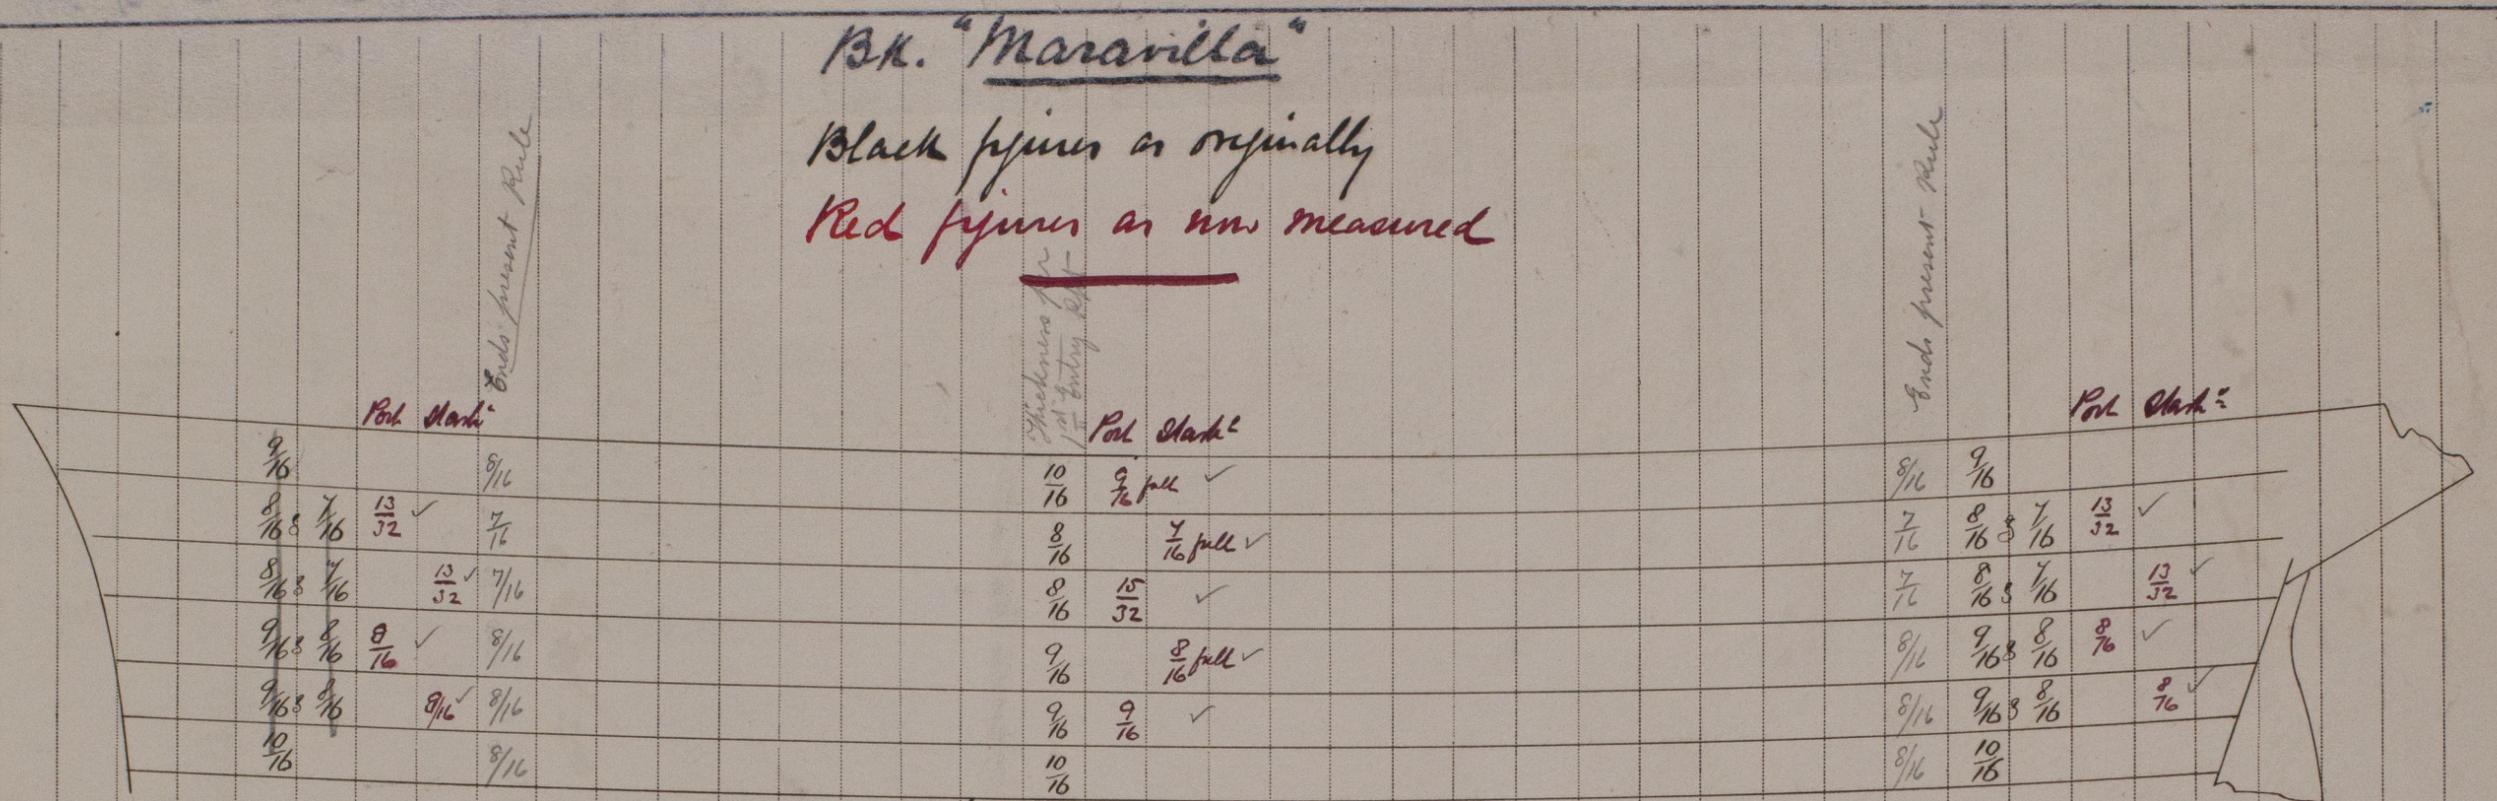

BK. "Maravilla"  
 Black figures as originally  
 Red figures as now measured

Line of Cement.

2/27900-507N07

210-2,000-6/11/04-Transfer Ink.