


Ship "Orient" 1032 Tons.

Sketch showing where she is opened in the top for the First Rule of Restoration

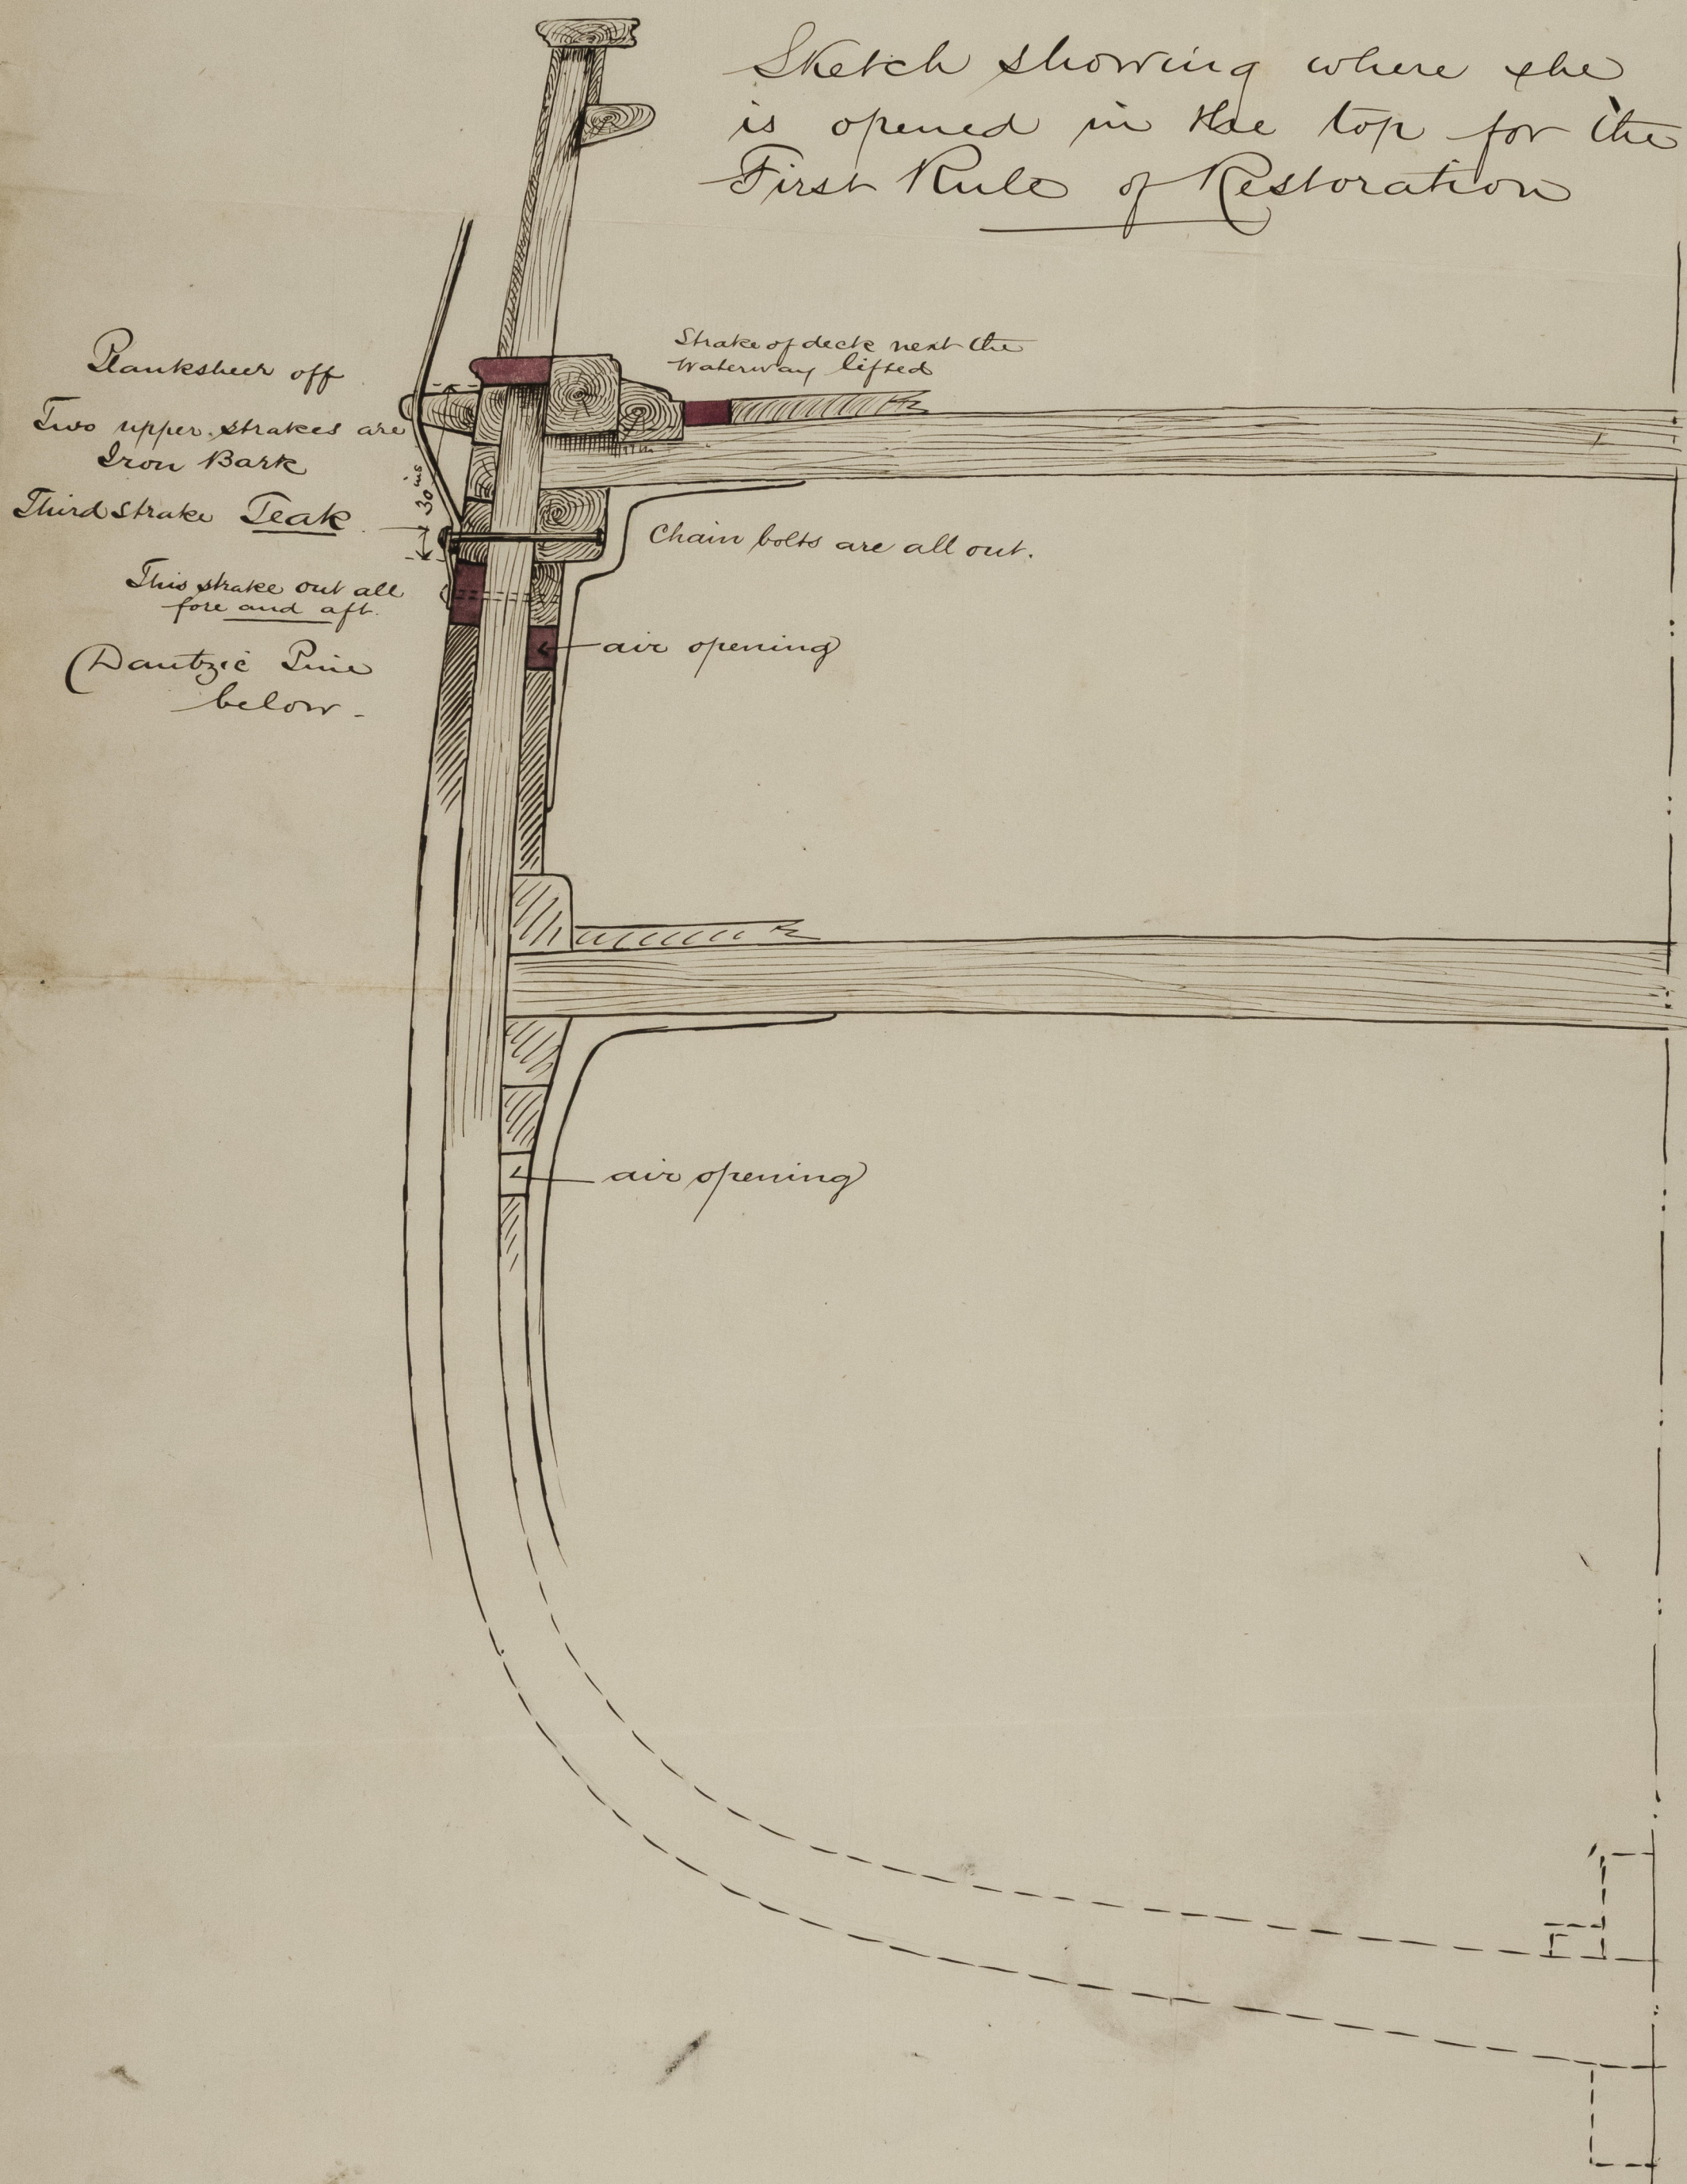

18764. Jan

LON 721 - 0012



© 2021

Lloyd's Register
Foundation