


Section of The Tweed and Assaye.

"The Tweed"

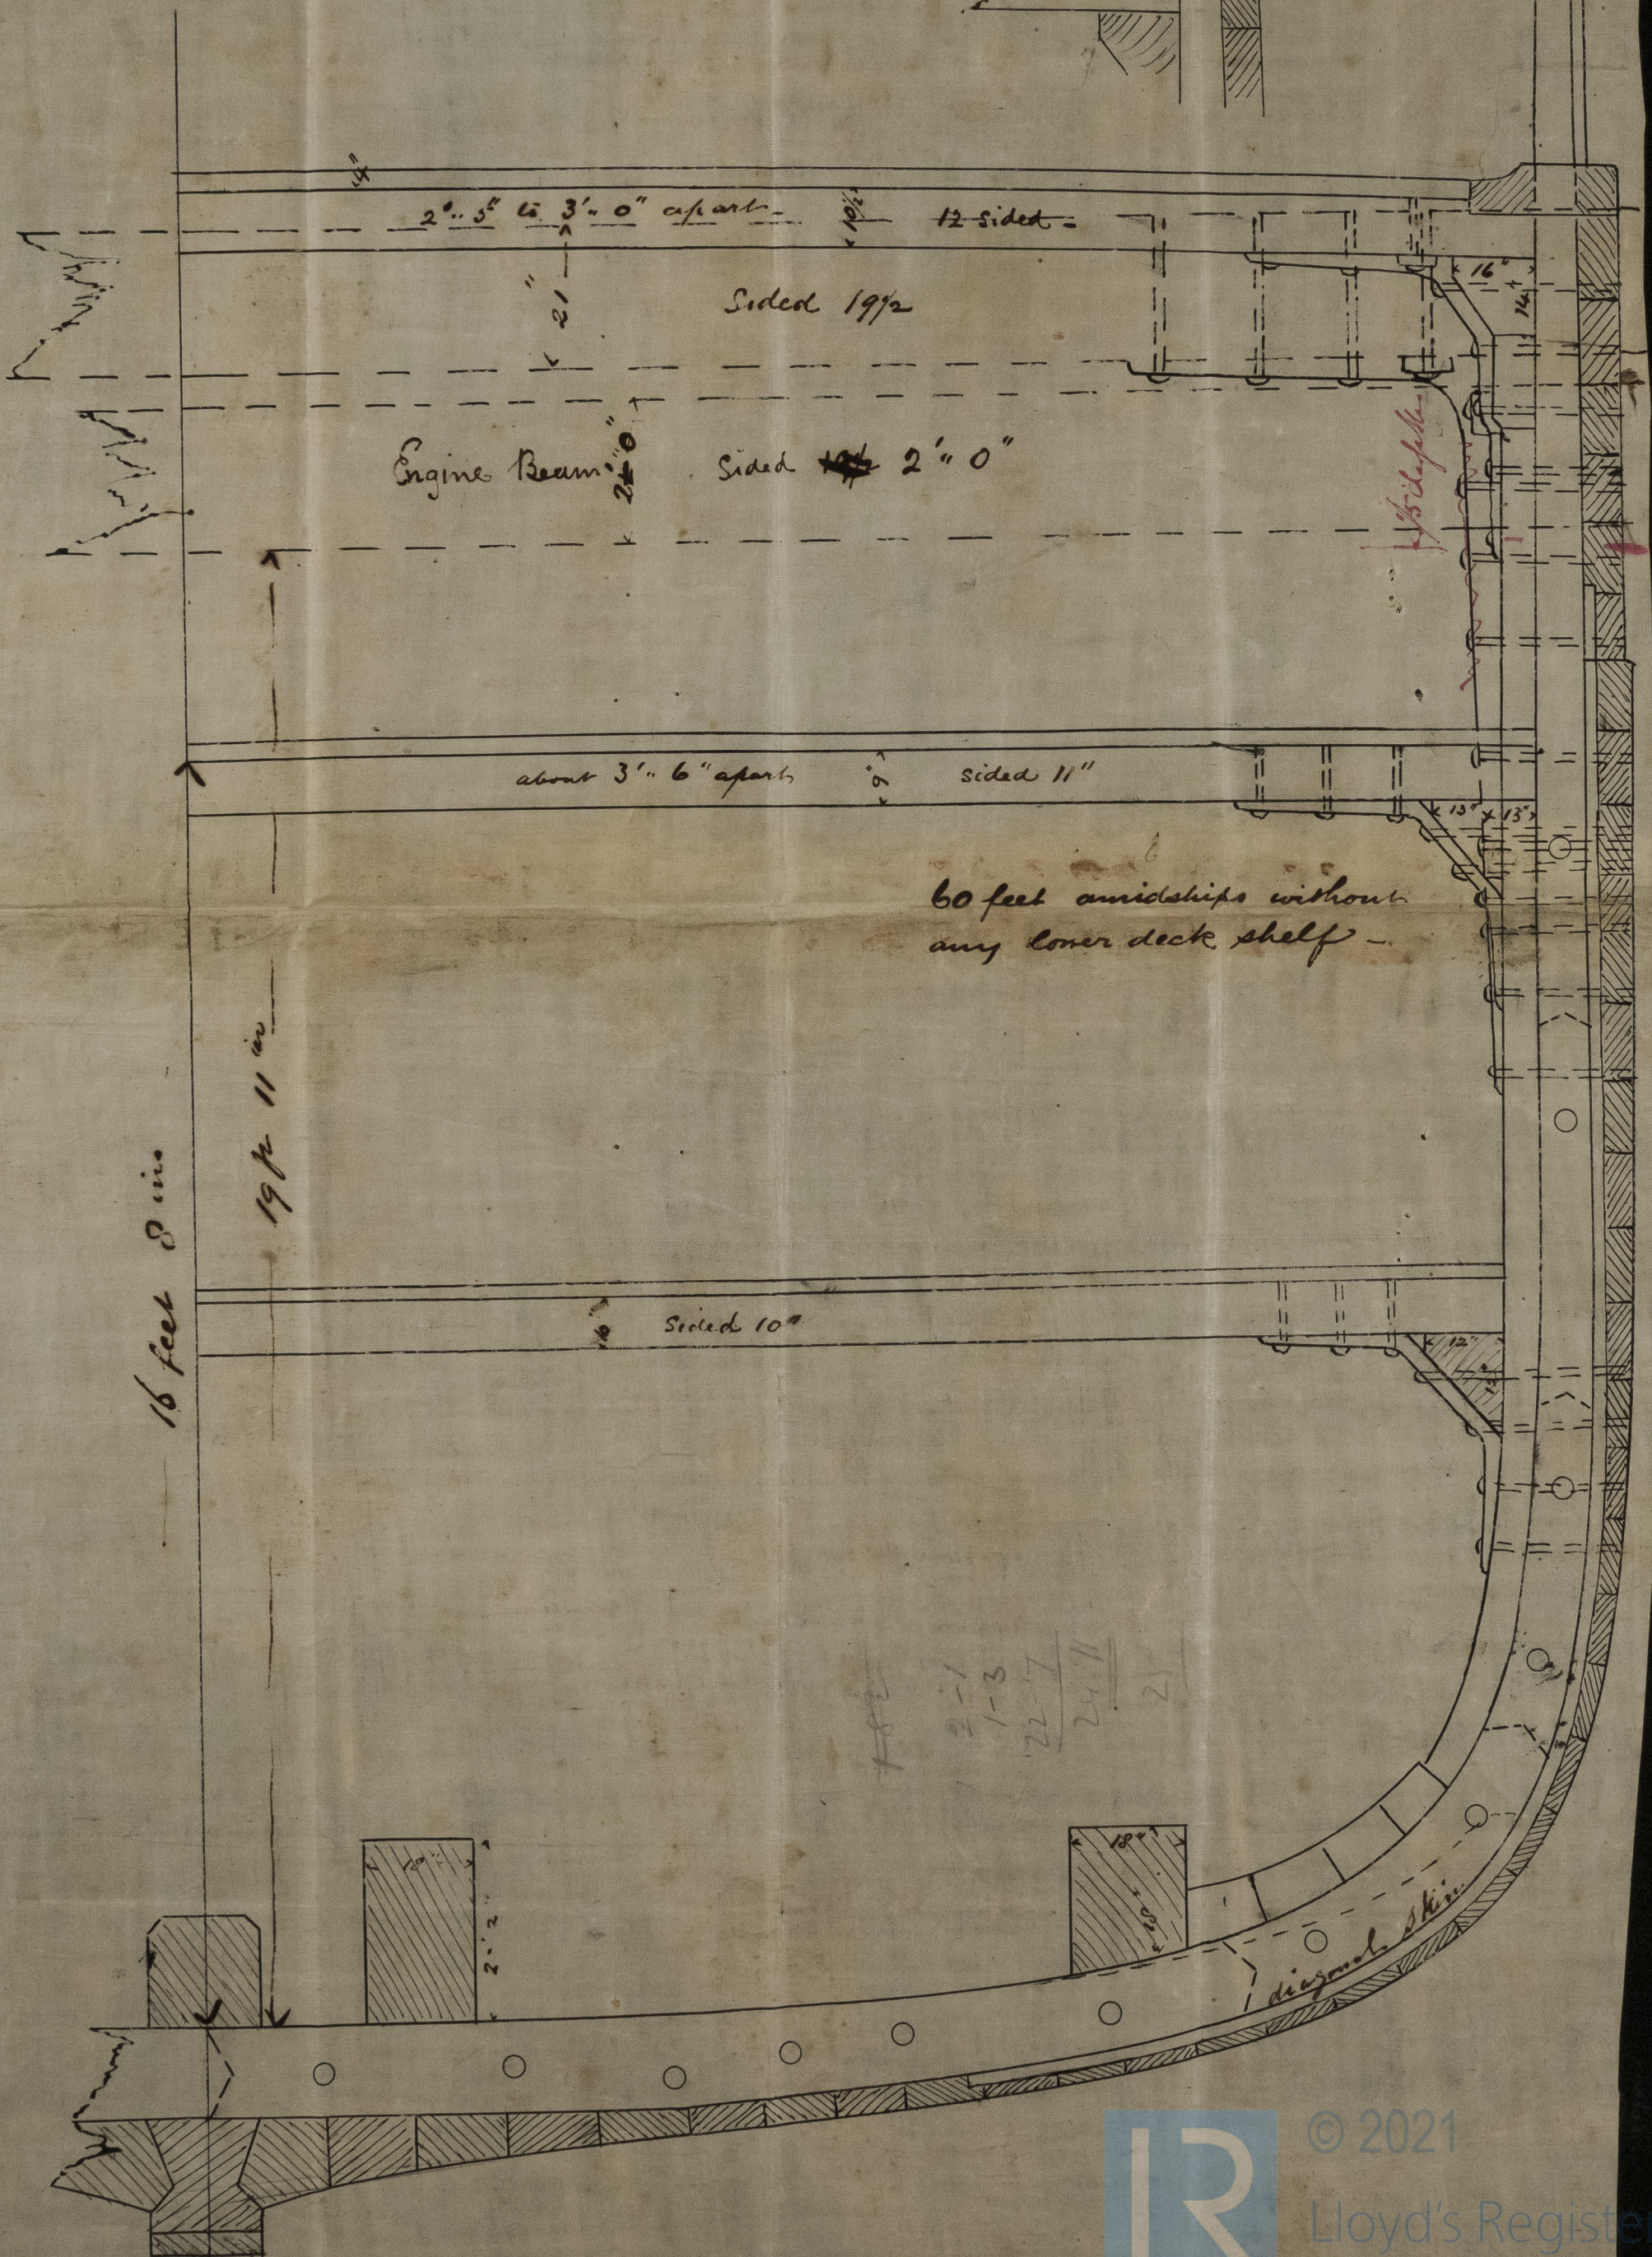

© 2021

Lloyd's Register Foundation

LON721-0016












© 2021

Lloyd's Register
Foundation

Lon 721-0016