
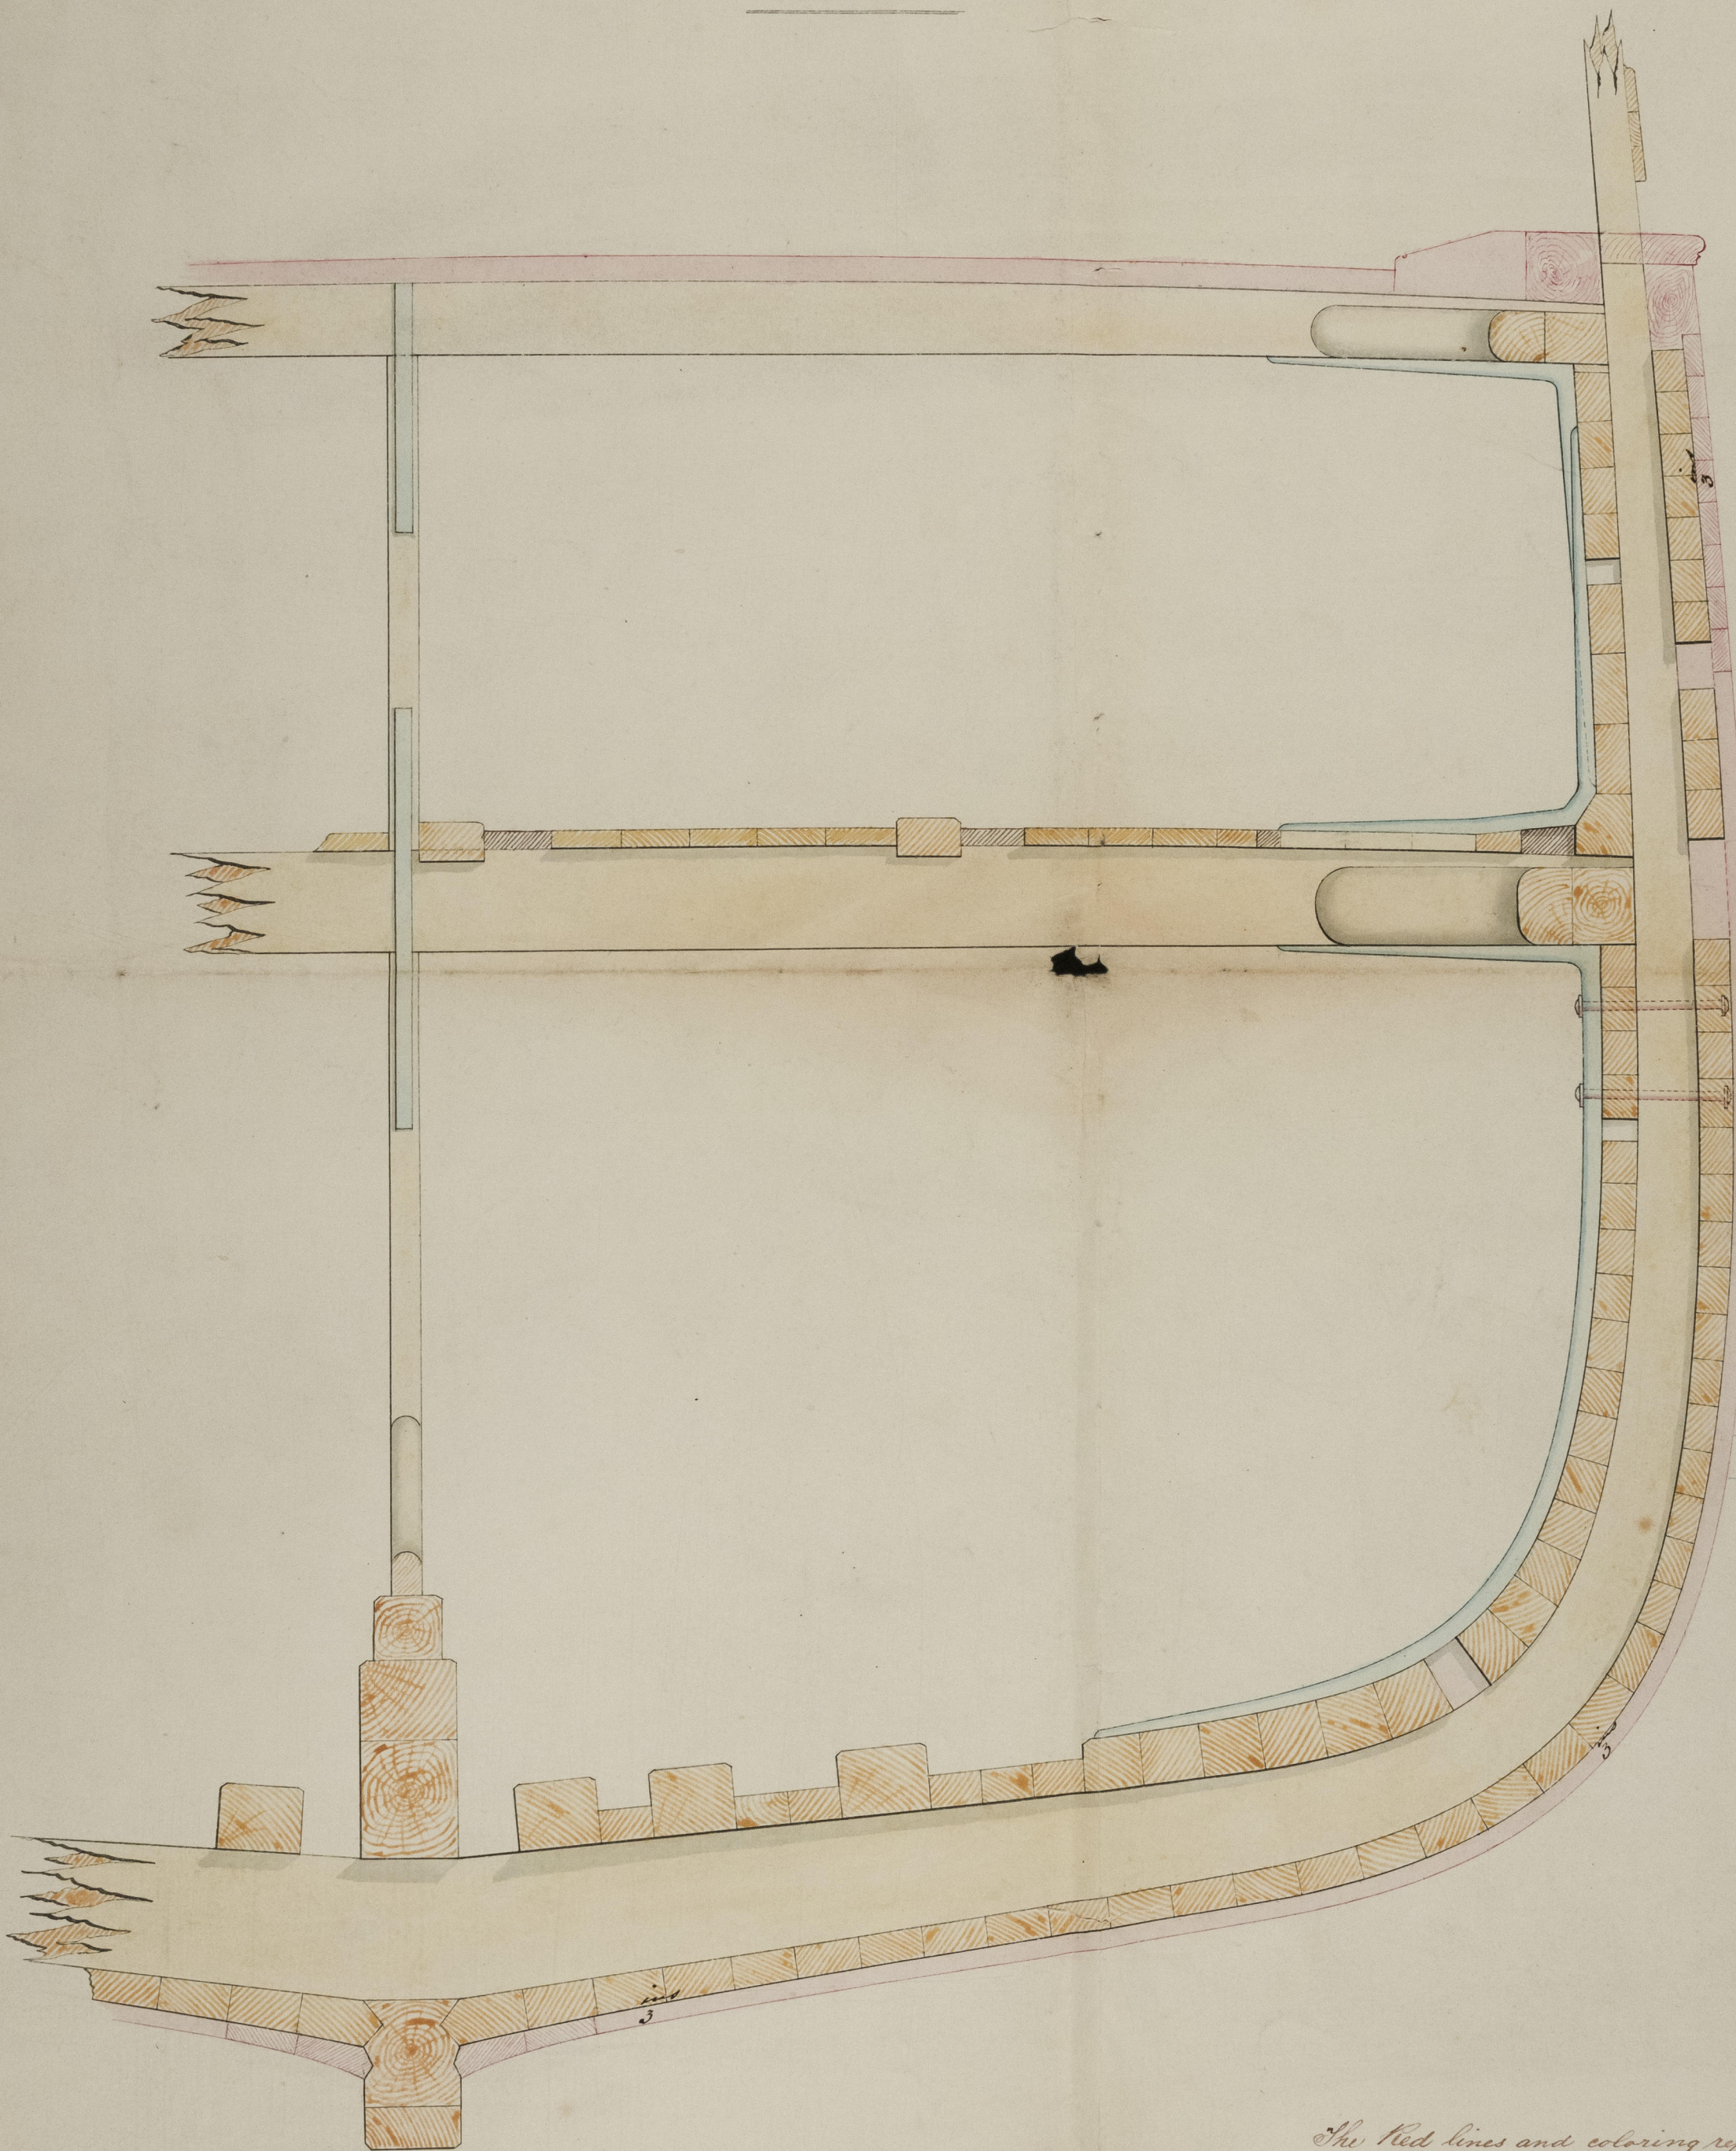


HALF SECTION OF "MATOAKA"

SCALE $\frac{1}{2}$ IN. = 1 FOOT.

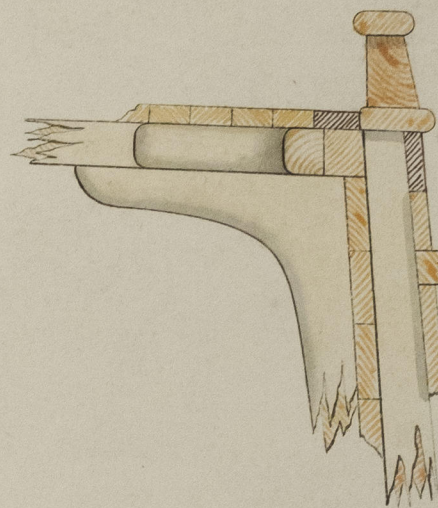

Light Water Mark.

The Red lines and coloring represent new work.



© 2021

Lloyd's Register
Foundation

LN721 - 0041

26464 Lon



© 2021

Lloyd's Register
Foundation

20N721-0041