
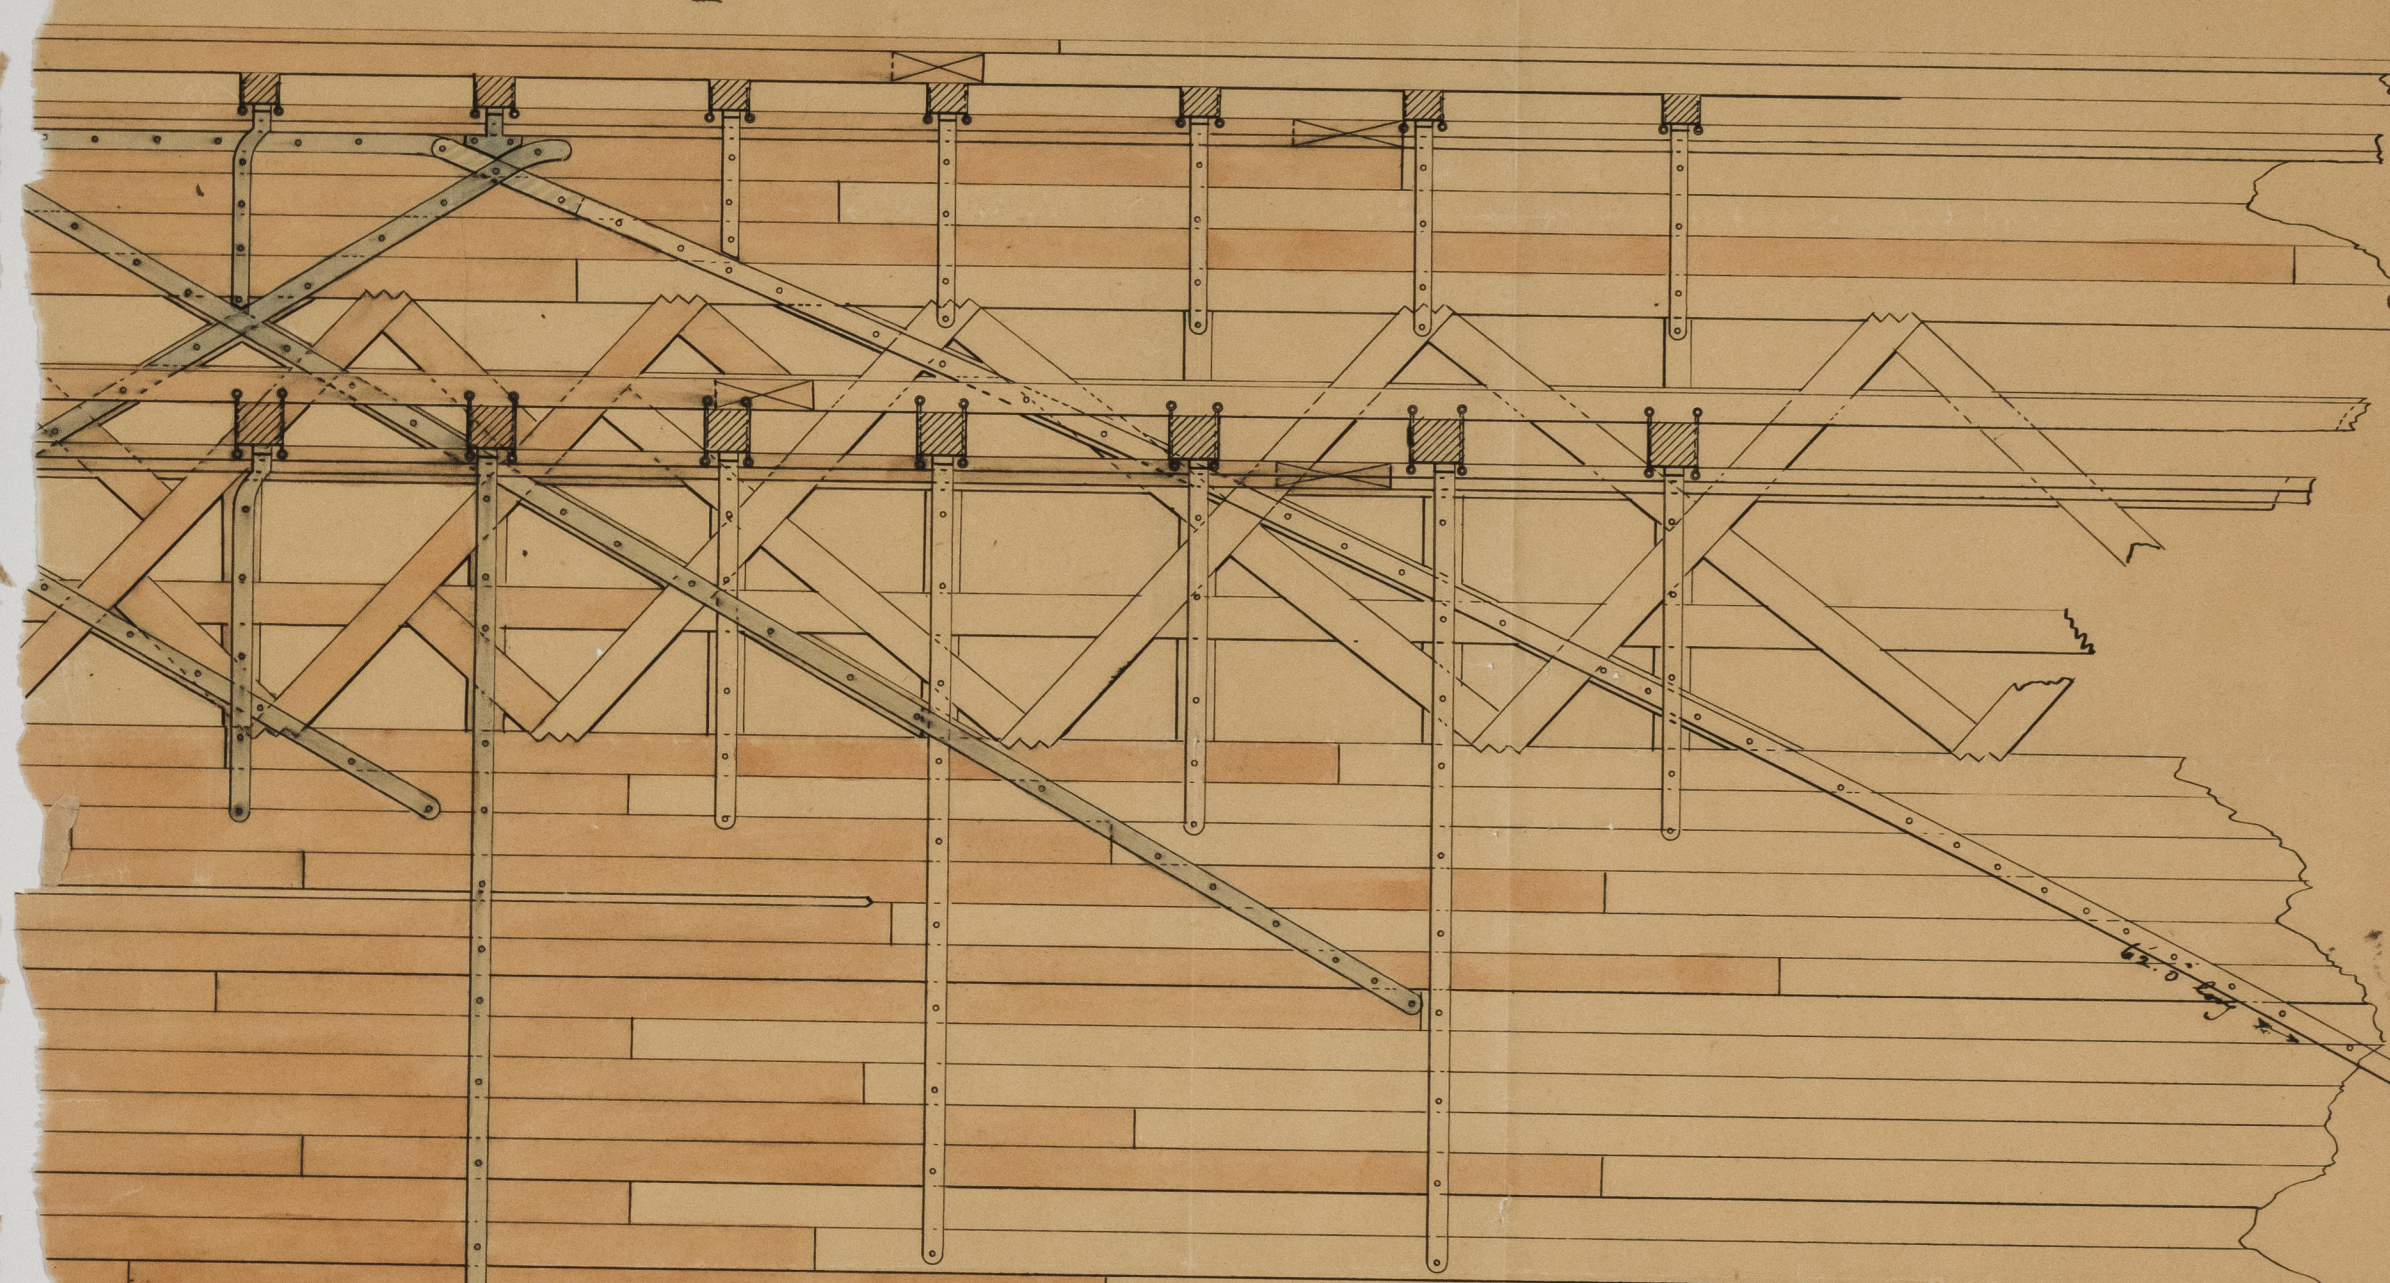


Hanover Expansion

Scale 1" to the foot

Inside Plank &c. (Lamb's side)

Note. All the new work is colored.

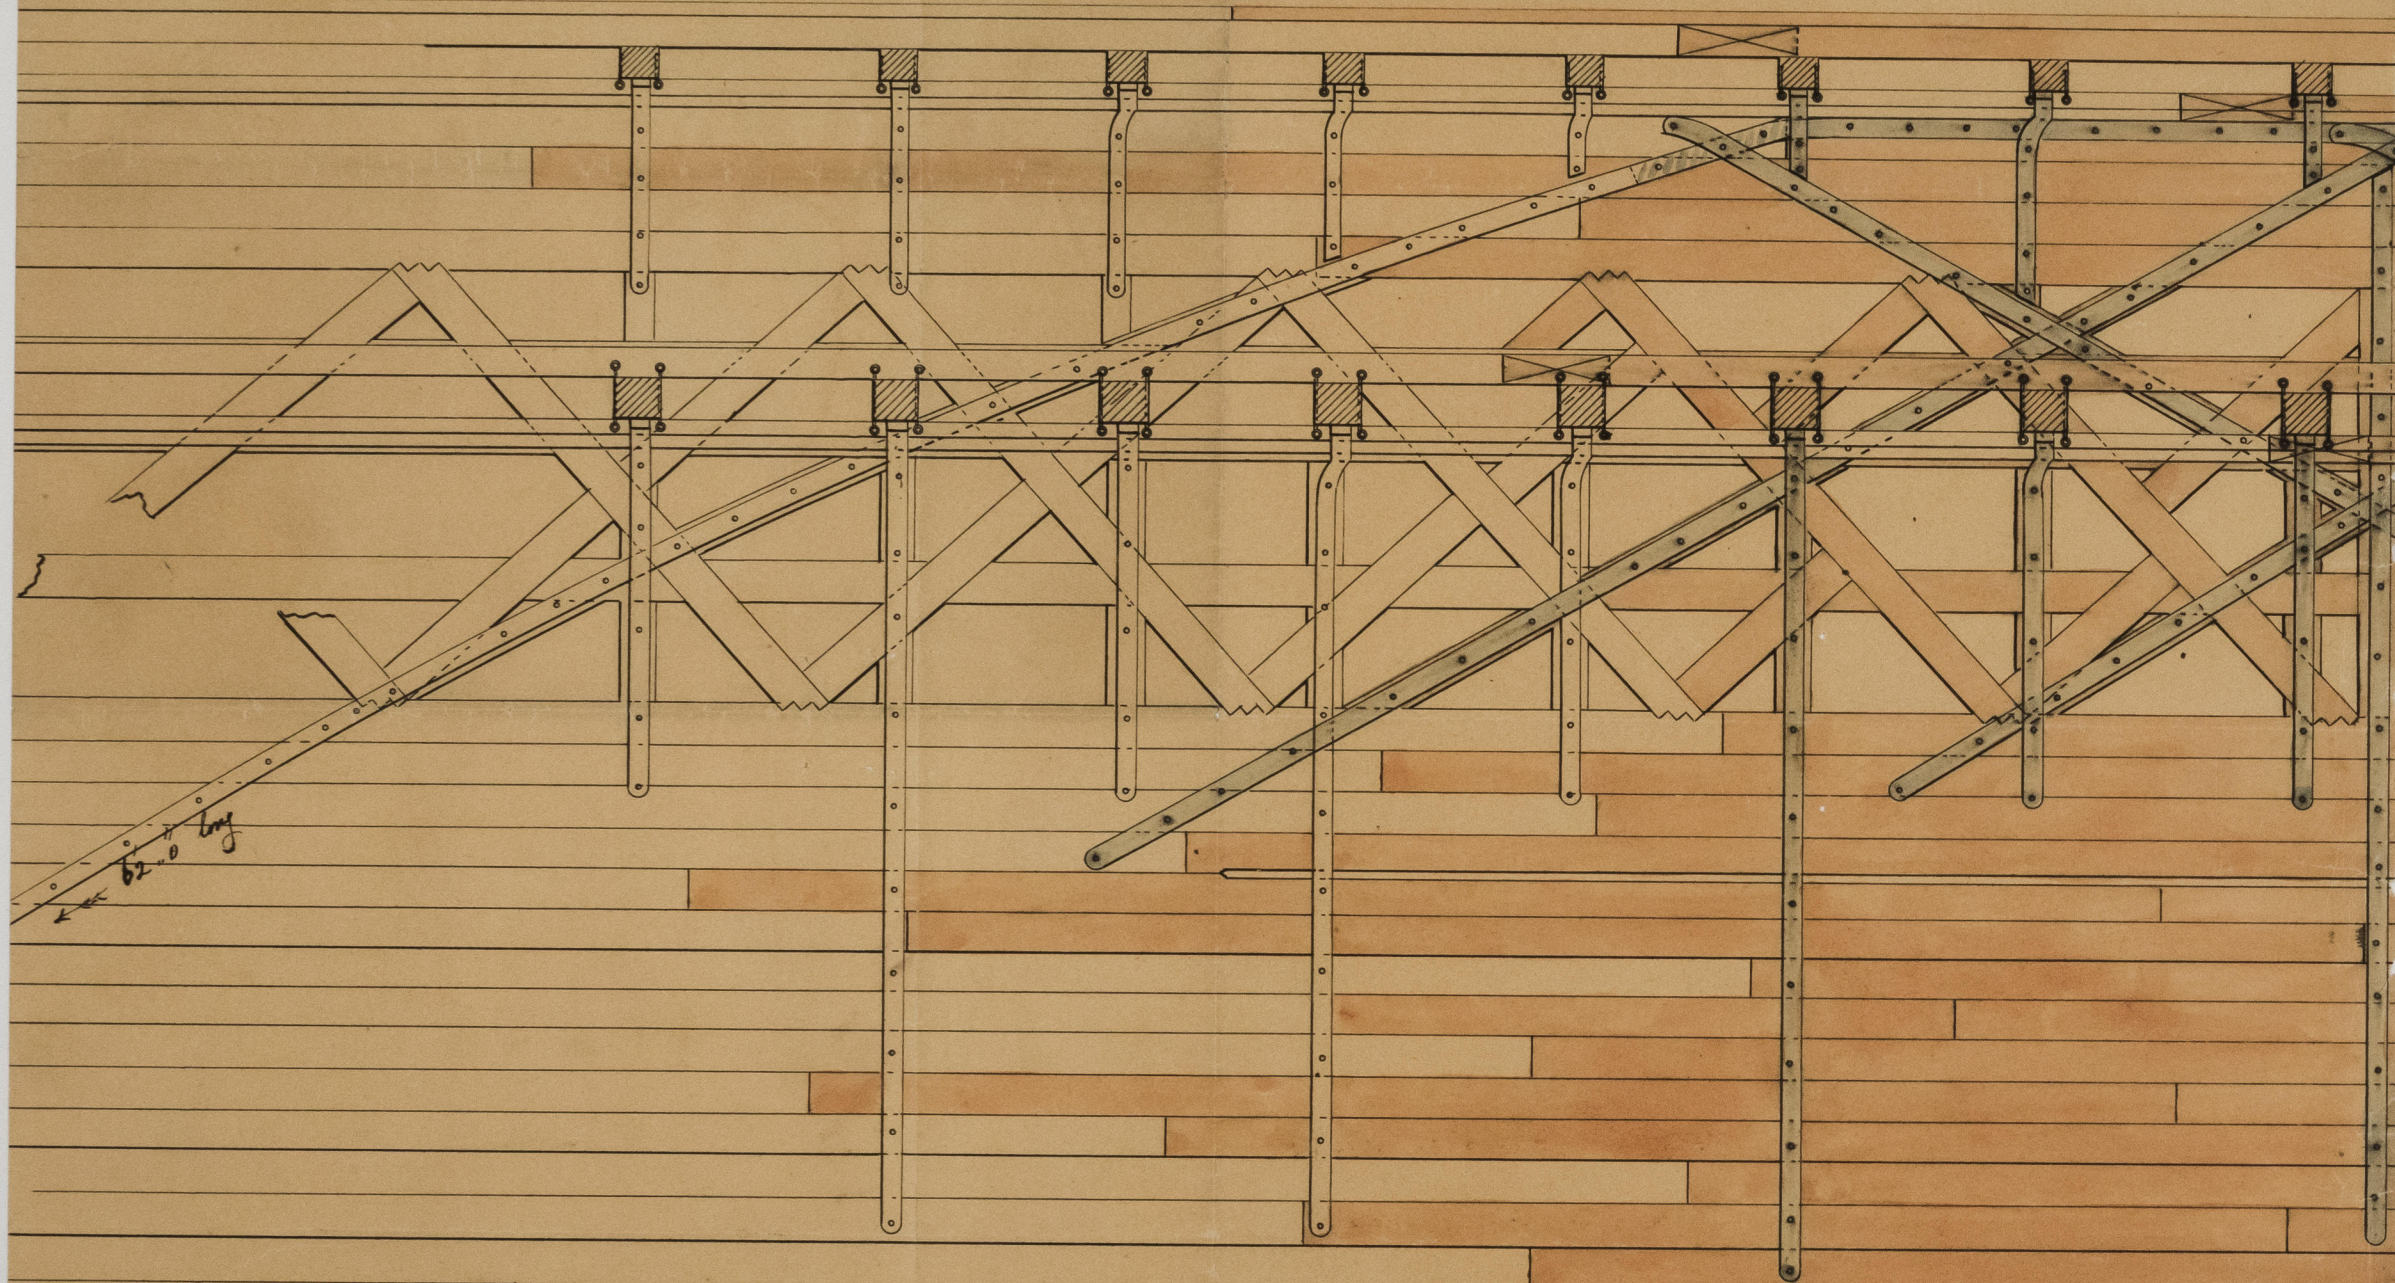

YOUNG SON & MAGNAY
SHIP BUILDERS
LIMEHOUSE DOCK-YARD

Loose planks

Timber tracks

0263 2/2