

Sketch Shewing Aft and Fore Hatchways of S.S. "Nautilus"

Scale - $\frac{1}{4}$ inch = 1 Foot.

H. J. Jacobs & Co.

G. I. N. Co. Works.


Deptford Augth 24. 1882.

Note. Ship before alterations to Hatchways shewn in Black


After - - - - - Tinted Red (Permanent)

Temporary - Additional Wooden Struts and Shores for present Voyage


Shewn marked thus *

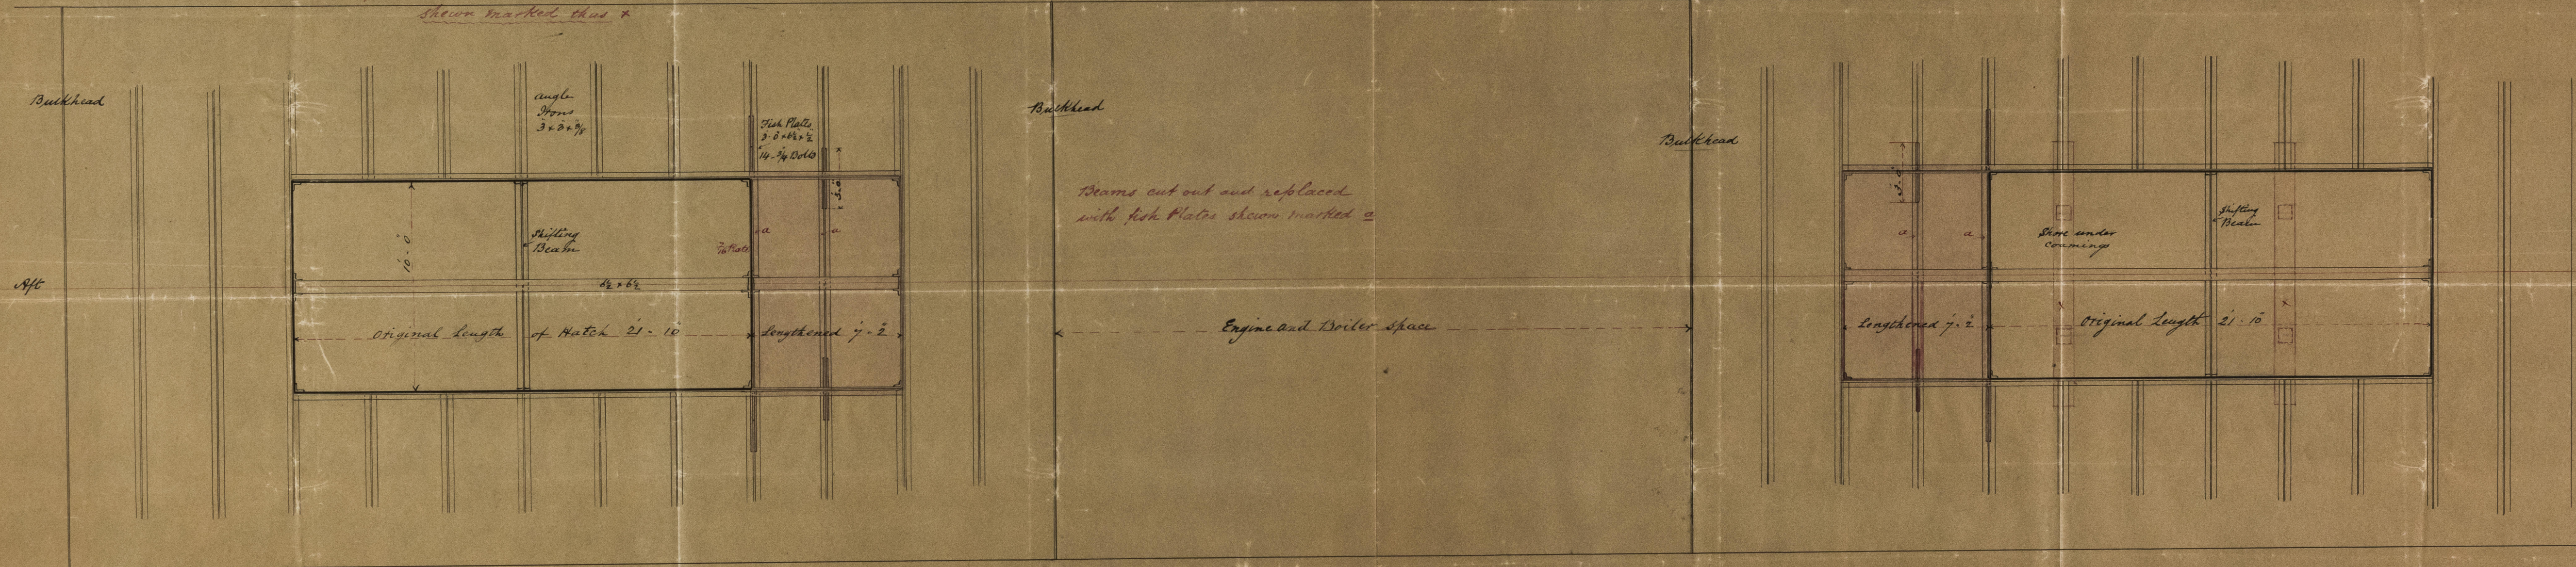


Section Through Aft Hatch

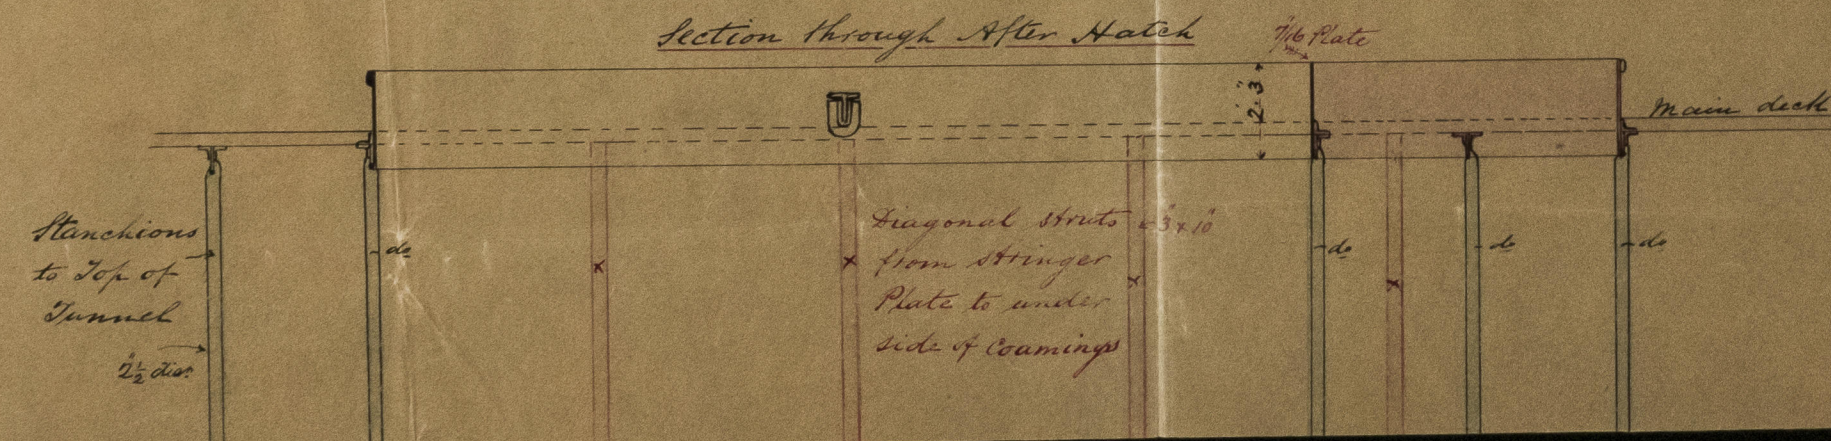

Section Through Fore Hatch

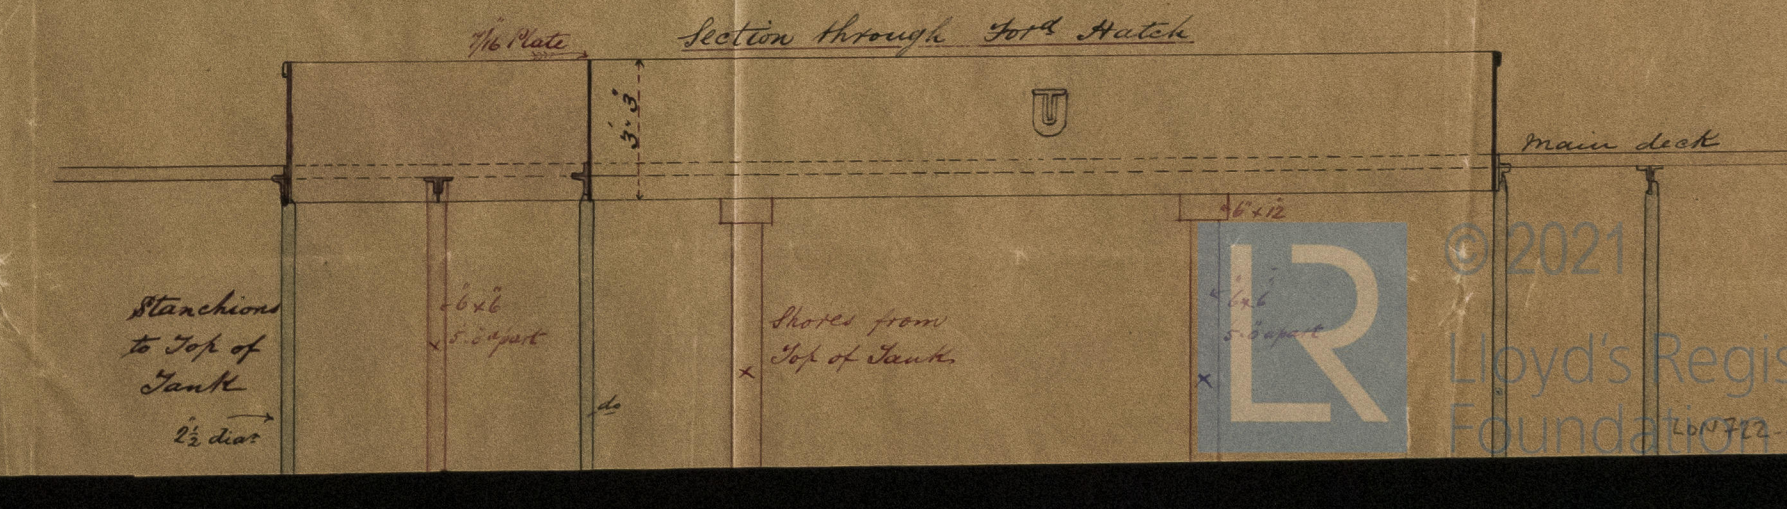

Ex^d J. W. H.

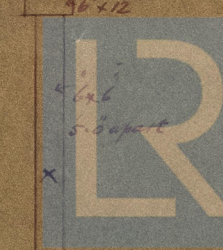

© 2021 Lloyd's Register Foundation