


27 to Builders  
8/8/83

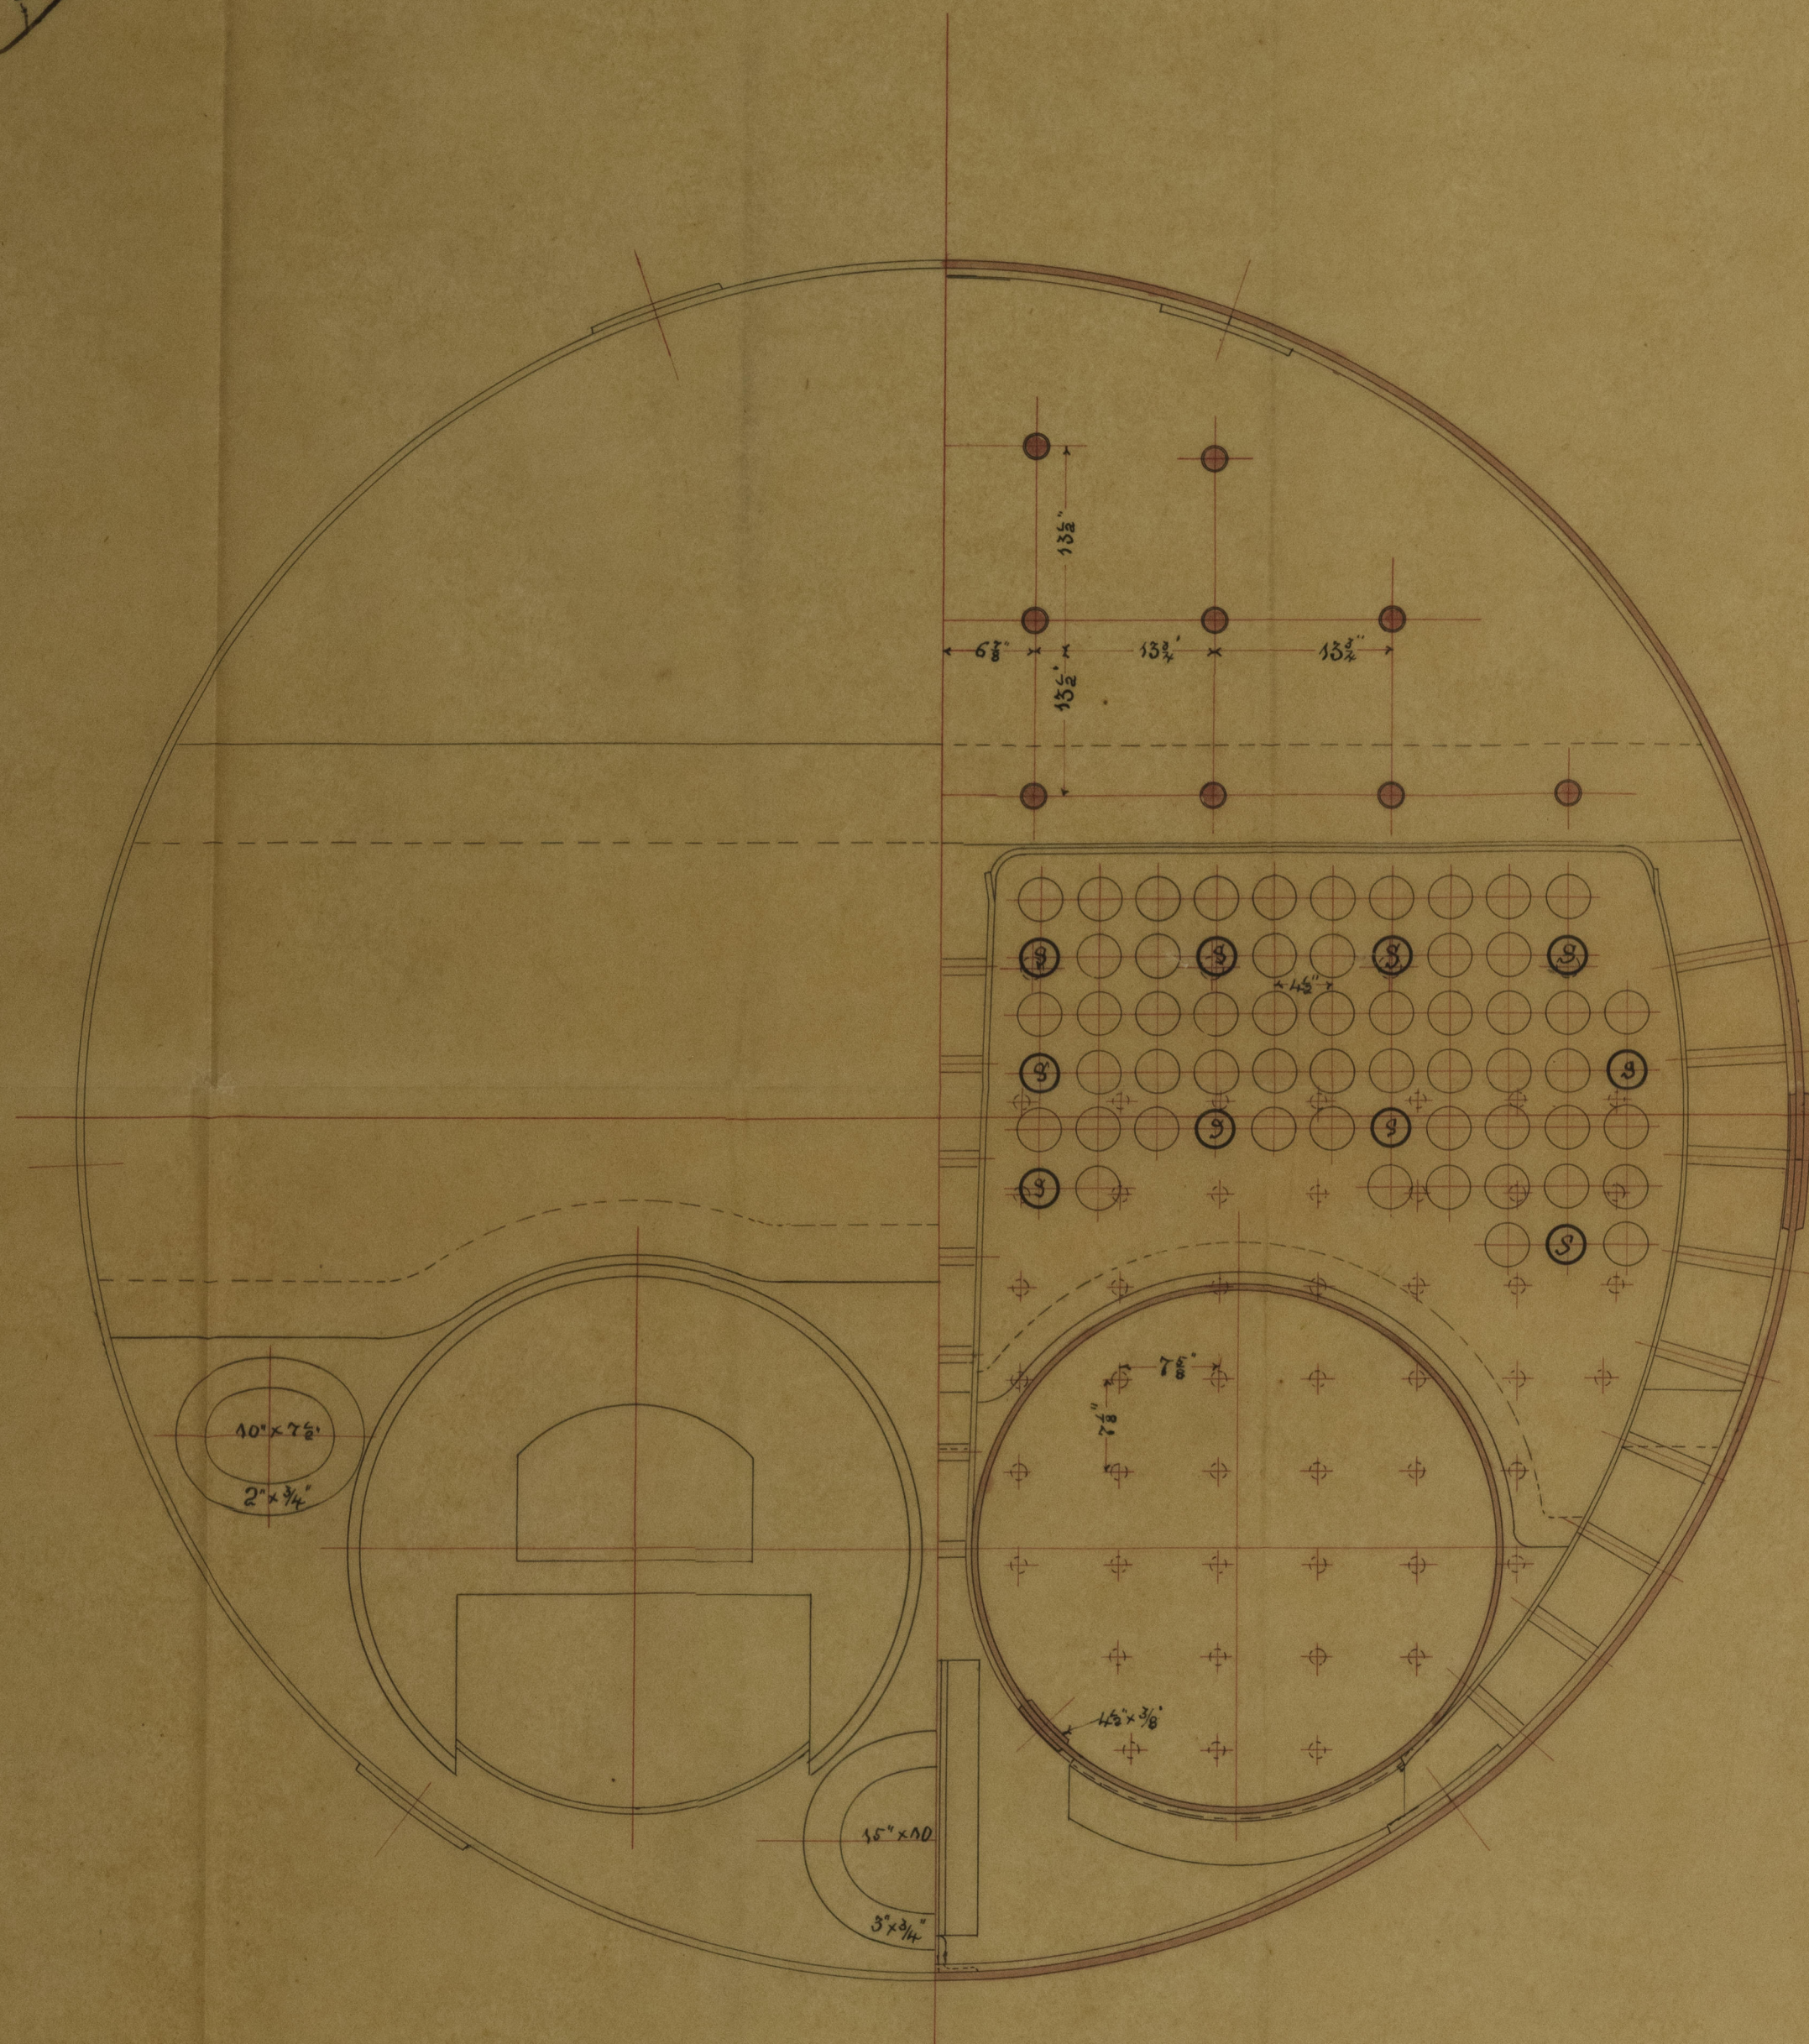


N<sup>o</sup> 2081.

14' 0" x 9' 0" Boiler for  
Messrs Forrest & Son.

for 50 lbs. Working Pressure.

Scale 1" = 1 foot.

All Steel except tubes.

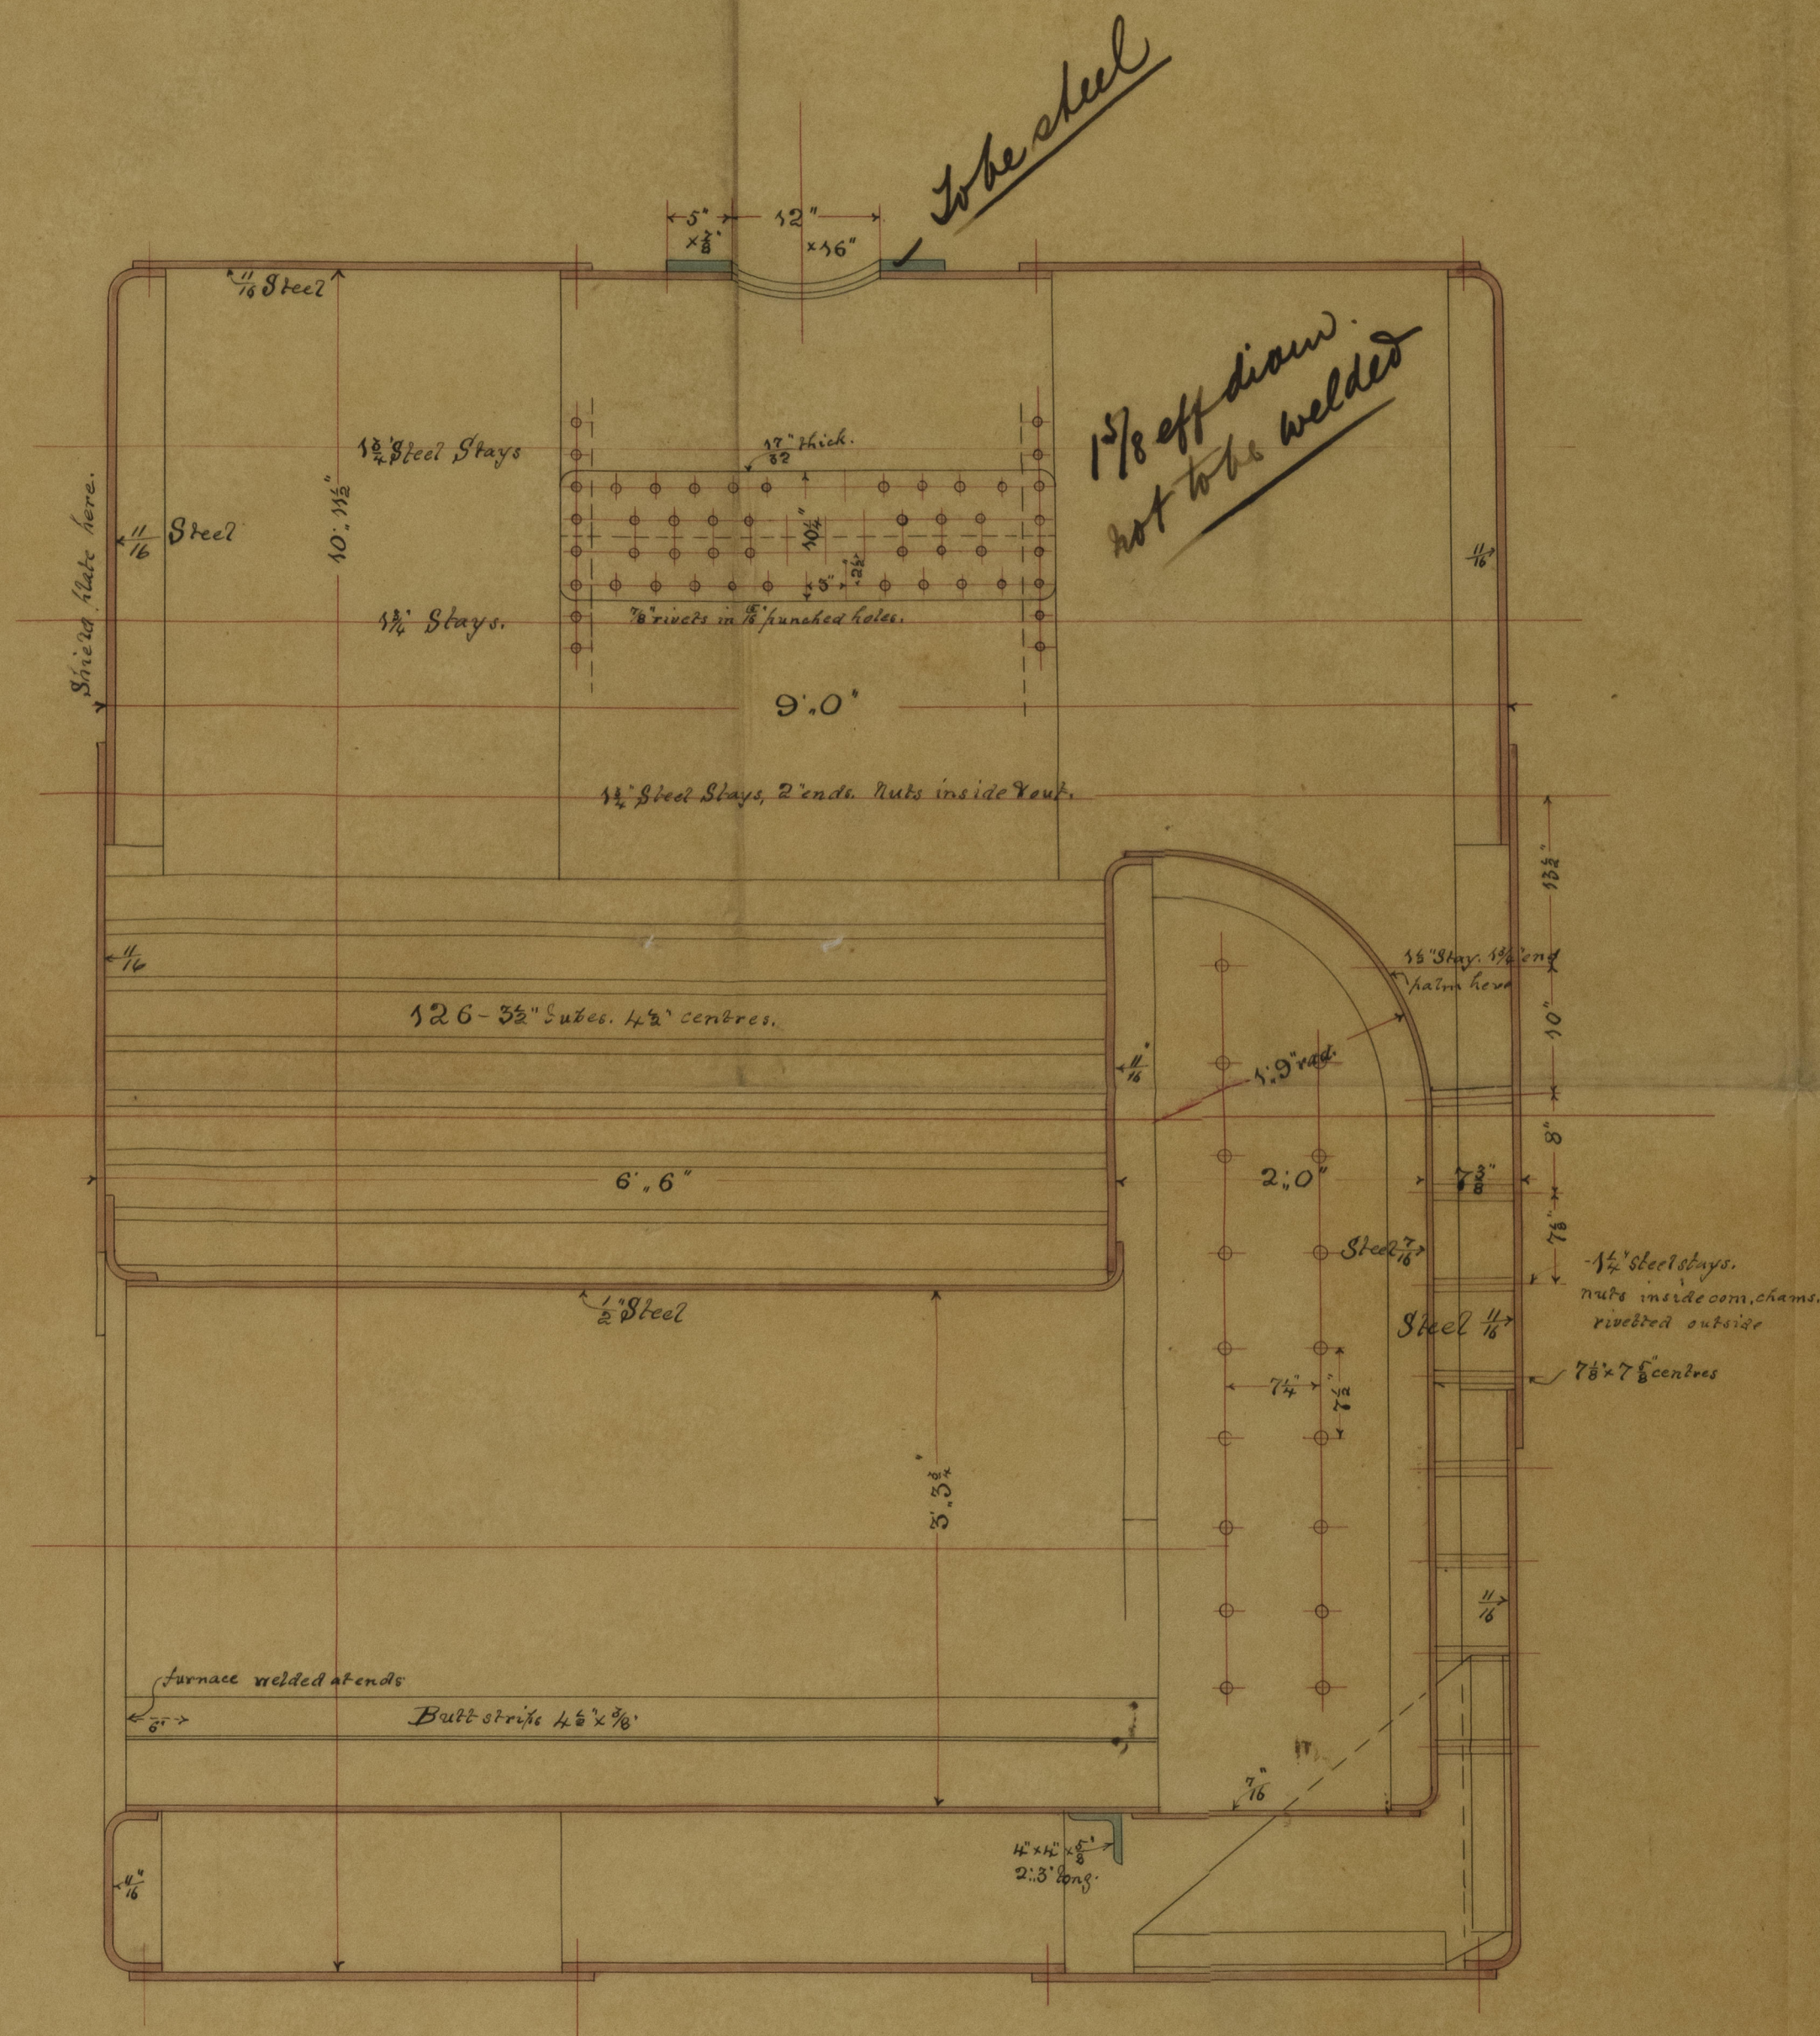

To be steel

1 1/8 off diam.  
not to be welded

M.  
8/8/83

7 AUG 83