

(Unaltered sketch)

Let: to the London Dry Dock
Company Limited

13/11/83.

14/2/84.

S.S. No. 17

Principal Dimensions

Length between Perpendiculars 135' 0"

Breadth Moulded 22' 0"

Depth 10' 8"

Scale 1/2" = 1 Foot


Bridge Deck

Iron 5/16"

3 1/2 x 2 1/2 x 5/16"

Main Deck

Quarter Deck

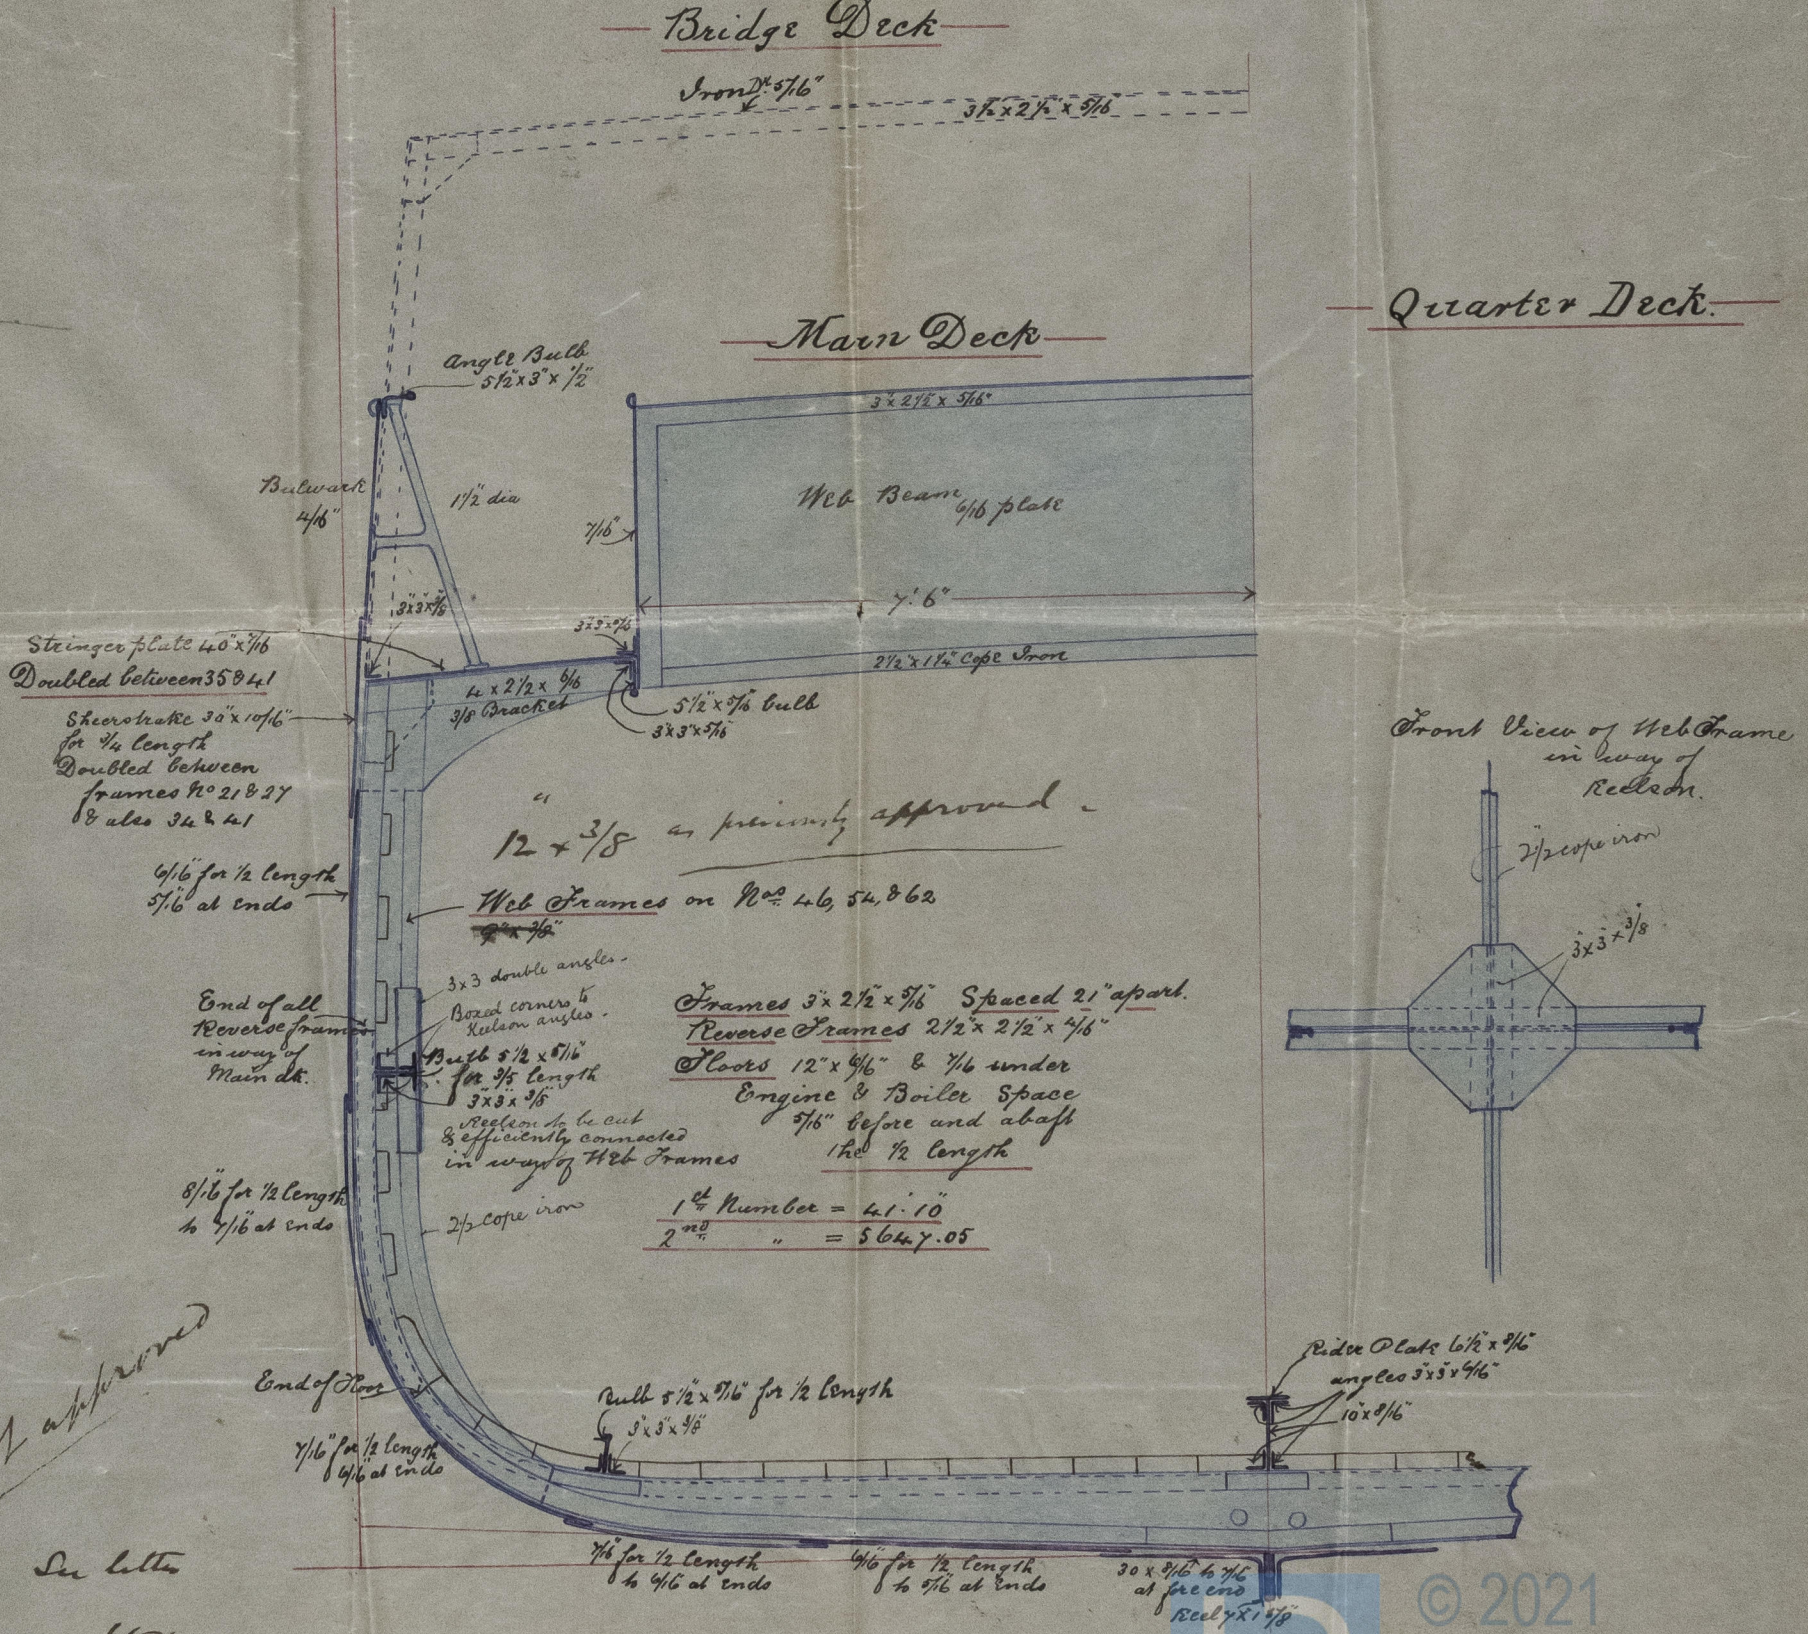

not approved

See letter

15/11/83



© 2021

Lloyd's Register Foundation

LDN723-0077