

2 Boilers shell - Steel.

Ltr. to makers
30/4/85.

S. S. Muthara & Dorunda

M 30/7/85



FRASER & NEAVE
BIRMINGHAM
LONDON E.


Additional stays

SCALE 1/2 INCH TO A FOOT



Holes punched
after bending
and then removed
out to the next ribs

Landora Siemens Steel

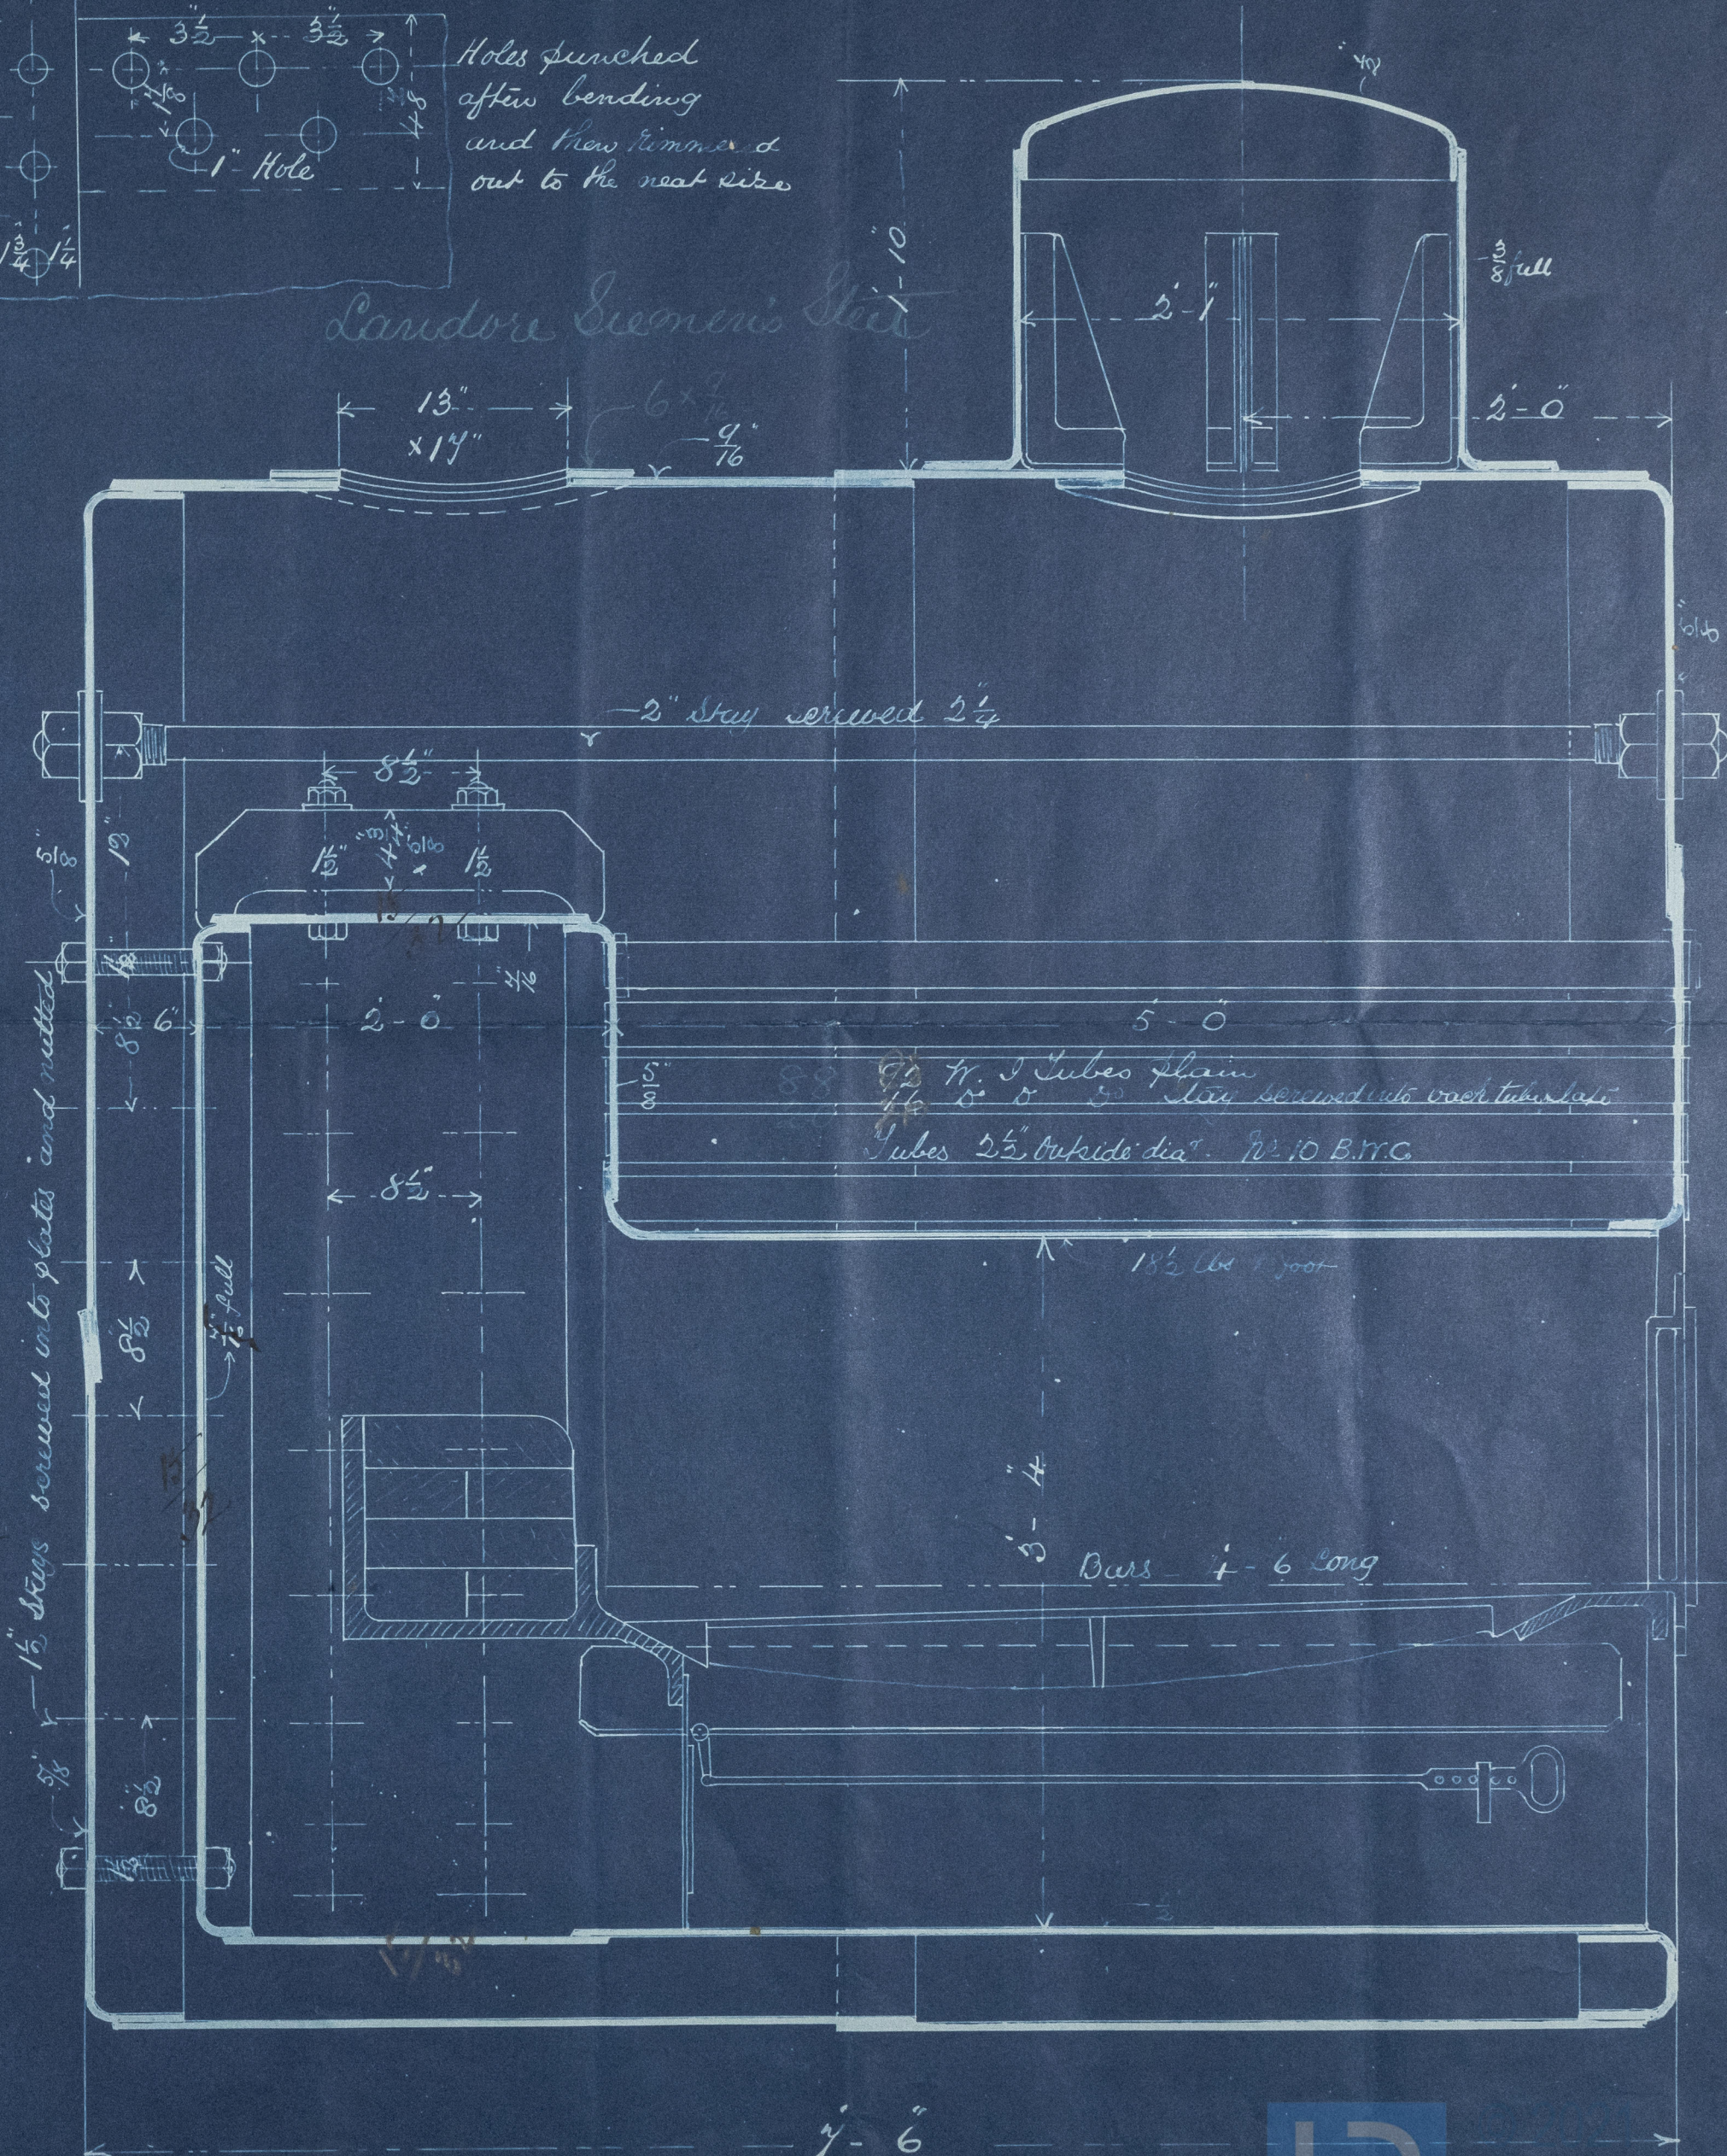

To be fitted with manholes mudholes Furnace doors & frames - bars, bridges and uptake Patent safety valve, Steam stop valve
4 inch check valve with screw down spindle screw blow off and salinometer cocks Compound pillar water gauge with
test cocks & pressure gauge - Working pressure 80 lbs Reg. in. To be tested to 130 lbs Reg. in.



Lloyd's Register
Foundation