

Ch 2.4.90





# S.S. "Goor kha",

## Steel Donkey Boiler.

Working Pressure, 80 lbs. Scale  $\frac{1}{2}'' = 1'$ .

Hydraulic Test. 160 lbs.

March 28<sup>th</sup> 1890,

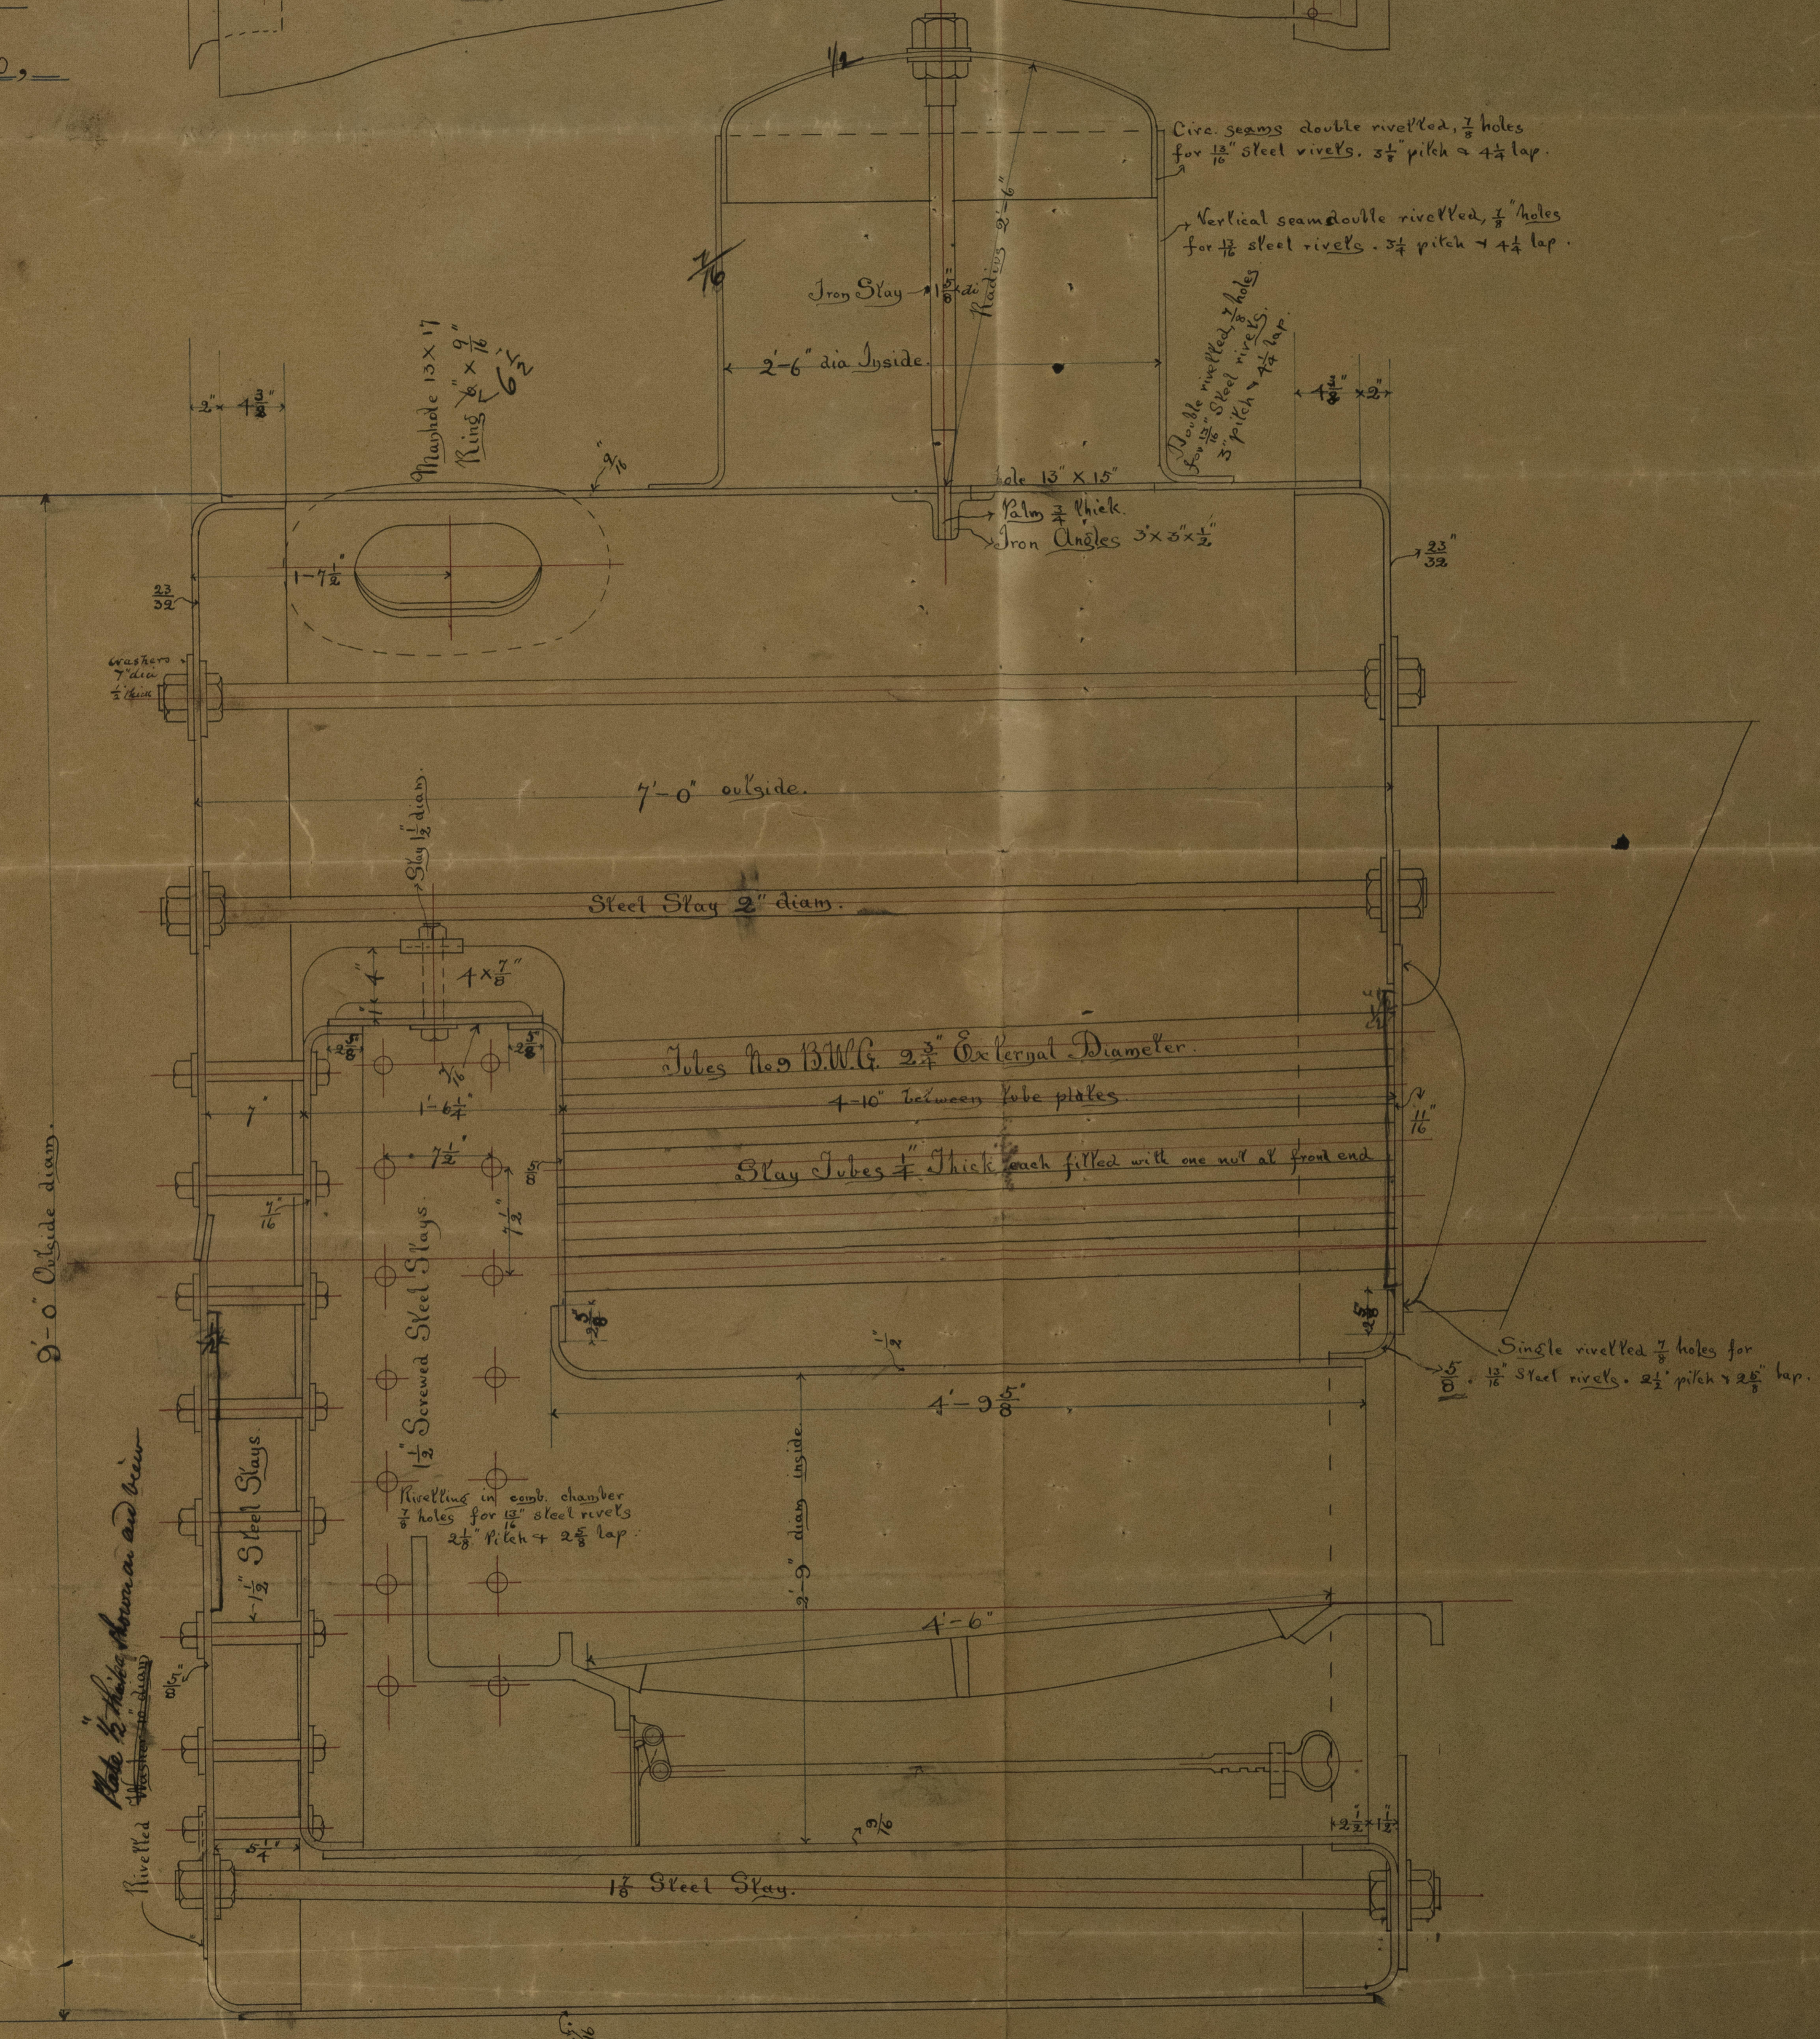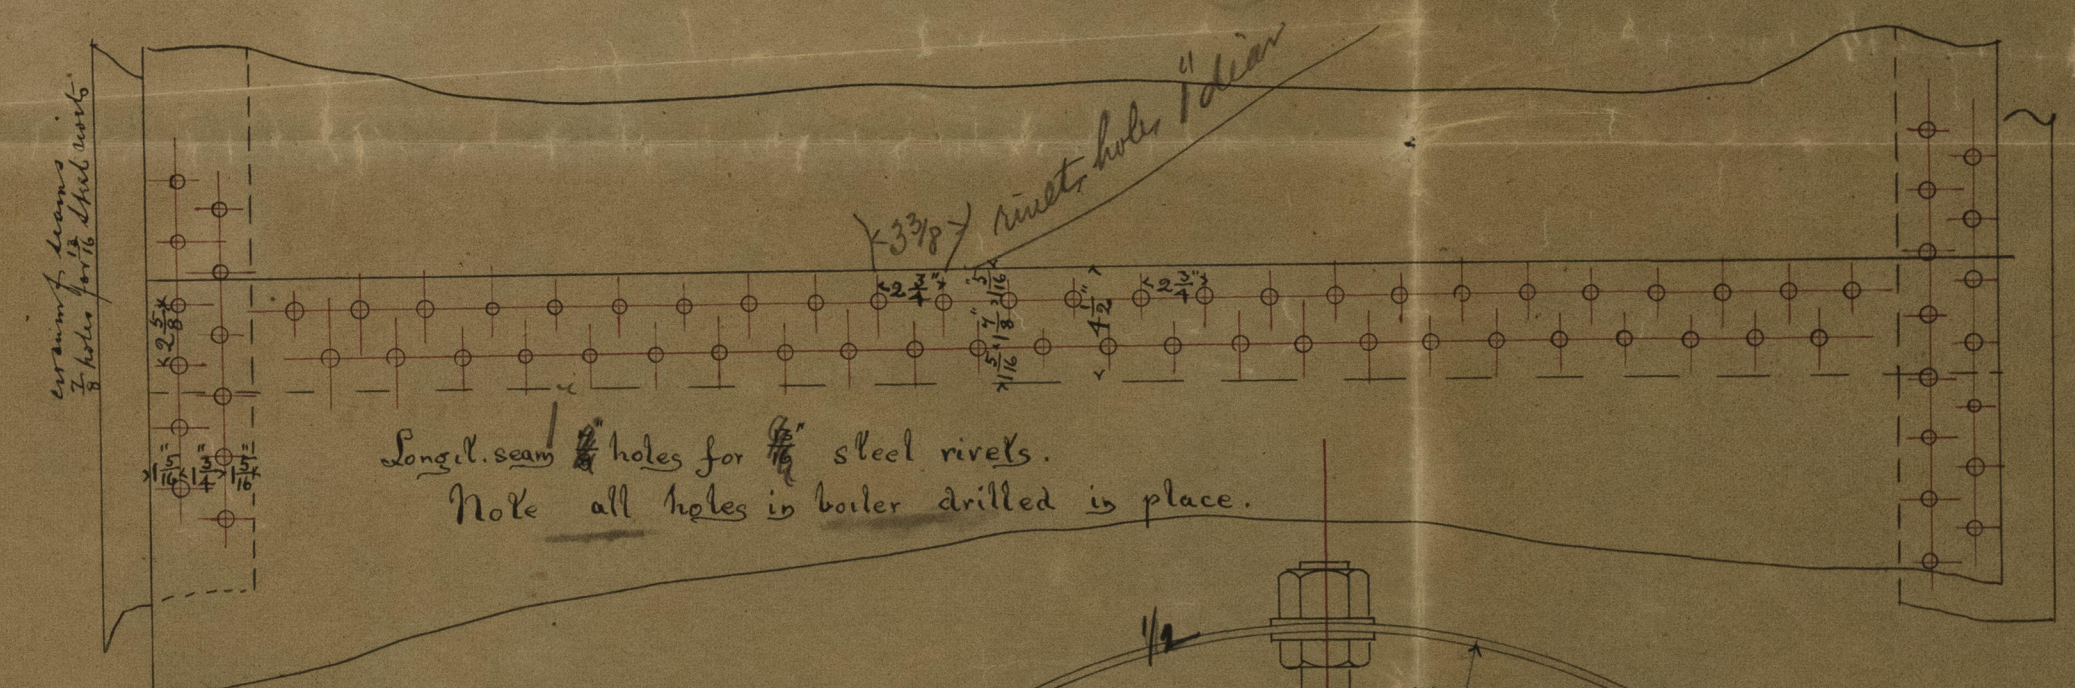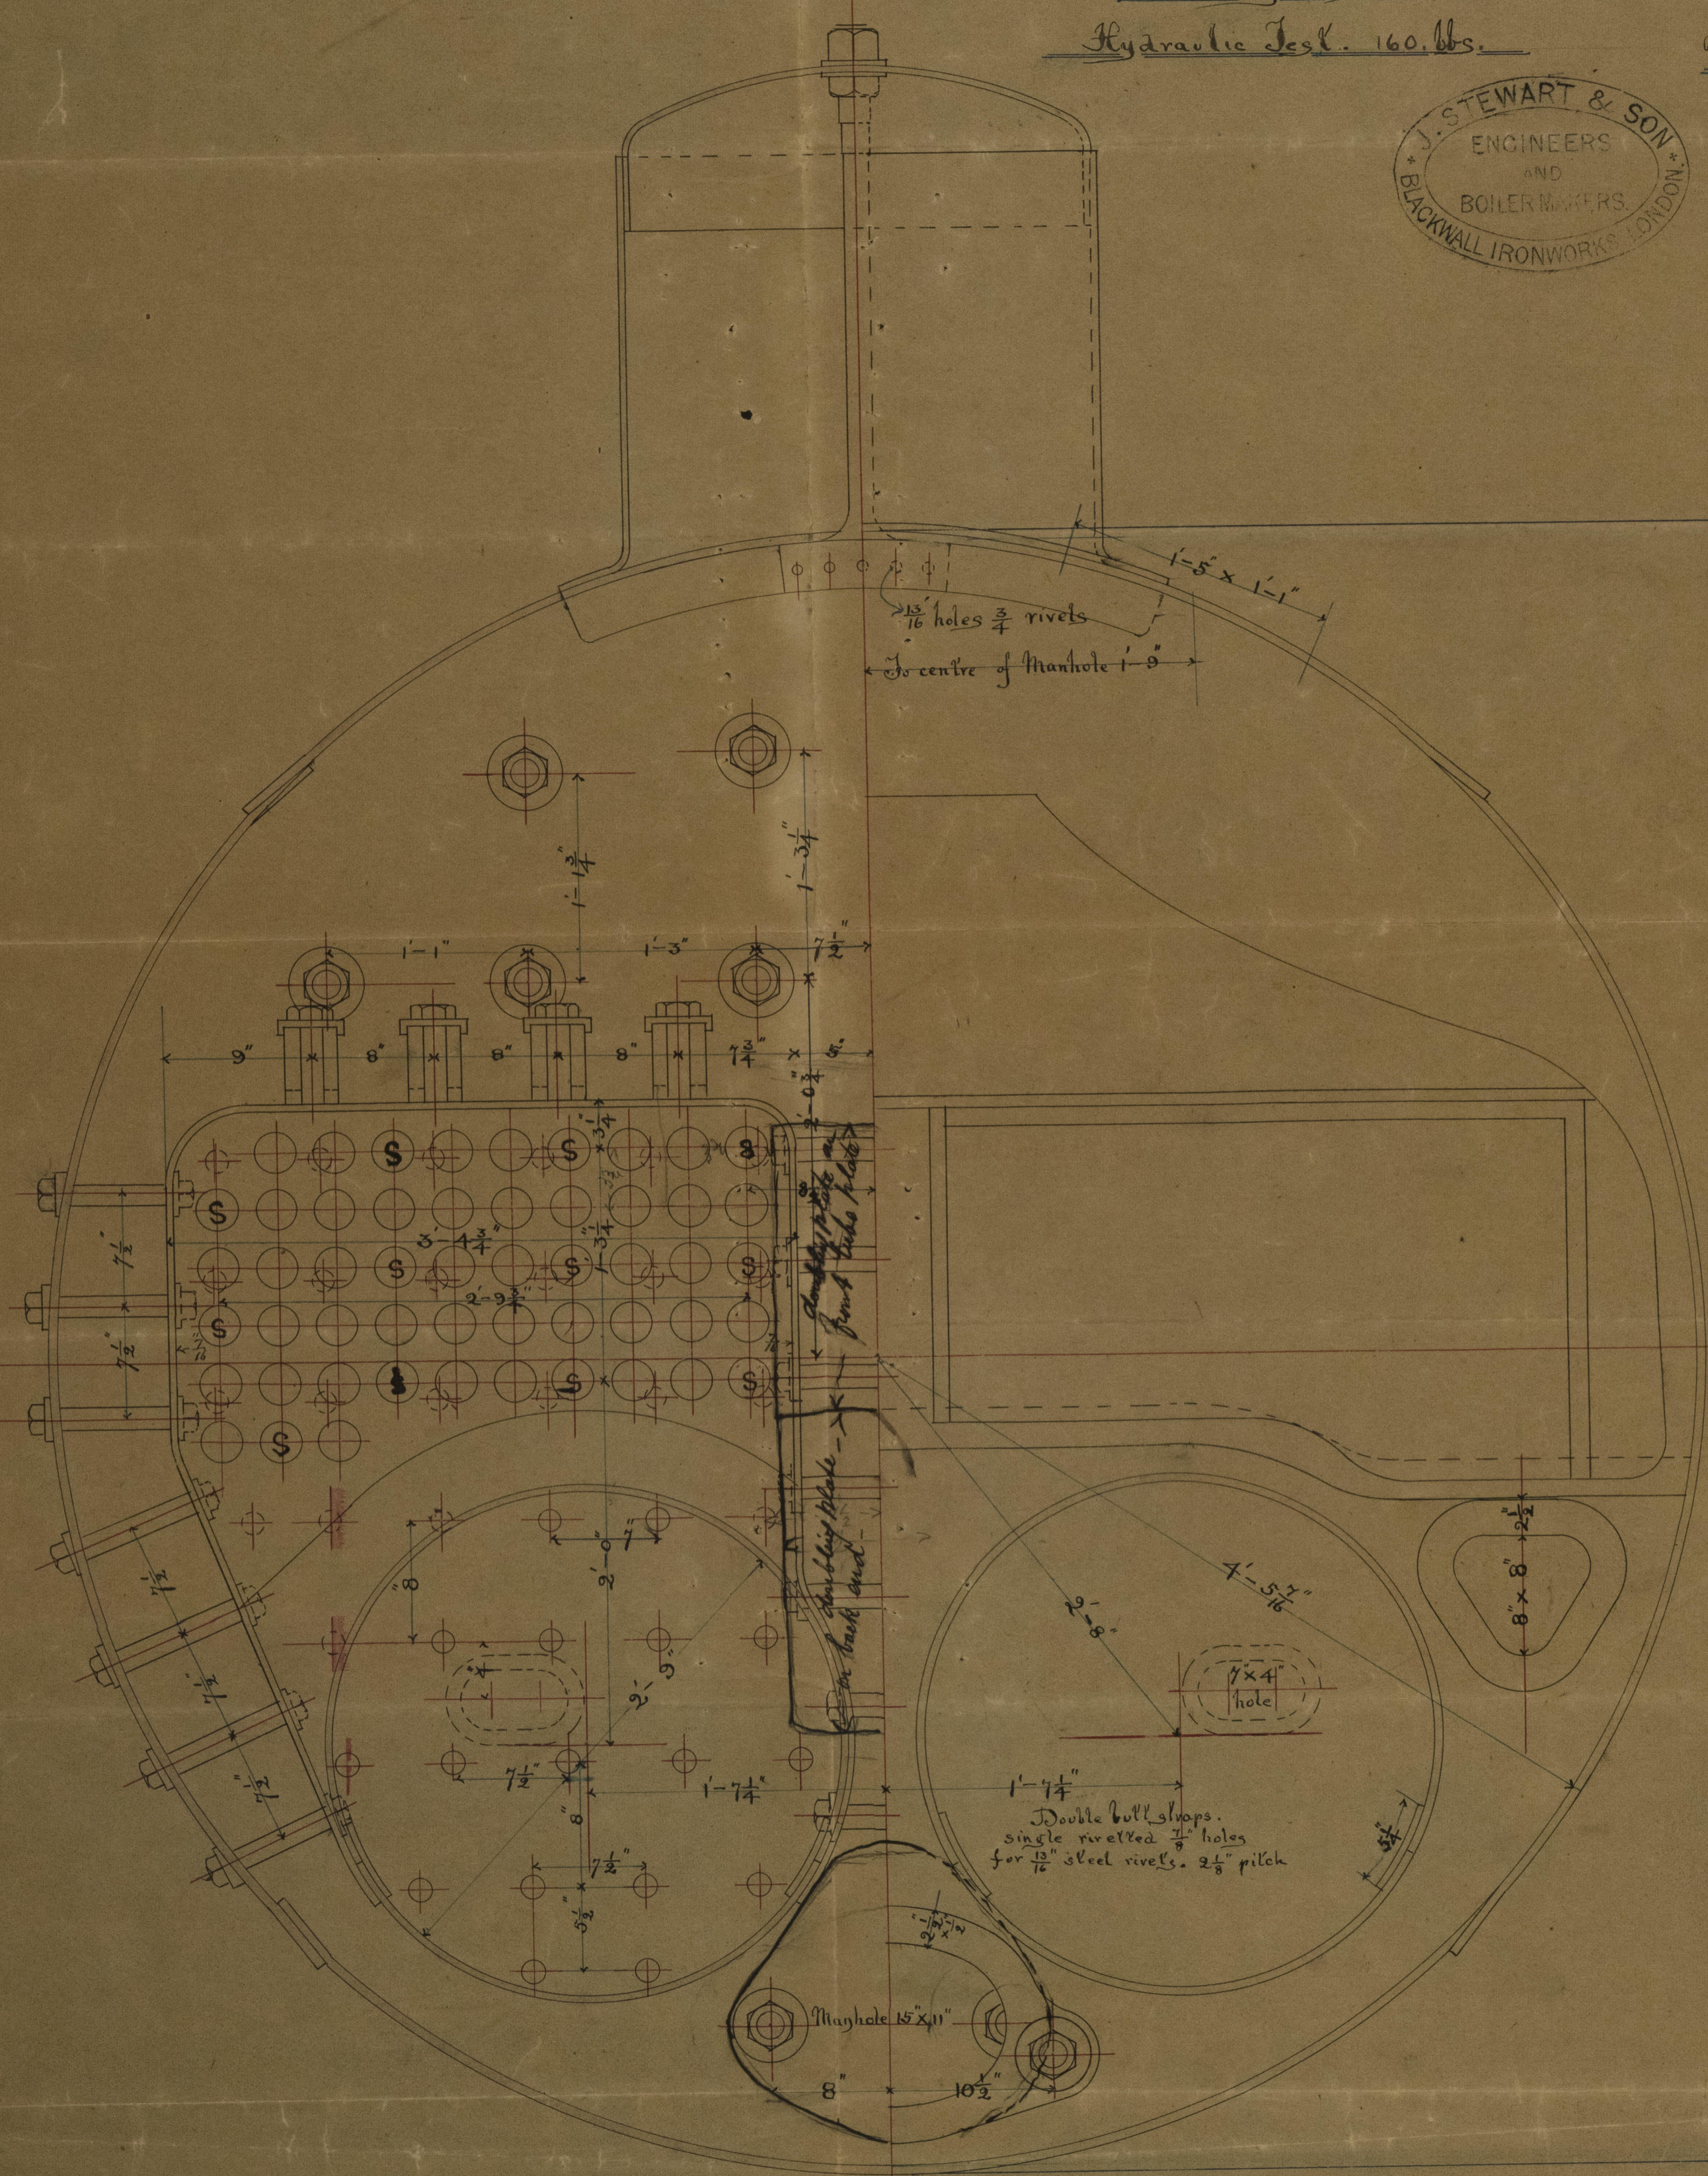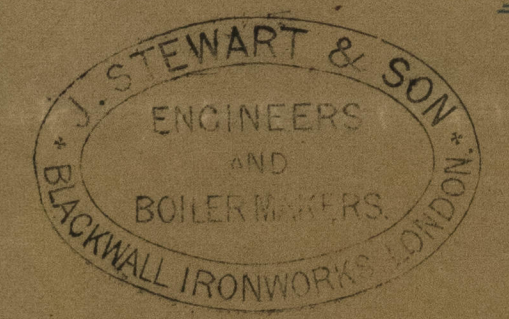

N.A.  
2.4.90