




Sketch A.

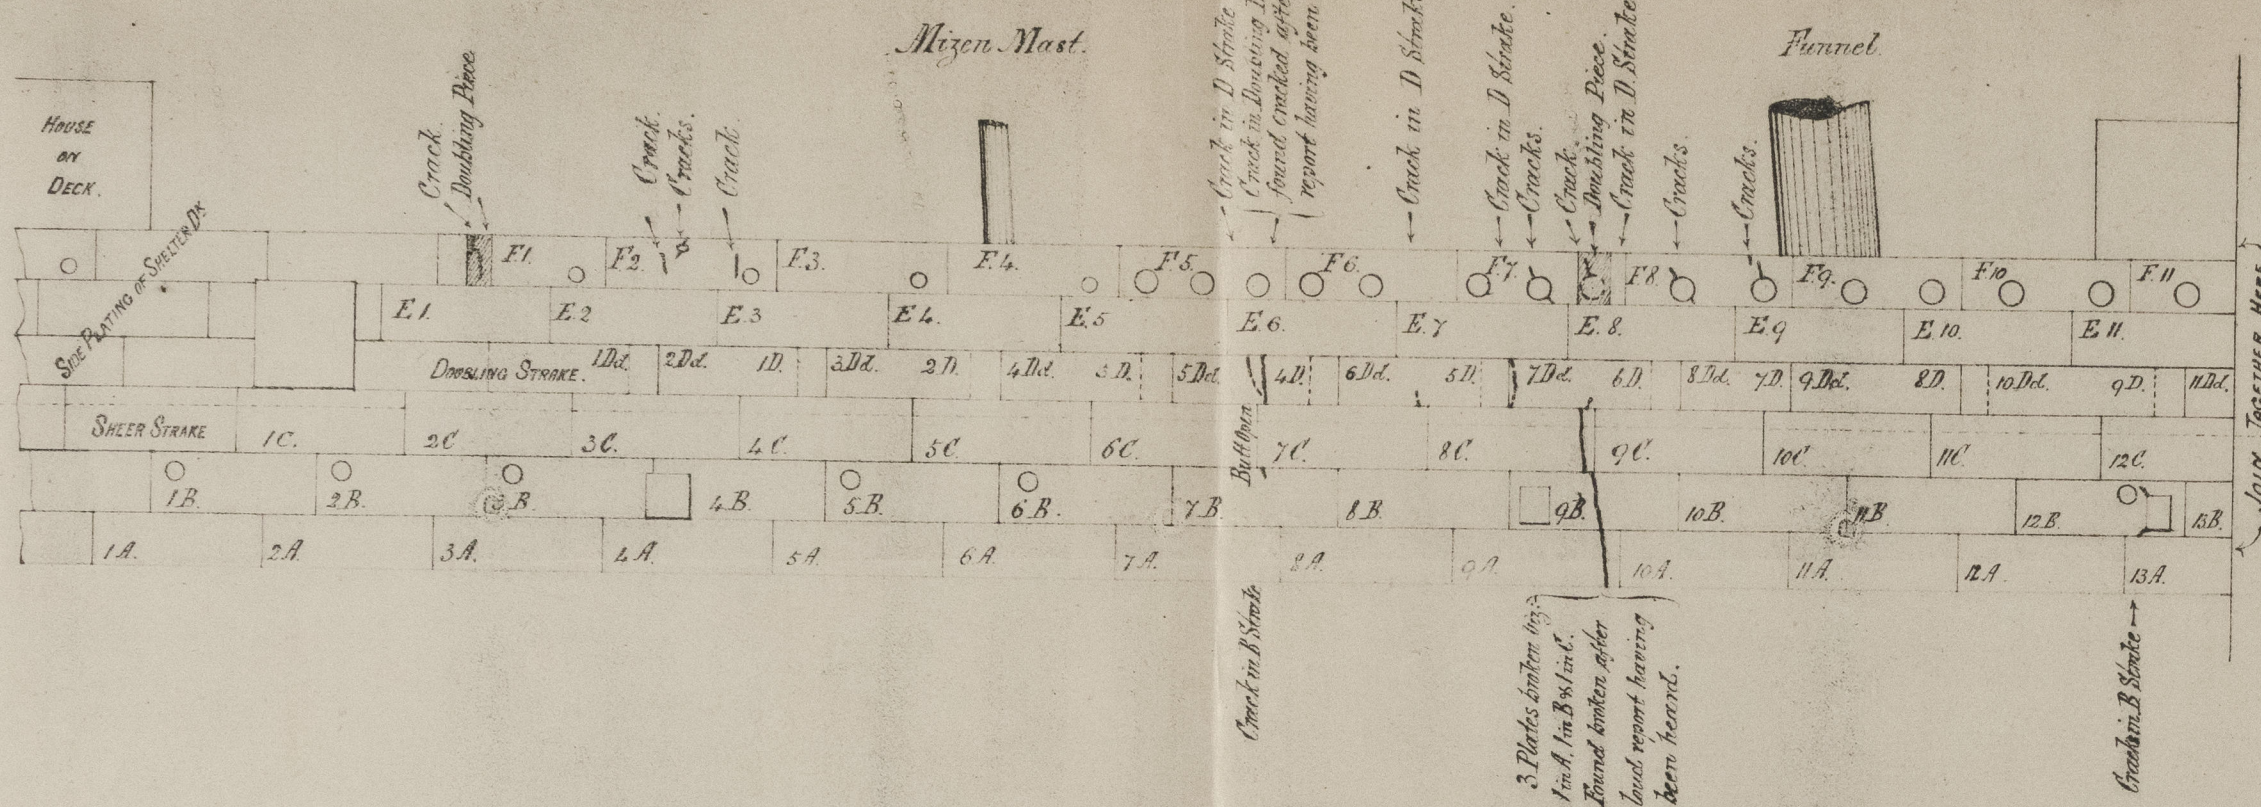

Sketch C.

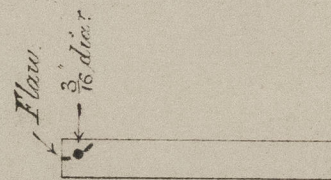

B.
Sketch

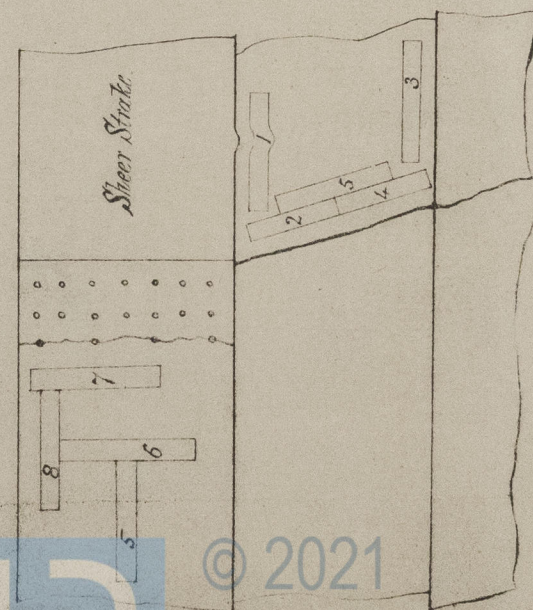

Light House.

