


Dr. to Bear.
 5.5.89.


London Reports 1880* & 1881*

MIDSHIP SECTION of STEAMER for the GREENWICH FERRY CO

Scale $\frac{3}{4}$ = one foot

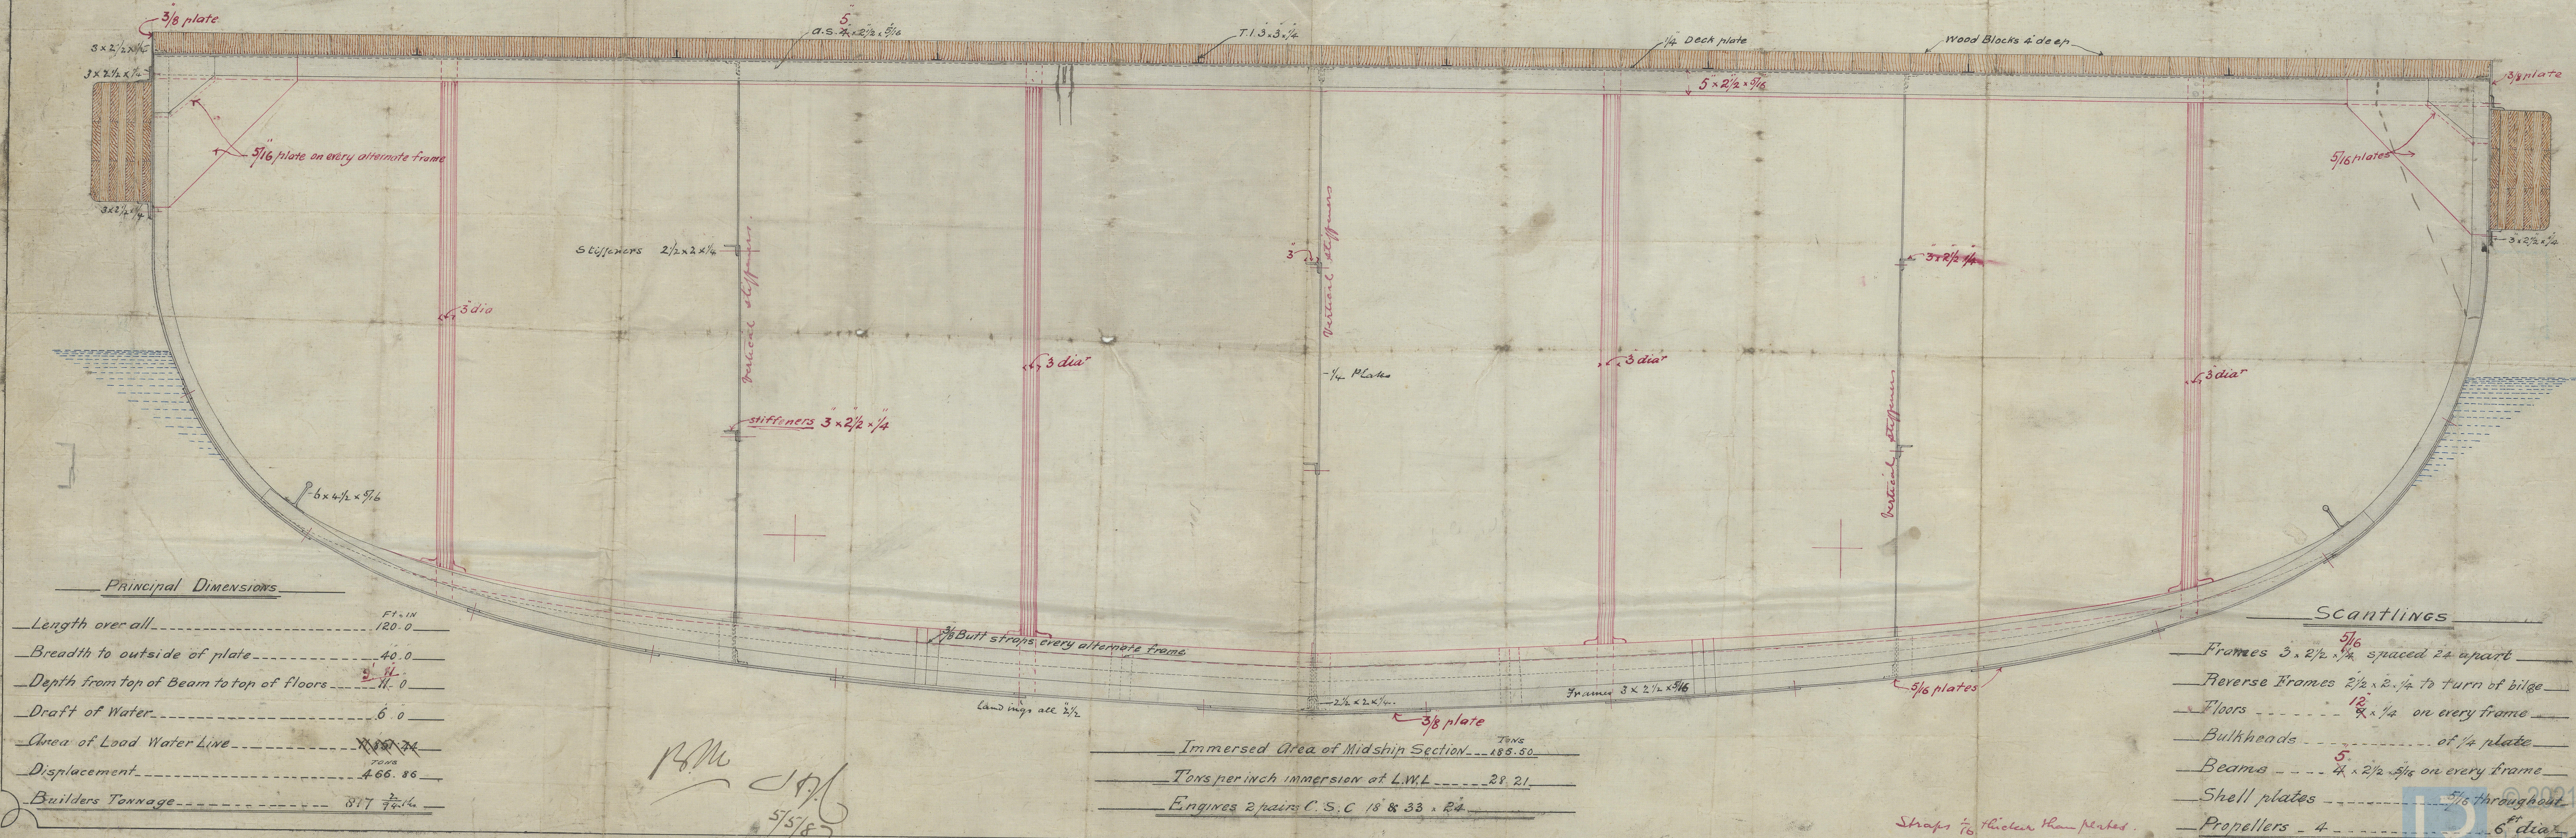

Straps $\frac{1}{16}$ thicker than plates.

RECEIVED
14 MAY 87
LLOYD'S REGISTER OF SHIPBUILDERS

MIDSHIP SECTION OF STEAMER

Handwritten signature

18 May 87

18 May 87



Length overall
Breadth at outside of plates
Depth from top of beam to top of floor
Draft of water
Displacement
Speed
Horsepower



© 2021
Lloyd's Register
Foundation