

# Lloyd's Register of British and Foreign Shipping.

(Report on Vessel No. <sup>48880\*</sup> ~~48881\*~~ Port London)

## No. 444A SHIP FORGINGS OR CASTINGS.

I have to report that the undermentioned Iron or ~~Steel~~ Forgings or Castings, manufactured by Messrs R. S. Bagnall Sons of Weyton <sup>Endonwich Ferry Works</sup> for the Vessel No. \_\_\_\_\_, being built by Messrs Steward & Latham of London have been inspected by me as set forth below, and found to be, so far as can be seen, sound.

The words FORGINGS or CASTINGS, IRON or STEEL, should be struck out as may be required.


Mark on Forgings.

Lloyd's  
No. 444A  
R.S.


Hugh Cameron  
Sunderland  
10/1/88

	STERN FRAME.	RUDDER FRAME.	STEM.
Material* - - - -		<u>Scrap iron</u>	
How made - - - -		<u>Fayed</u>	
Dimensions - - - -		<u>as per sketch</u>	
Progress on Inspection -		<u>Fayed &amp; smoothed</u>	
Dates when Inspected		<u>Dec 30/87 Jan 6-10/88</u>	

SKETCHES OF FRAMES SHEWING POSITION AND DESCRIPTION OF WELDS OF FORGINGS, OR PARTICULARS OF TESTS APPLIED TO CASTINGS.

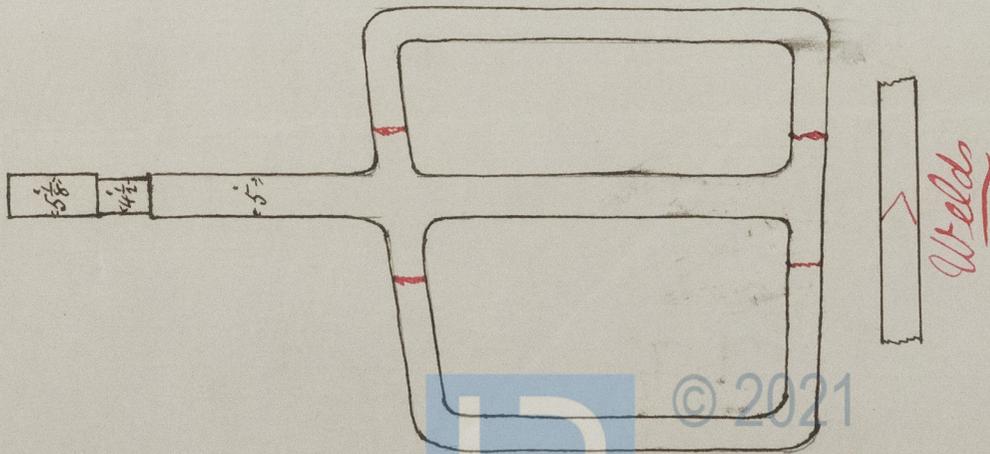

C. N. J.  
12/1/80

 






© 2021  
Lloyd's Register  
Foundation

