



Dec. 16/10/88

Duncan Gordon

Sketch showing position of ribs and arrangements for pumping bilges in vessels building by Messrs. R. & H. Green for the Woodwich Ferry.

Scale 3/4 inch = 1 foot

Dec 15 - 1888

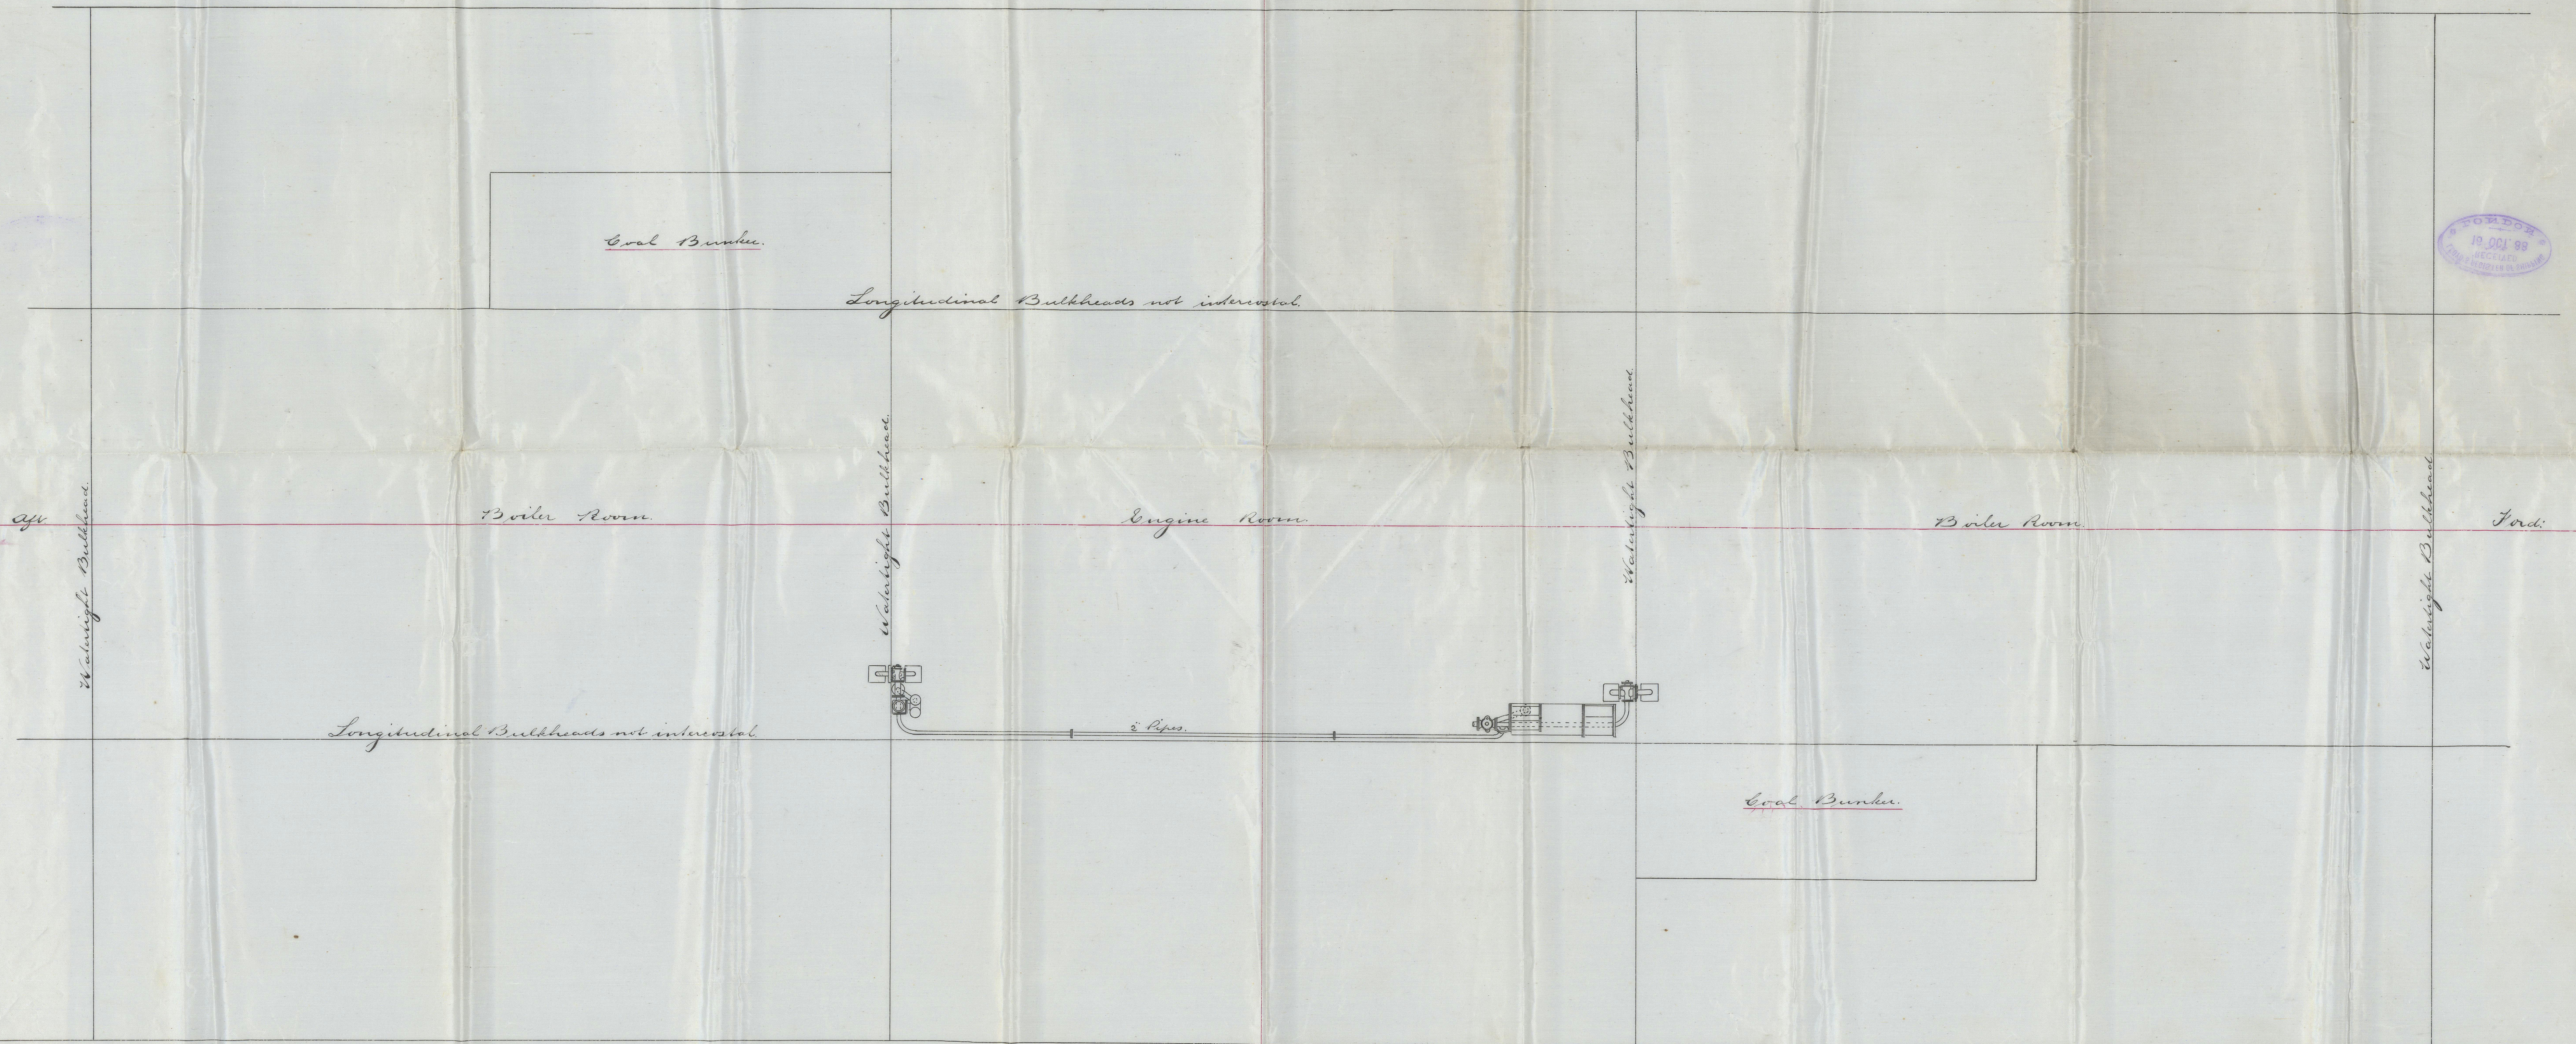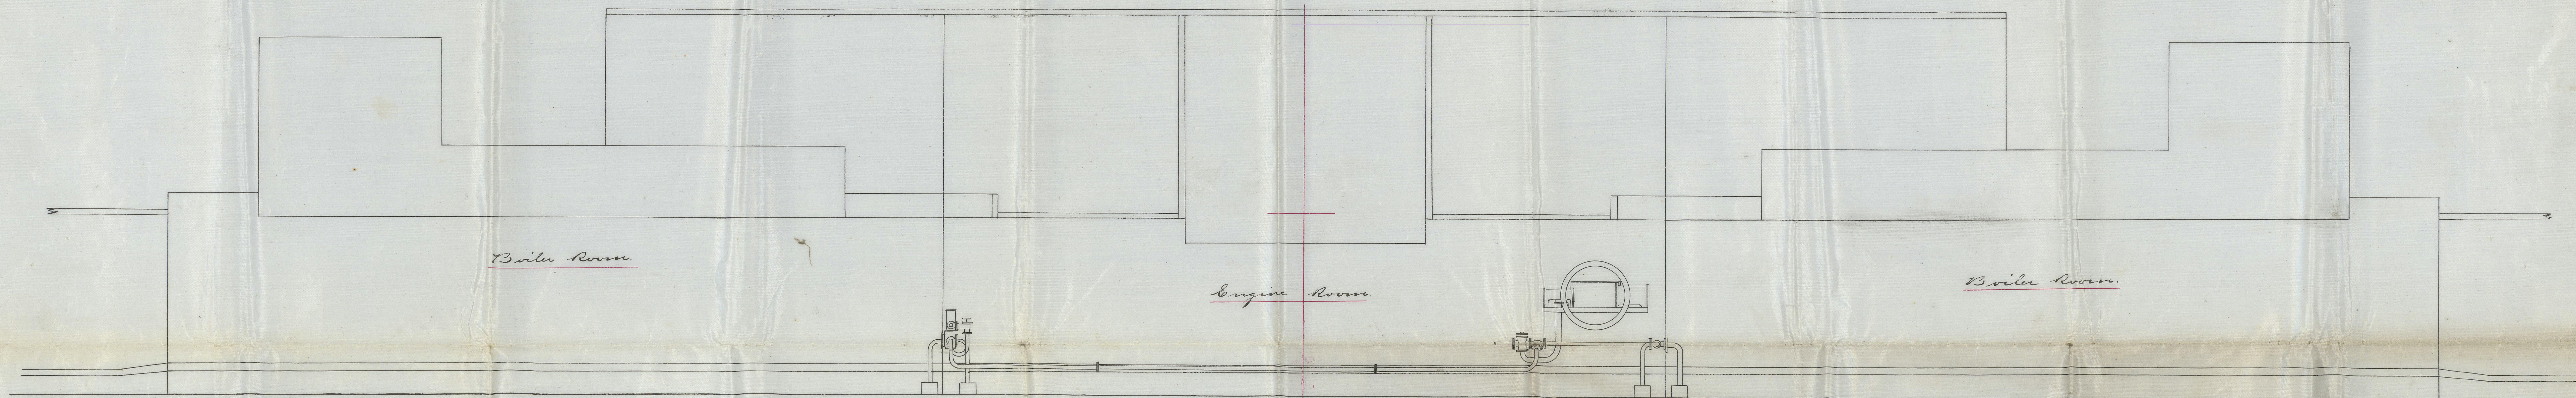

LON 724-0003



LON 724 - 0003

Duncan & Gordon

per Lloyd's R. & S. D. Duncan & Gordon

Scale of inches & feet



© 2021

Lloyd's Register
Foundation