


LONT24-0020

Duncan
and
Gordon

25/6/91

May days

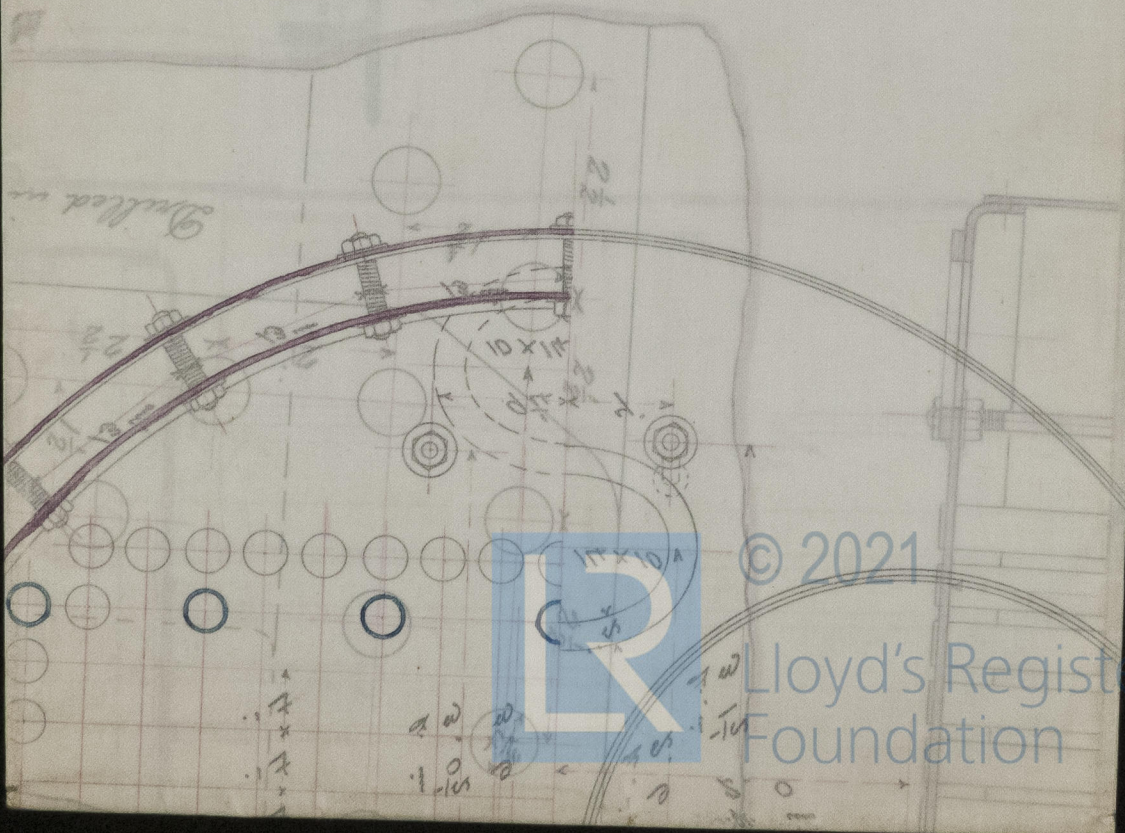

© 2021

Lloyd's Register
Foundation

