

Part: *Ships "Duncan" & "Gordon"*


London 19281

Principal Dimensions.
 Length P.P. 164' 0"
 Breadth Moulded 42' 0"
 " over Paddle Boxes. 59' 4"
 Depth Moulded 7' 0"
 Draught loaded (Mid). 4' 0"
 I. H. P. 600

Midship Section.
 of
Steam Ferry Boats.
 Nos 225 & 226.
 Scale 1/2" = one foot.

Classed for Woolwich Ferry purposes only.

*See Cr. to
 Plans.
 12.7.88.*

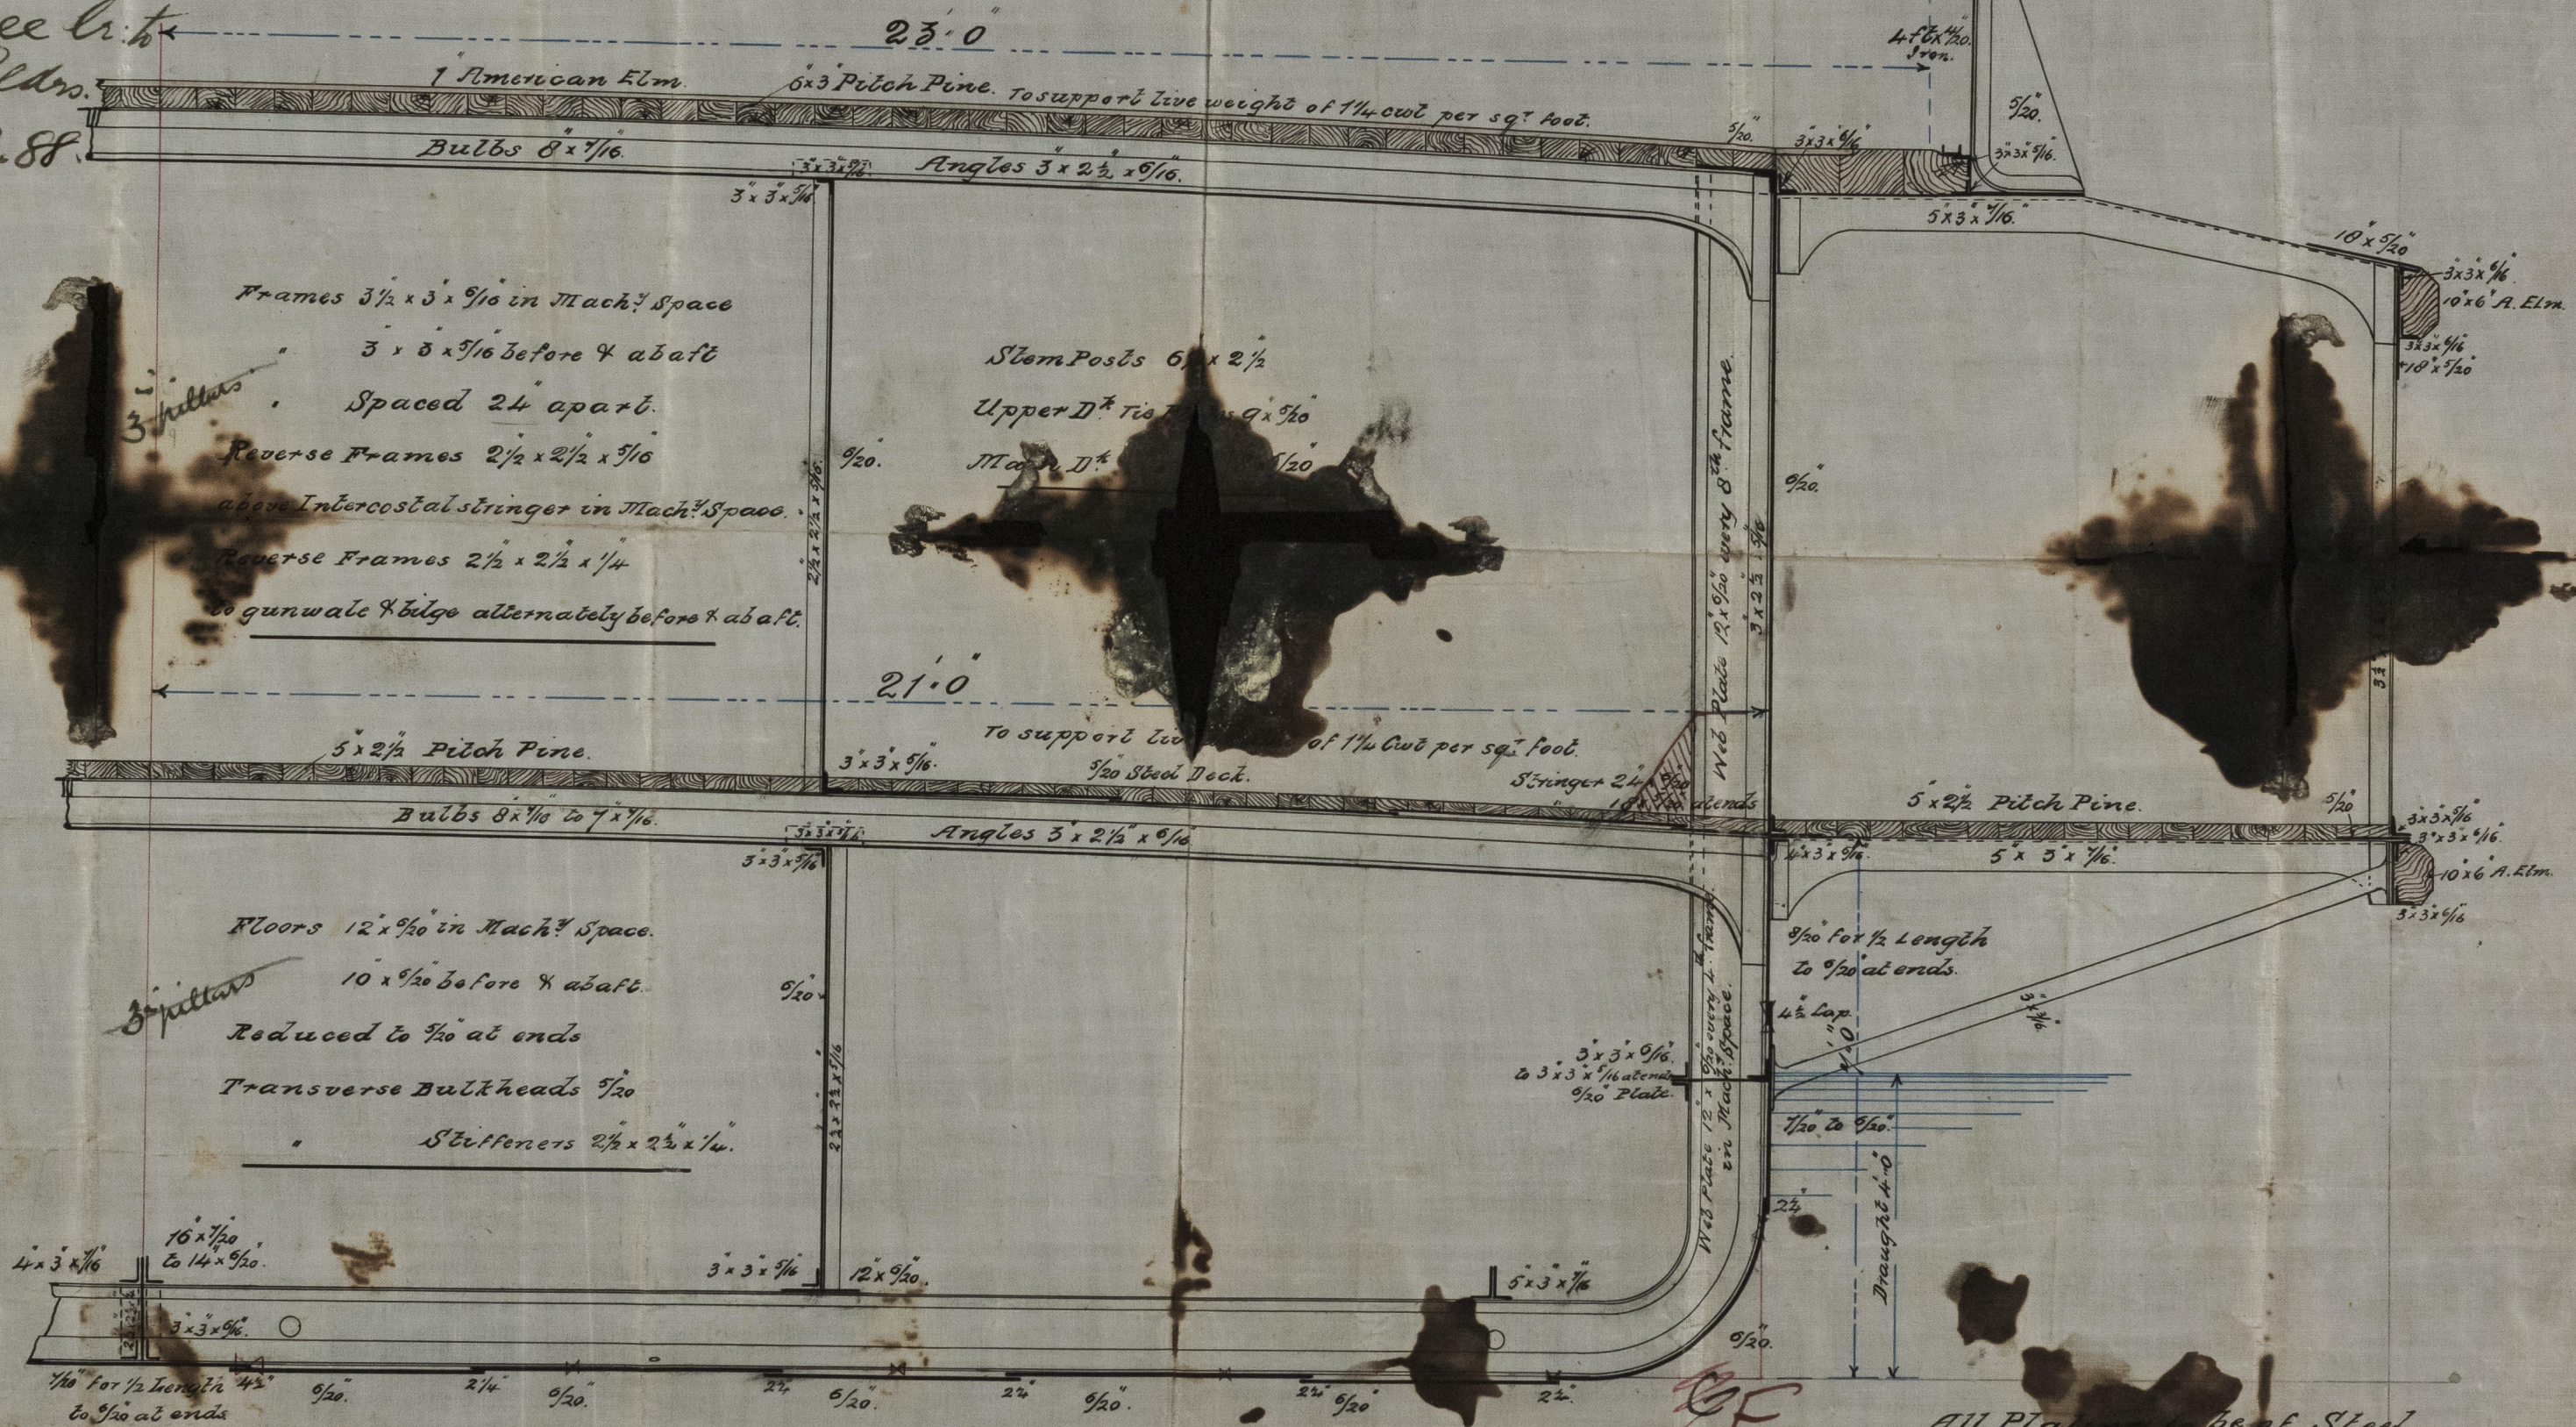

All Plating to be of Steel
 except where otherwise shown.
 Bulbs, Angles & T Bars of Iron.

London 49281

LON724-0023



© 2021

Lloyd's Register
Foundation