


Approved etc
to make 5/7/89

E. F. R. E. W. C. O. L. D.

N^o 136 A

DRAWING Spare Donkey Boiler for one of Messrs Shaw & Bushby's Boats.
DATE June 25th 1889.
SCALE 1 1/2 INCHES = 1 FOOT
DRAFTSMAN F. Rowling.

WORKING PRESSURE 60 LBS PER SQ. INCH

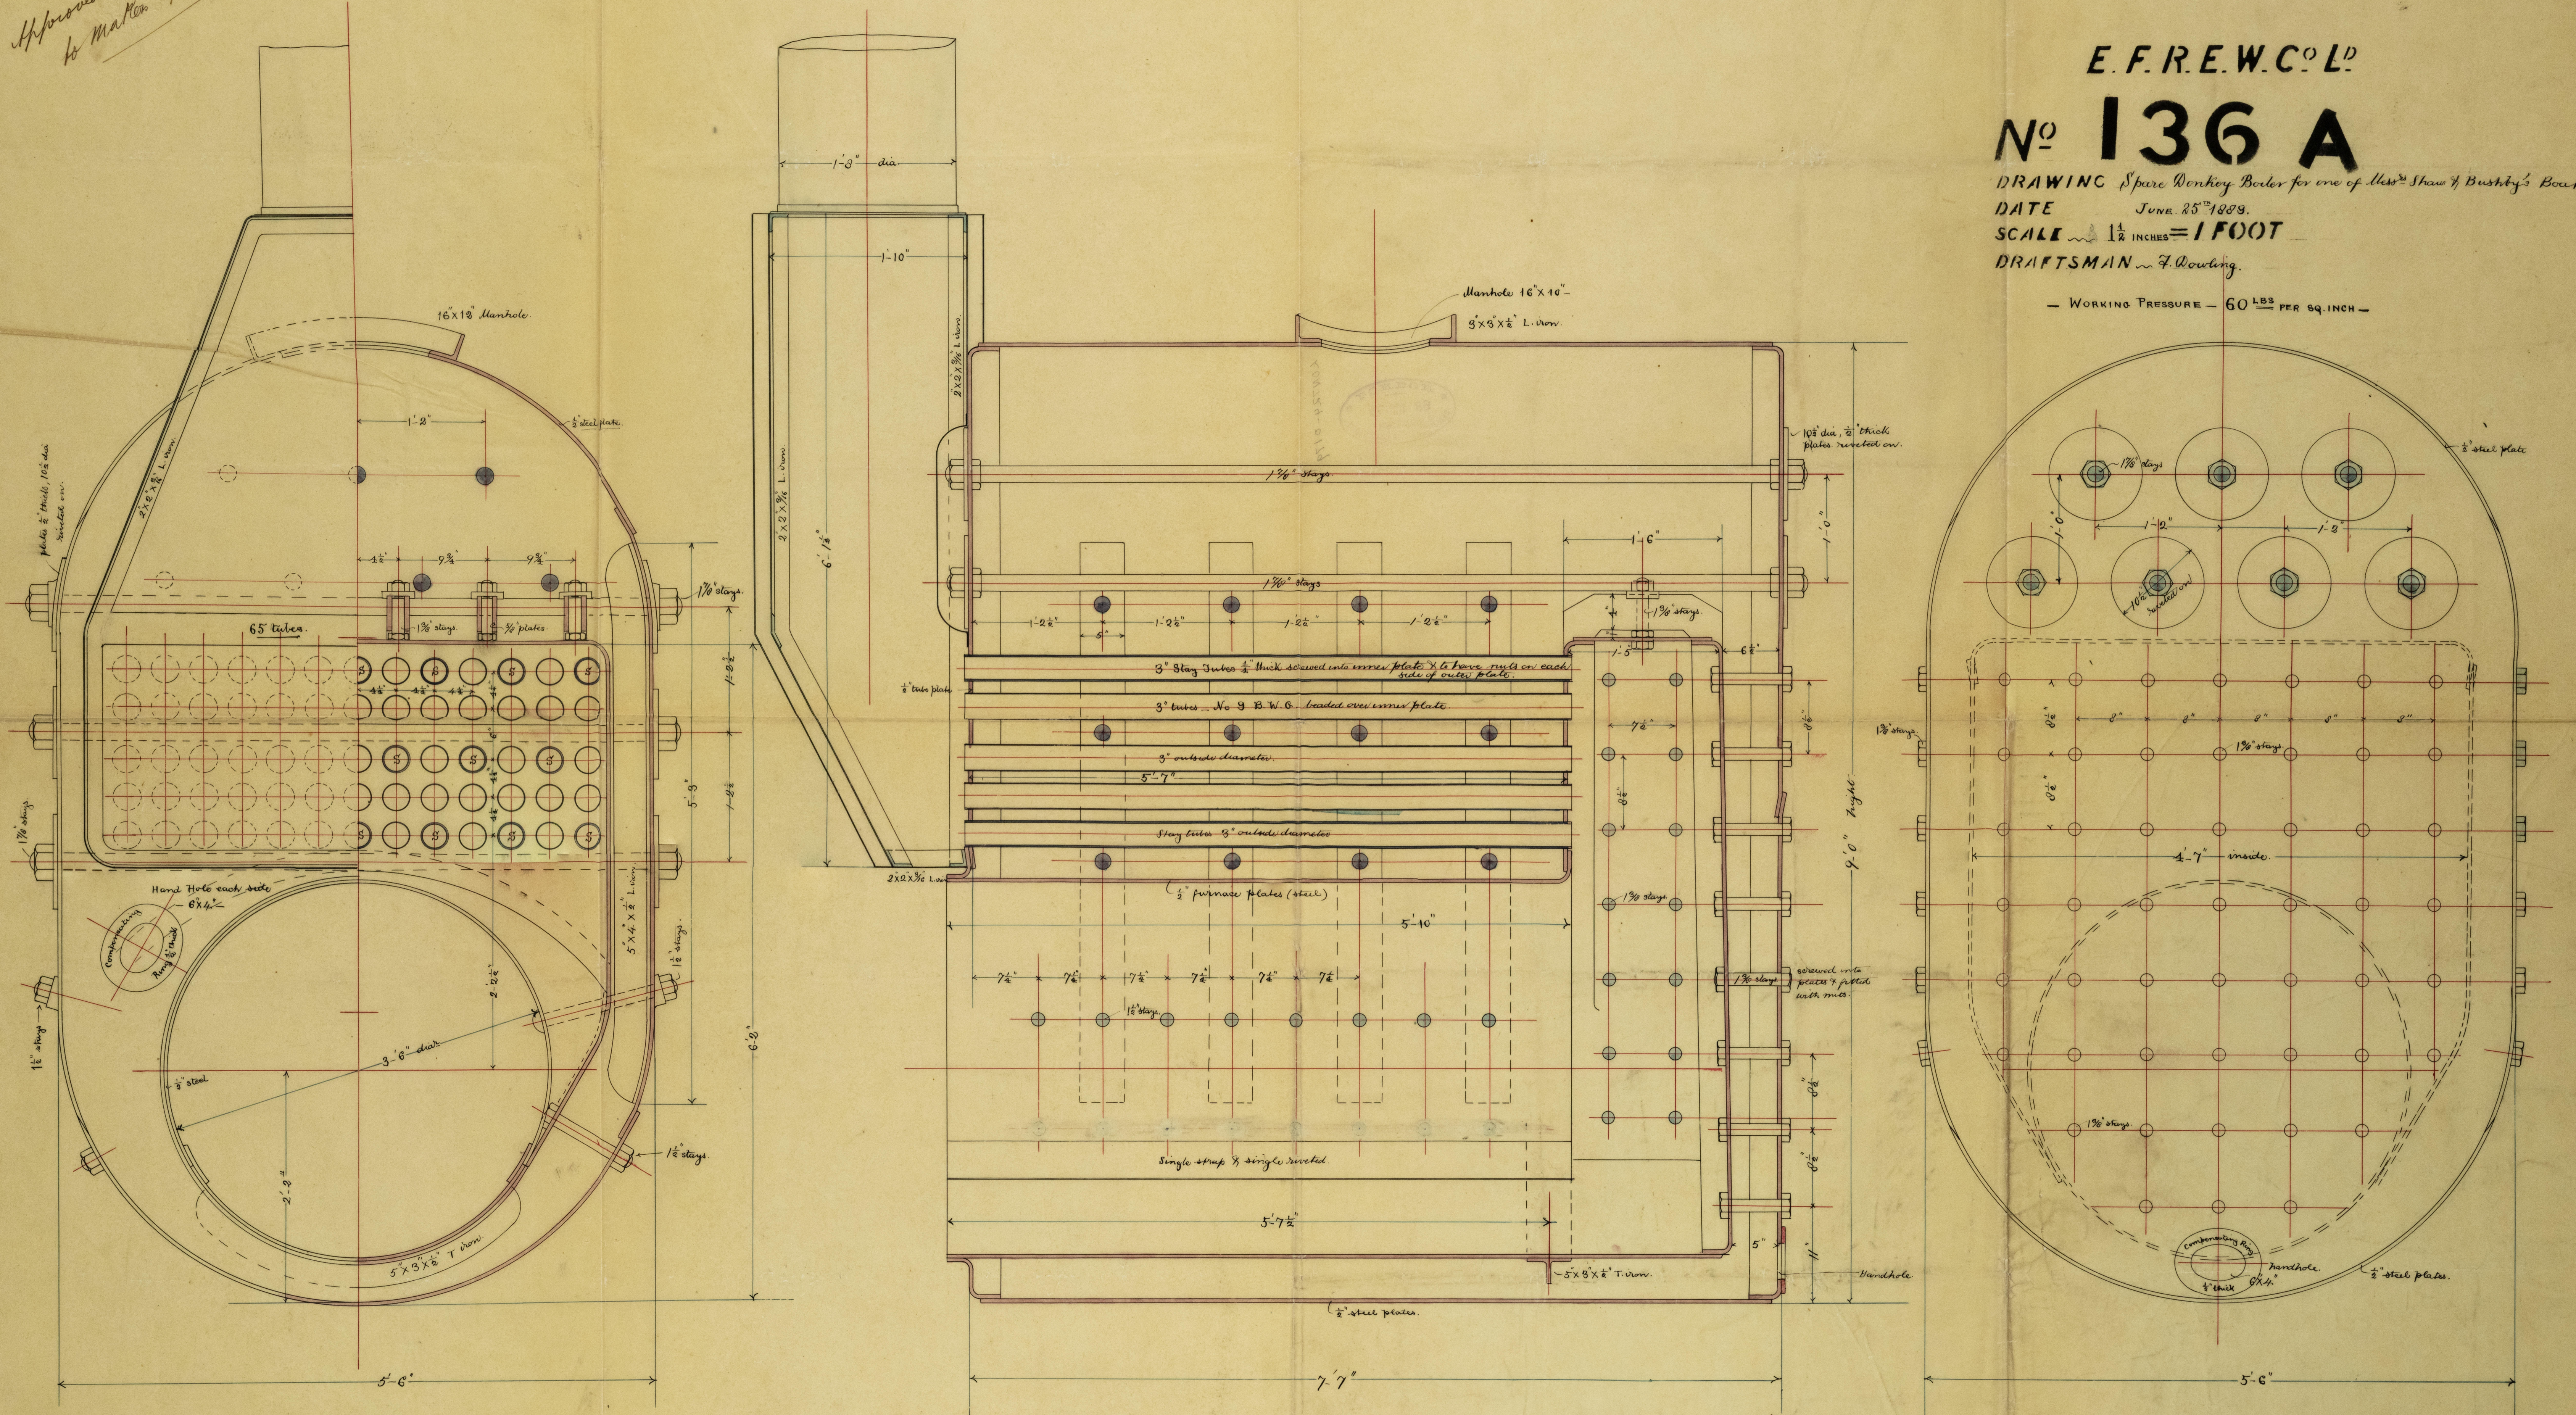

Harter
50189

Longitudinal Seams 3/4" holes, 2 1/2" pitch, double Riveted — Circumferential Seams 3/4" holes single Riveted. All plates of steel 1/2" thick —

Md.
5.7.89

Good system it would be well to use ref reduced pressure and 2

