
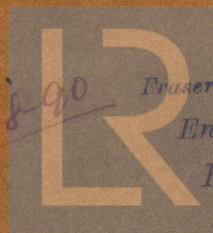


# Alterations to Boiler Capstan Drum

Scale  $\frac{1}{2}'' = 1'-0''$

Apr 14. 8. 90

120 lb

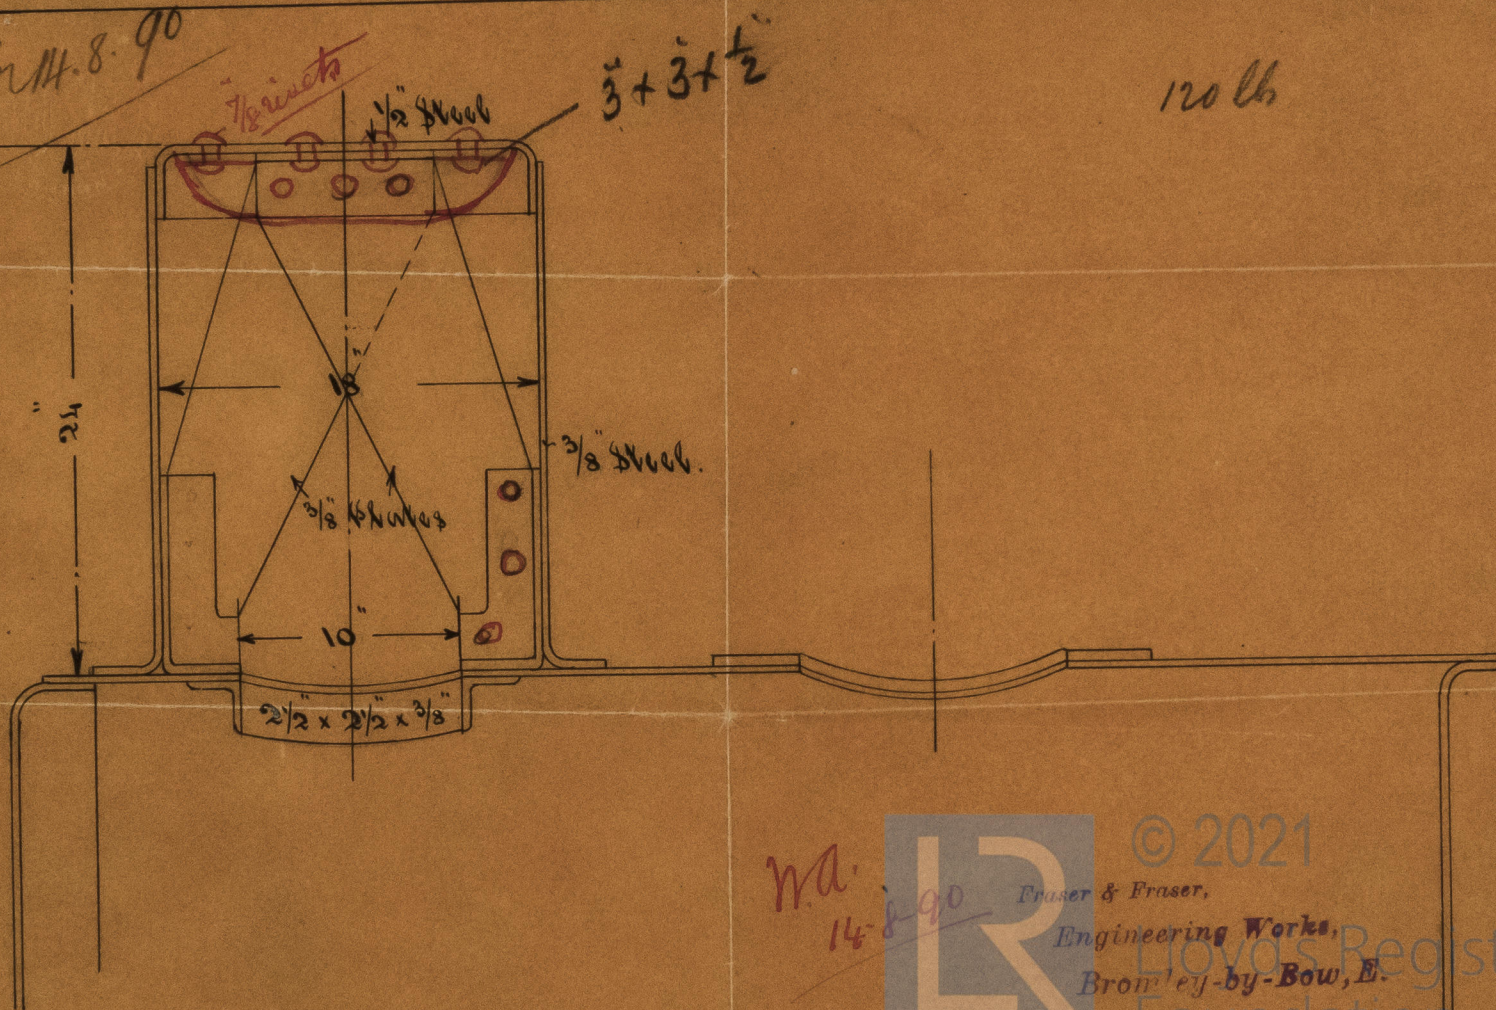

© 2021

Fraser & Fraser,

Engineering Works,

Bromley-by-Bow, E.

Lloyd's Register  
Foundation

LON 715-0001