

S.S. ATLANTIS.

SKETCH SHEWING NEW AND
REFITTED PLATES FOR

Scale $\frac{1}{4}$ " = 1 foot.

STARBOARD BOW.

New Plates &c in Decks.



Main Deck. 1 new pl't + 2 new str. bars
on Port side.

Fele Deck. New pl't across bow.

1 new pl't on port side.

New str. + Waterway bars both sides.

PORT BOW.

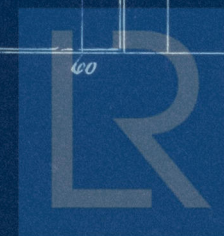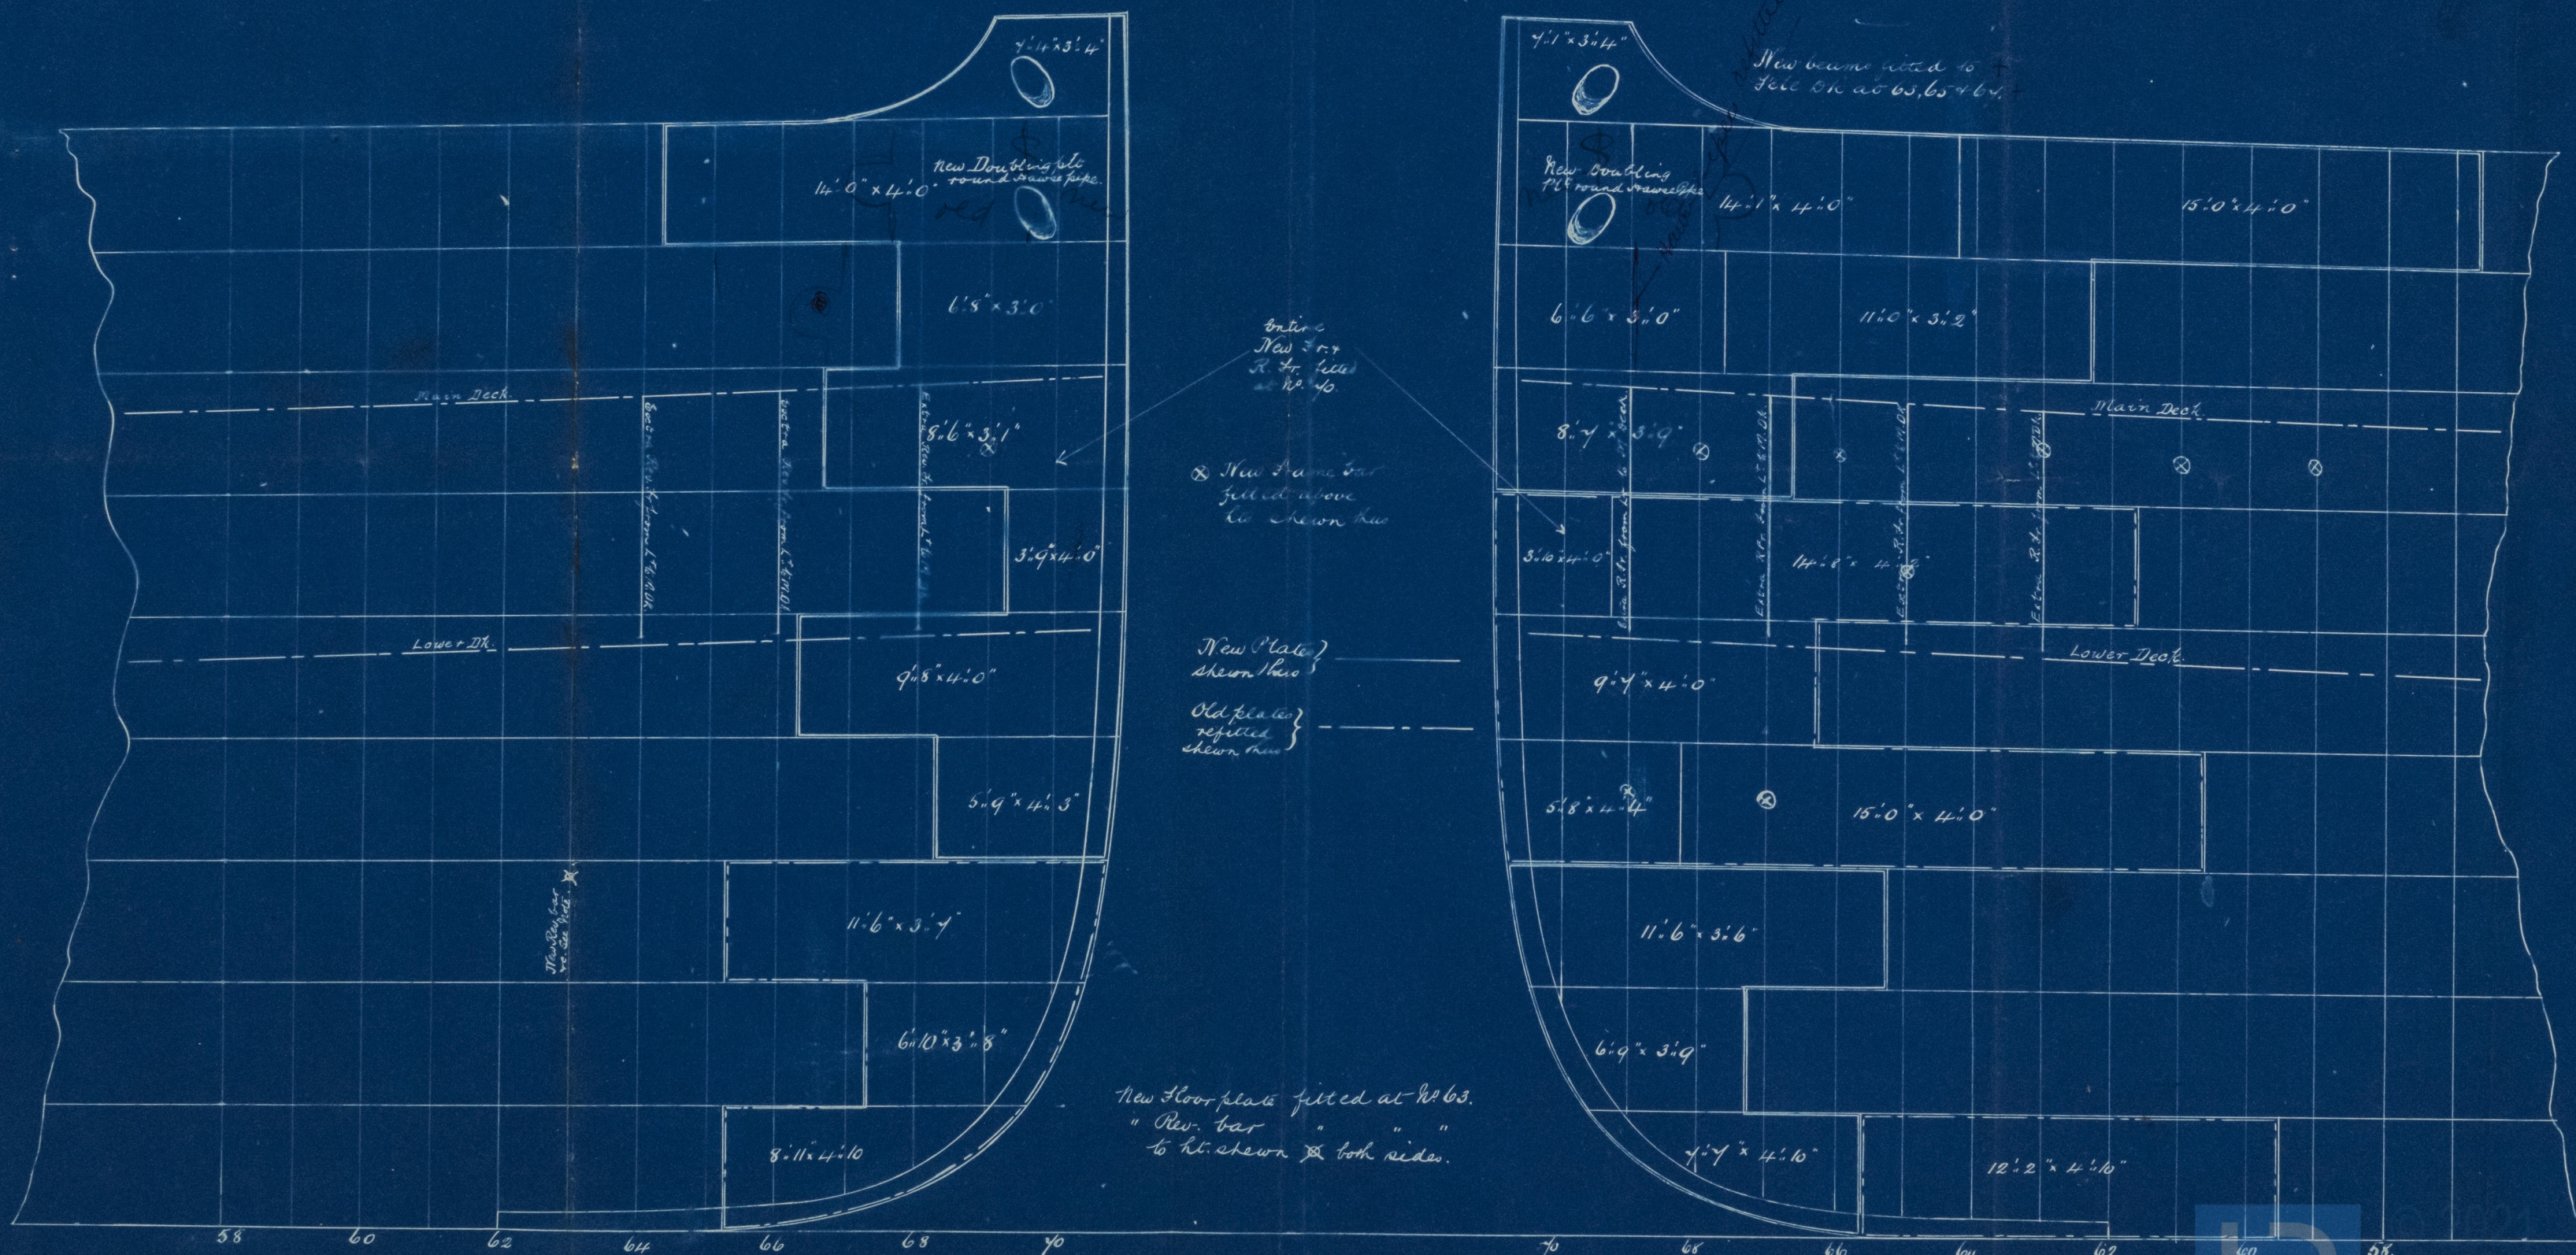

Lloyd's Register
Foundation